



		FED. ROAD DIV. NO.	STATE	FED. AID PROJ. NO.		
			VT			
BILL OF MATERIAL						
NO.	MARK	DESCRIPTION	LENGTH	REMARKS	ITEM	QTY
ONE	G6A	GIRDER				24,600
1	o	PL 39 x 1/2	32 2 1/2	(1)		
1	b	PL 39 x 1/2	69 8 1/2	(1)		
1	c	PL 18 x 1	68	4		
1	d	PL 18 x 1	33 7 1/2			
1	f	PL 18 x 1 1/2	20 11 1/2	(1)		
1	g	PL 18 x 2	60	0 (1)		
1	h	PL 18 x 1 1/2	20 11 1/2	(1)		
4	x1a	PL 8 1/2 x 1/2	3	3		
1	x1bh	PL 39 x 1/2	1	0 1/2	BENT	
1	x1bt	PL 39 x 1/2	1	1 1/2	BENT	
1	x1ab	BAR 8 x 1/2	3	3		
1	x1ac	BAR 8 x 1/2	3	3		
1	x1ad	BAR 8 x 1/2	3	3		
1	x1af	BAR 8 x 1/2	3	3		
1	x1ak	BAR 8 x 1/2	3	3		
1	x1am <sup>R</sup>	BAR 3 1/2 x 1/4	1	0 1/2		

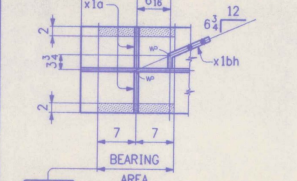



SECT. - Y

GIRDER ~ MK. G6A

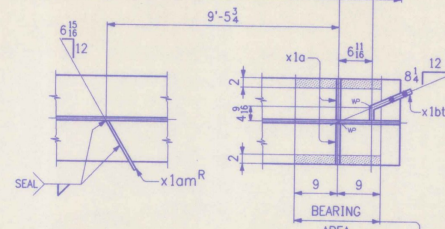

PAINT LIGHT RUST PREVENTIVE COAT OF PRIMER (FS), EDGES & SHADED AREA (NS)

PAINT LIGHT RUST PREVENTIVE COAT OF PRIMER (FS), EDGES & SHADED AREA (NS)

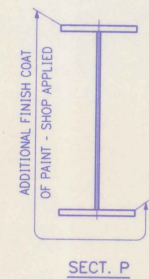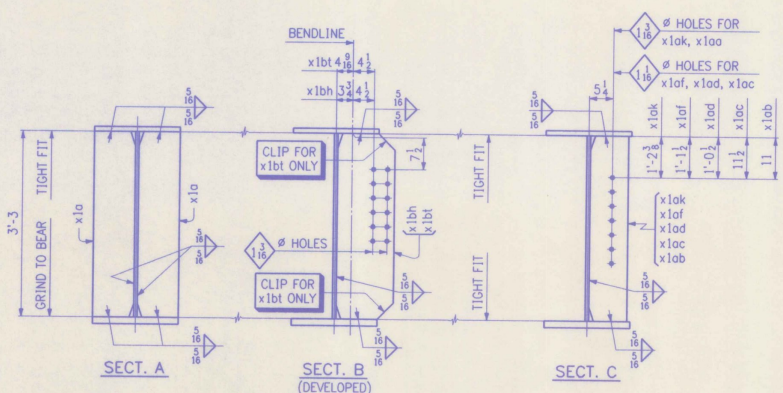

SHOP NOTE  
HOLES: 1/8" Ø (UN)  
BOLTS: NONE  
PAINT: AS NOTED, SEE DWG. N1  
FOR GENERAL SHOP NOTES, SEE DWG. N1  
FOR WEB CAMBER DIAGRAM, SEE DWG. WC1

SHOP DRAWING REVIEW  
REVIEW IS FOR GENERAL COMPLIANCE WITH CONTRACT & DOES NOT CONSTITUTE AN ENDORSEMENT OR GUARANTEE OF THE ACCURACY OR COMPLETENESS OF THE DRAWING.  
Barnes and Jarrill, Inc.  
80 Delaware Street  
Springfield, Massachusetts 01106  
DATE: 2-1-96 BY: JAB

NO.	REVISION	DATE

HIGH STEEL STRUCTURES, INC. 1770 Hempstead Road  
 Lancaster, PA 17602-0008  
 Phone 717/299-5211  
 A Division of Hsp Industries, Inc.

**GIRDER G6A**  
 U.S. ROUTE 7 OVER RAILROAD  
 BRIDGE NO. 80  
 TOWN OF WALLINGFORD, COUNTY OF RUTLAND  
 STATE OF VERMONT  
 AGENCY OF TRANSPORTATION  
 PROJECT NO. BRS-0137(13)

CONTRACTOR: J. A. McDONALD, INC.  
 IN CHARGE: **abs** MADE **PPP** 2:15 CHK'D **FM** DATE: 2-21-96  
 CONTRACT NUMBER: **VT-95368** BY:  DRAWING NUMBER: **9 OF 9**