


PRODUCT CODE	QTY	LENGTH	RISE
75367C	1	30'-10 1/2"	1 3/4"
75369C	1	28'-10 1/2"	1 1/2"
75371G	3	20'-1 1/2"	3/4"
75362G	2	27'-0 13/16"	1 1/4"
75361G	2	27'-4 13/16"	1 3/8"
75372G	14	29'-11"	1 5/8"

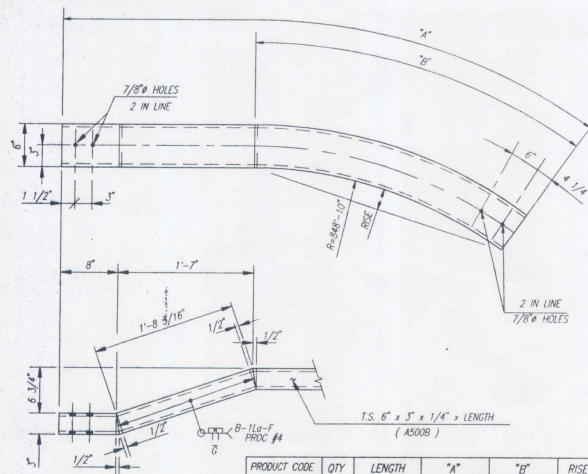

PRODUCT CODE	QTY	LENGTH	"A"	"B"	RISE
75366A	1	31'-0 11/16"	30'-10 1/2"	28'-7 1/2"	1 1/2"
75368A	1	29'-0 11/16"	28'-10 1/2"	26'-7 1/2"	1 1/4"
75370A	3	20'-3 11/16"	20'-1 1/2"	17'-10 1/2"	5/8"

BILL OF MATERIAL

PRODUCT CODE	QTY	DESCRIPTION	WT	REMARKS
75360C	24	TS 6 x 3 x 1/4 x 29'-11"	441#	
75363C	2	TS 6 x 3 x 1/4 x 21'-8"	319#	
75365G	1	TS 6 x 3 x 1/4 x 20'-9 1/2"	308#	
75374G	2	TS 6 x 3 x 1/4 x 4'-7 5/16"	67#	
75367C	1	TS 6 x 3 x 1/4 x 30'-10 1/2"	455#	CURVED
75369C	1	TS 6 x 3 x 1/4 x 28'-10 1/2"	425#	CURVED
75371G	3	TS 6 x 3 x 1/4 x 20'-1 1/2"	297#	CURVED
75362C	2	TS 6 x 3 x 1/4 x 27'-0 13/16"	398#	CURVED
75361G	2	TS 6 x 3 x 1/4 x 27'-4 13/16"	402#	CURVED
75372G	14	TS 6 x 3 x 1/4 x 29'-11"	441#	CURVED
75366A	1	TS 6 x 3 x 1/4 x 31'-0 11/16"	457#	CURVED
75368A	1	TS 6 x 3 x 1/4 x 29'-0 11/16"	427#	CURVED
75370A	3	TS 6 x 3 x 1/4 x 20'-3 11/16"	299#	CURVED
75364A	1	TS 6 x 3 x 1/4 x 20'-11 11/16"	308#	
75373A	2	TS 6 x 3 x 1/4 x 4'-9 1/2"	70#	

NOTES:

1. ALL BOLTS TO BE CHARPY V NOTCH TESTED
2. INSPECTED BY CONWELL
3. FINISH: GALV A123
4. ALL POST MATERIAL, INCLUDING BASE PLATE, SHALL MEET MINIMUM CHARPY V-NOTCH TOUGHNESS REQUIREMENTS.
5. ALL WELDING SHALL CONFORM WITH VERMONT STANDARD SPECIFICATIONS SECTION 506.10.

ERECTION DETAILS ARE ON SHEETS E1 & E2 OF 2 (101571)

ISSU

APR 18 1996

ISSU

APPROVAL DRAWING

REV	OWN	BY	DATE	REMARKS

STATE OF VERMONT
AGENCY OF TRANSPORTATION
BOX BEAM BRIDGE RAILING
TOWN OF WALLINGFORD, COUNTY OF RUTLAND
U.S. ROUTE 7, BRIDGE No 79 & No 80
PROJECT: BBS 0137 (13)

CUSTOMER: F.R. LAFAVETTE INC. P.O. No. DATE: 4-10-96
DRAWN: B. TAKACH
CHECKED: T.P.
APPROVED: [Signature]
DATE: 4-10-96
ENG. FILE #: 10157102
SHEET NO: 2 OF 2
DRAWING NO: (22)-101571



This drawing and the information shown thereon is the sole property of TRINITY INDUSTRIES, INC. Neither the drawing nor such information is to be used for any purpose other than that for which it was specifically furnished by TRINITY INDUSTRIES, INC., nor is any reproduction authorized without written permission.

