


INT. CROSSFRAMES

MARK	(A)	(B)	(C)	(D)	(E)	(F)	(G)	(H)
CF4	6'-8	4 1/8	3/8	12	11 3/8	10 1/8	11 3/8	3'-6 3/8
CF5	6'-7 1/8	3 3/8	1/2	12	11 1/8	10 1/4	11 3/8	3'-5 1/8
CF6	6'-7 1/8	2 3/4	7/16	11 1/8	12	10 1/8	11 3/8	3'-5 1/8
CF7	6'-7 1/8	2 1/8	5/16	11 3/4	12	10 9/16	11 1/8	3'-5 1/8
CF8	6'-7 1/8	1 1/2	1/4	11 1/8	12	10 3/4	11 1/8	3'-4 1/2
CF9	6'-7 1/8	3/8	1/16	11 1/4	12	11 1/8	11 1/8	3'-4 1/8

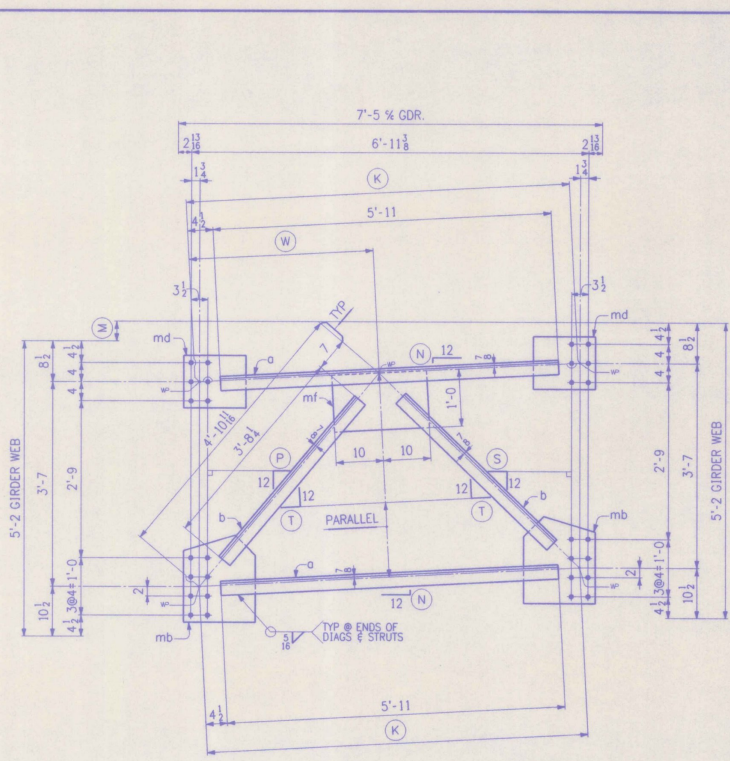

INT. CROSSFRAMES

MARK	(K)	(M)	(N)	(P)	(S)	(T)	(W)
CF10	6'-7 1/8	1/4	1/16	11 1/8	11 1/8	11 1/8	3'-3 1/8
CF11	6'-7 1/8	3/4	1/8	10 15/16	11 1/8	11 1/8	3'-3 9/16
CF12	6'-7 1/8	1 1/2	1/4	10 1/2	11 1/8	11 1/8	3'-3 3/8
CF13	6'-7 1/8	2	5/16	10 5/8	11 1/4	11 1/8	3'-2 7/8
CF14	6'-7 1/8	2 1/2	1/16	10 1/8	11 1/8	11 1/8	3'-2 1/2

SHOP NOTE
HOLES: 1/8" Ø
BOLTS: NONE
PAINT: NONE
FOR GENERAL SHOP NOTES, SEE DWG. N1.

SHOP DRAWING REVIEW
REVIEWED FOR GENERAL COMPLIANCE WITH CONTRACT DOCUMENTS AND SPECIFICATIONS. CONTRACTOR RESPONSIBLE FOR CORRECTNESS OF DIMENSIONS AND DETAILS.
Barrett and Davis, Inc.
160 Boston Street
Boston, Massachusetts 02118
DATE: 3.23.95 BY: J.A.M.

BILL OF MATERIAL					
NO.	MARK	DESCRIPTION	LENGTH	REMARKS	ITEM
5	CF4	CROSSFRAMES			253
5	CF5	CROSSFRAMES			253
5	CF6	CROSSFRAMES			253
5	CF7	CROSSFRAMES			253
5	CF8	CROSSFRAMES			253
5	CF9	CROSSFRAMES			253
5	CF10	CROSSFRAMES			253
5	CF11	CROSSFRAMES			253
5	CF12	CROSSFRAMES			253
5	CF13	CROSSFRAMES			253
5	CF14	CROSSFRAMES			253
110	a	∠3 x 3 x 1/2	5	11	4
110	b	∠3 x 3 x 3/8	3	8 1/2	4
110	md	PL 11 x 1/2	1	1	4
110	mb	PL 15 x 3/8	1	6 1/2	4
55	mf	PL 12 x 3/8	1	8	3

NO.	REVISION	DATE

HIGH STEEL STRUCTURES, INC. 1770 Hempstead Road, Lancaster, PA 17603-0008, Phone 717/299-5211
A Division of High Industries, Inc.

CROSSFRAMES (INT)
U.S. ROUTE 7 OVER OTTER CREEK
BRIDGE NO. 79
TOWN OF WALLINGFORD, COUNTY OF RUTLAND
STATE OF VERMONT
AGENCY OF TRANSPORTATION

STATE CONTRACT NO. PROJECT NO. BRS-0137(13)
CONTRACTOR: J. A. McDONALD, INC.
BY: abs DATE: 3.23.95
IN CHARGE: abs MAKE PPF 1:22 CHK'D BY: DATE: 1-28-95
CONTRACT NUMBER: VT-95367 DRAWING NUMBER: 4 OF 24