
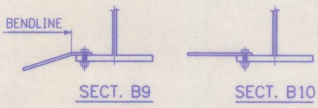
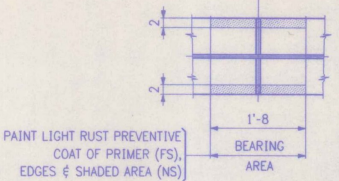
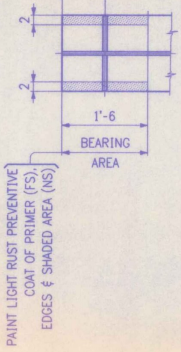
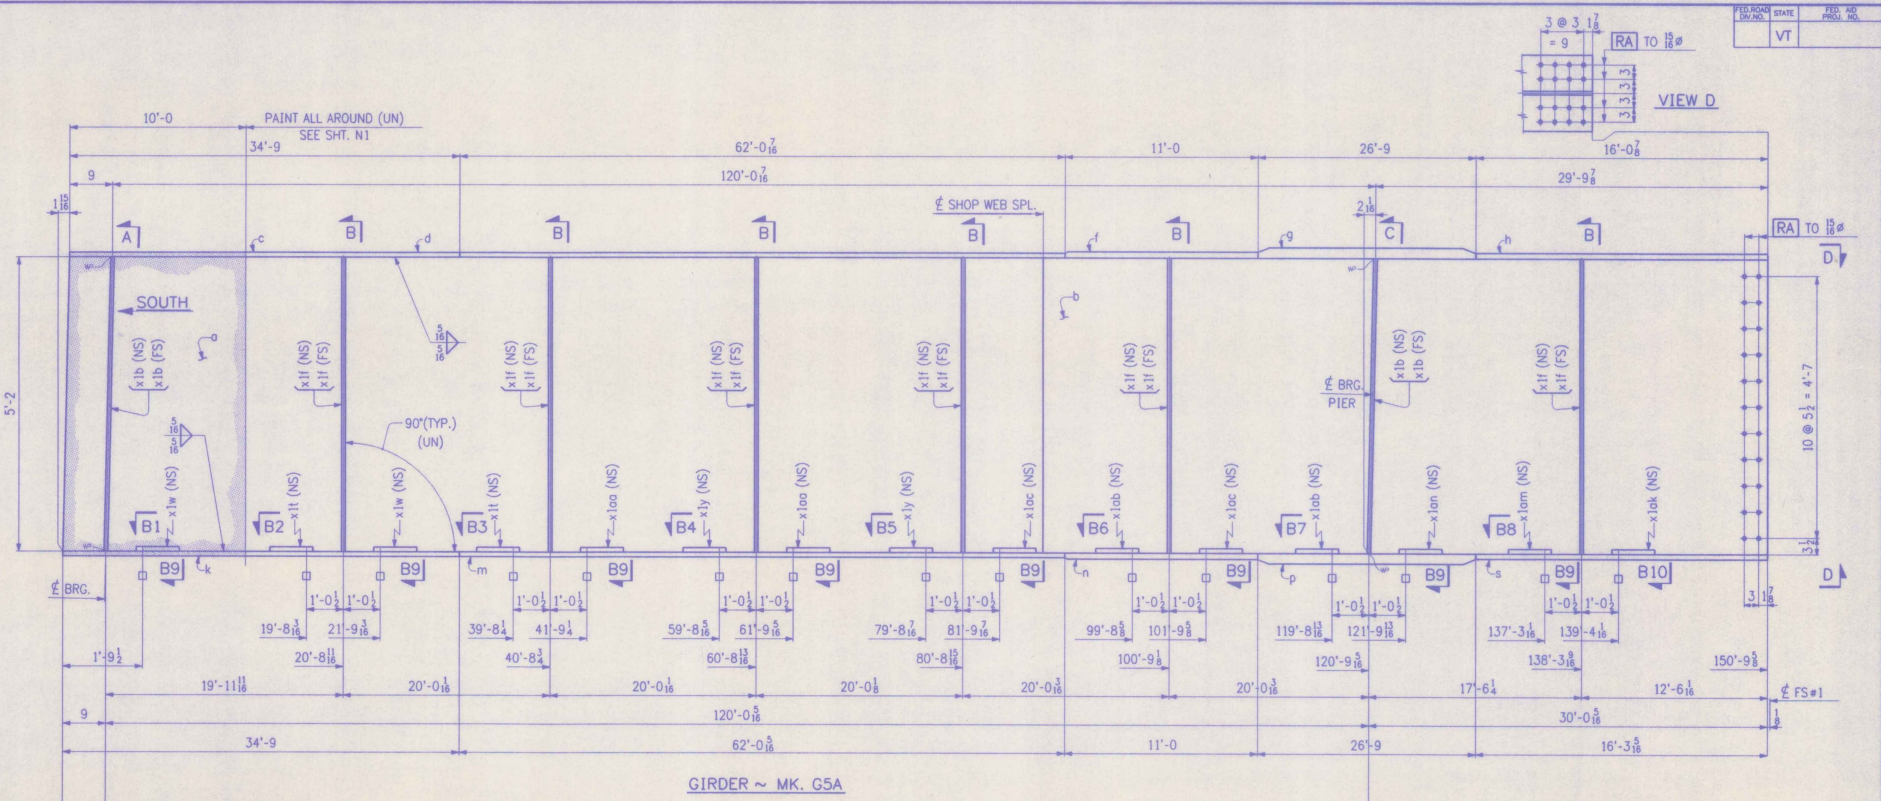


FED. ROAD DIST. NO.	STATE	FED. PROJ. NO.	AD. NO.
	VT		

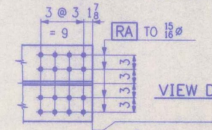

**SHOP DRAWING REVIEW**  
 REVIEW IS FOR GENERAL COMPLIANCE WITH CONTRACT DOCUMENTS. CONTRACTOR IS RESPONSIBLE FOR ACCURACY OF DIMENSIONS AND DETAILS.  
 APPROVED FOR CONTRACTOR: [Signature]  
 APPROVED FOR ARCHITECT: [Signature]  
 APPROVED FOR ENGINEER: [Signature]  
 Barnes and Jarvis, Inc.  
 80 Revere Street  
 Burlington, Massachusetts 02119  
 DATE: 10/11/95 BY: LTKC

NO.	REVISION	DATE

**HIGH STEEL STRUCTURES, INC.** 1770 Hempstead Road  
 Lancaster, PA 17605-0008  
 Phone: 717-299-5211  
 A Division of High Industries, Inc.

**GIRDER G5A**  
 U.S. ROUTE 7 OVER OTTER CREEK  
 BRIDGE NO. 79  
 TOWN OF WALLINGFORD, COUNTY OF RUTLAND  
 STATE OF VERMONT  
 AGENCY OF TRANSPORTATION  
 PROJECT NO. BRS-0137(13)

STATE CONTRACT OR REF. NO. J. A. McDONALD, INC.  
 CONTRACTOR  
 IN CHARGE: abs  
 CONTRACT NO. VT-95367  
 DATE: 2-2-96  
 DRAWING NO. 11 OF 24

WORK THIS DWG. WITH DWG. 12