


GIRDER ~ MK. G3B

PAINT LIGHT RUST PREVENTIVE
COAT OF PRIMER (FS),
EDGES & SHADED AREA (NS)

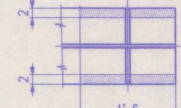

SHOP NOTE
HOLES: 1/8" (UN)
BOLTS: AS NOTED
PAINT: AS NOTED, SEE DWG. N1
FOR GENERAL SHOP NOTES, SEE DWG. N1.
FOR WEB CAMBER DIAGRAM, SEE DWG. WC1.

FED. ROAD DIST. NO.	STATE	FED. AID PROJ. NO.
	VT	

BILL OF MATERIAL						
NO.	MARK	DESCRIPTION	LENGTH	REMARKS	ITEM	QTY
ONE	G3B	GIRDER				29000
1	o	PL 62 x 3/8	65	6 3/8 (T)		2
1	b	PL 62 x 3/8	42	11 1/8 (T)		2
1	c	PL 16 x 1 1/2	72	11 1/8 (T)		2
1	d	PL 16 x 1 1/2	35	6 (T)		2
1	f	PL 16 x 1 1/2	72	8 1/2 (T)		2
1	g	PL 16 x 1 1/2	35	6 (T)		2
2	x1k	PL 58 x 3/8	1	1 (T)		3
2	x1m	PL 16 x 1 1/2	2	1 (T)		3
4	x1n	BAR 7 x 3/4	2	1 (T)		3
2	x1b	BAR 7 1/2 x 3/4	5	2		3
10	x1f	BAR 7 1/2 x 3/4	5	2		3

SHOP DRAWING REVIEW
REVIEW FOR GENERAL COMPLIANCE WITH
CONTRACT DOCUMENTS. NO RESPONSIBILITY
IS ASSUMED FOR THE FITNESS OF
CONNECTIONS OR DETAILS.
DATE: 11/11/96
Barres and Jarvis, Inc.
1770 Hemstead Road
Lancaster, PA 17602-0008
Phone 717/299-5211
A Division of High Industries, Inc.

NO.	REVISION	DATE

HIGH STEEL STRUCTURES, INC. 1770 Hemstead Road
Lancaster, PA 17602-0008
Phone 717/299-5211
A Division of High Industries, Inc.

GIRDER G3B

U.S. ROUTE 7 OVER OTTER CREEK
BRIDGE NO. 79
TOWN OF WALLINGFORD, COUNTY OF RUTLAND
STATE OF VERMONT
AGENCY OF TRANSPORTATION

STATE CONTRACT PROJECT NO. BRS-0137(13)
CONTRACTOR: J. A. McDONALD, INC.
BY: [Signature] DATE: 2-3-96
IN CHARGE: cbs MAKE PPF 2-3 CHK LD
CONTRACT NO. VT-95367 DRAWING NUMBER: 19 OF 24