

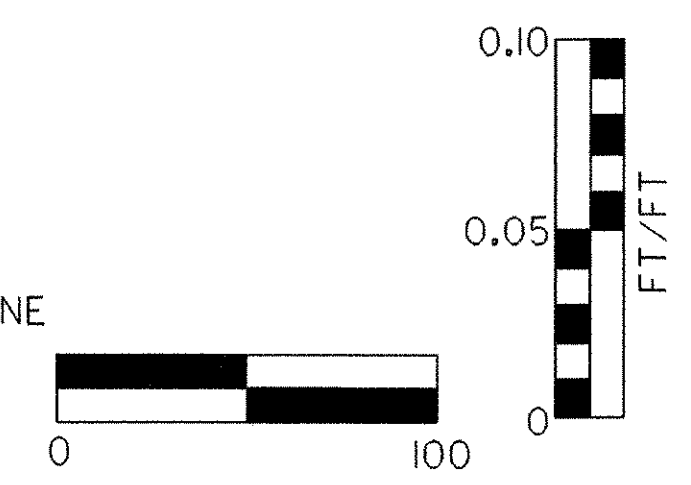



DETOUR BANKING DIAGRAM

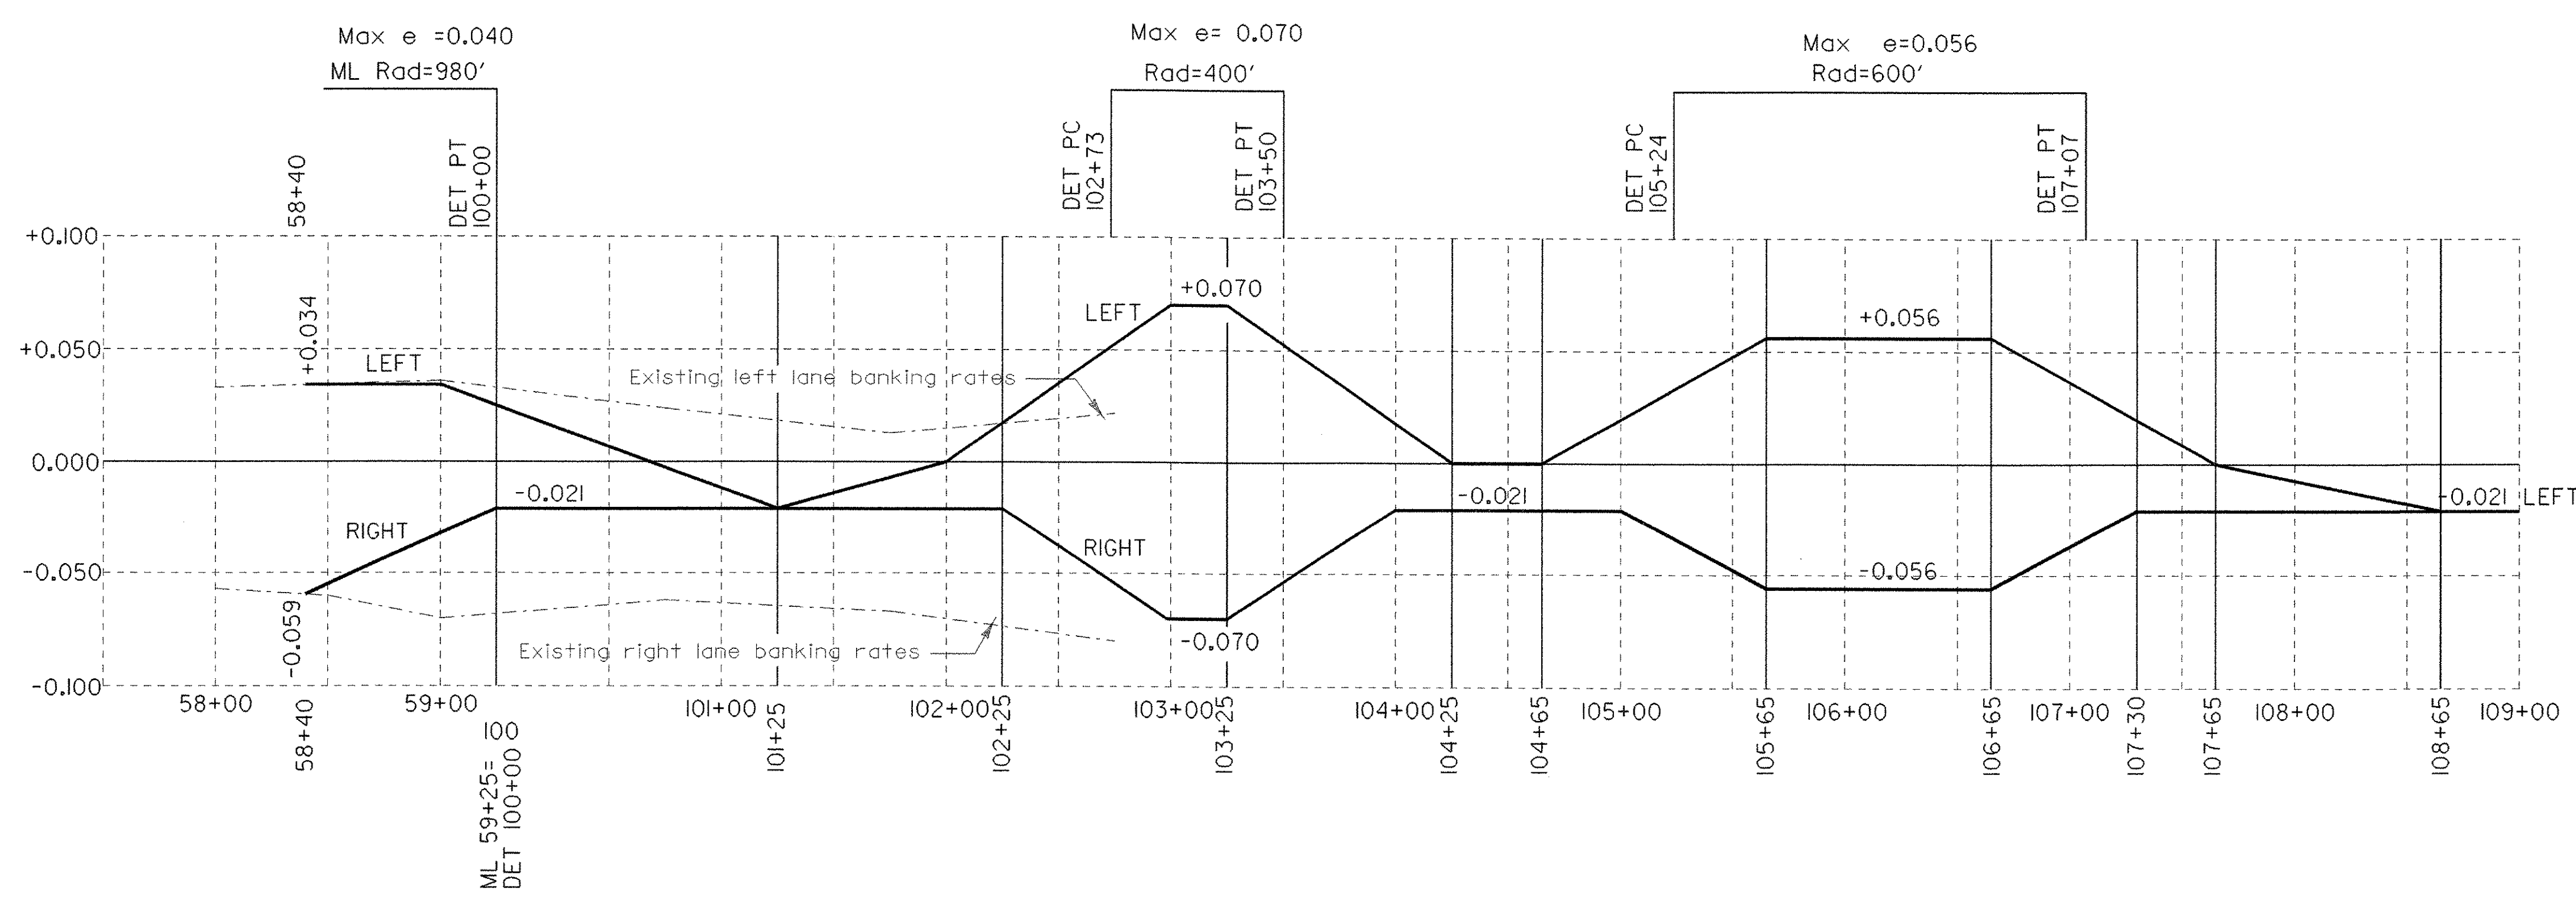

Note:
Detour Speed is to be 30 MPH.

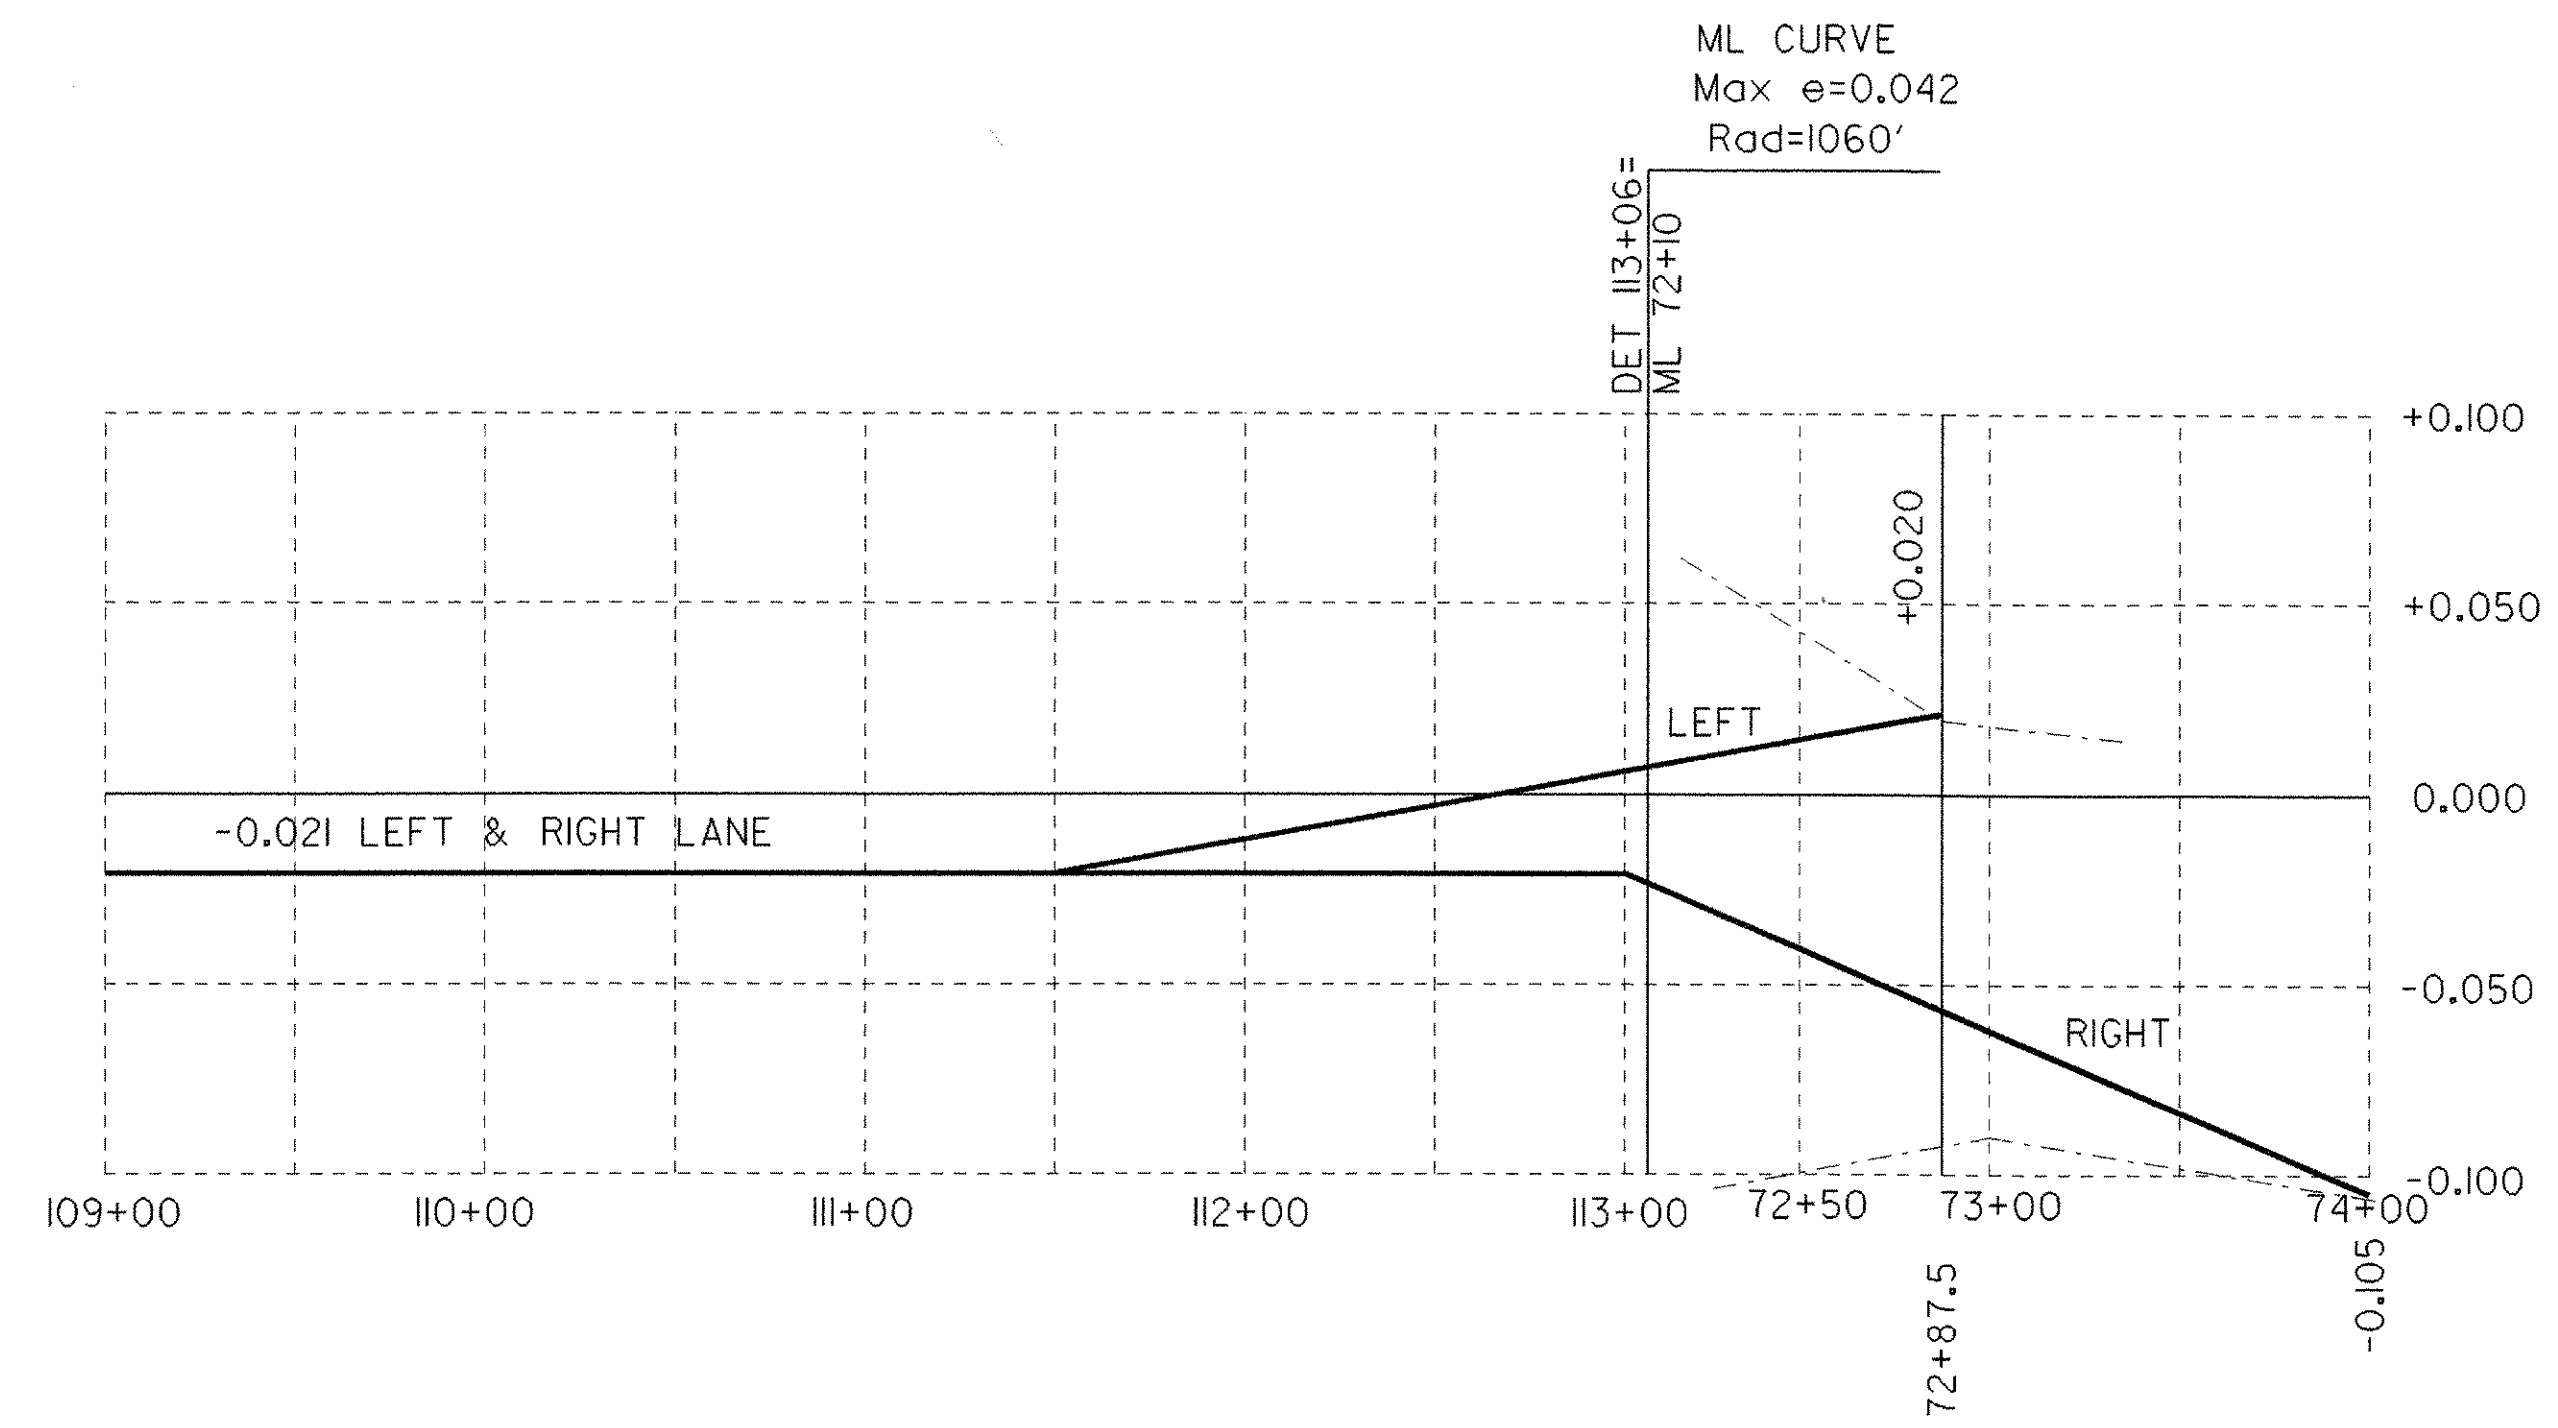

* ANY SLOPES GREATER THAN 1:2 SHALL BE BLANKETED WITH 24" OF TYPE II STONE FILL.

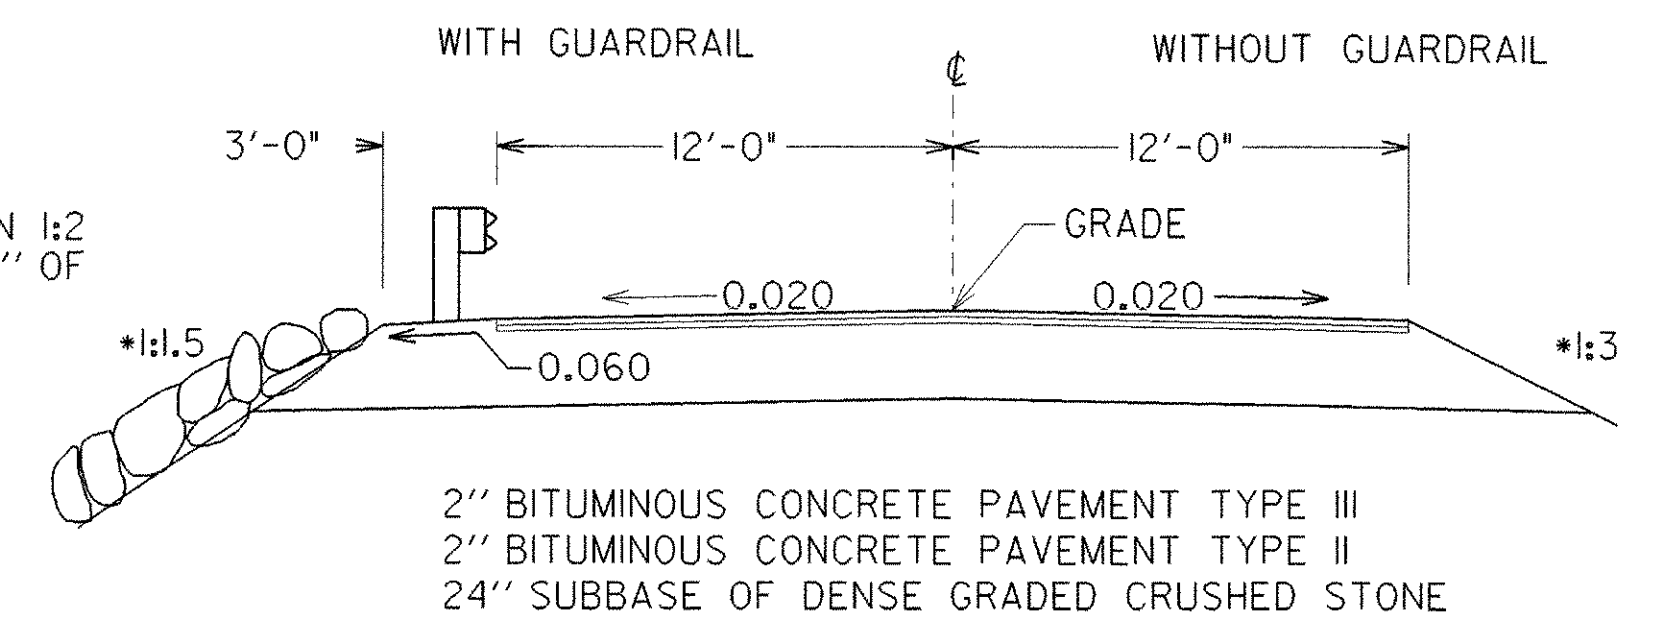

DETOUR TYPICAL SECTION
N.T.S

DETOUR BANKING AND TYPICAL SHEET

PROJECT NAME: WOODFORD	
PROJECT NUMBER: BHF 010-1(29)	
FILE NAME: /84e039/de039de+.dgn	PLOT DATE: 03-OCT-2005
PROJECT LEADER: PORTALUPI	DRAWN BY: J. GEORGE
DESIGNED BY: G. SHANGRAW	CHECKED BY: EVANS-MONGEON
DETOUR SHEET: de039de+.1	SHEET 5 OF 106