



58+50 ~ 63+75

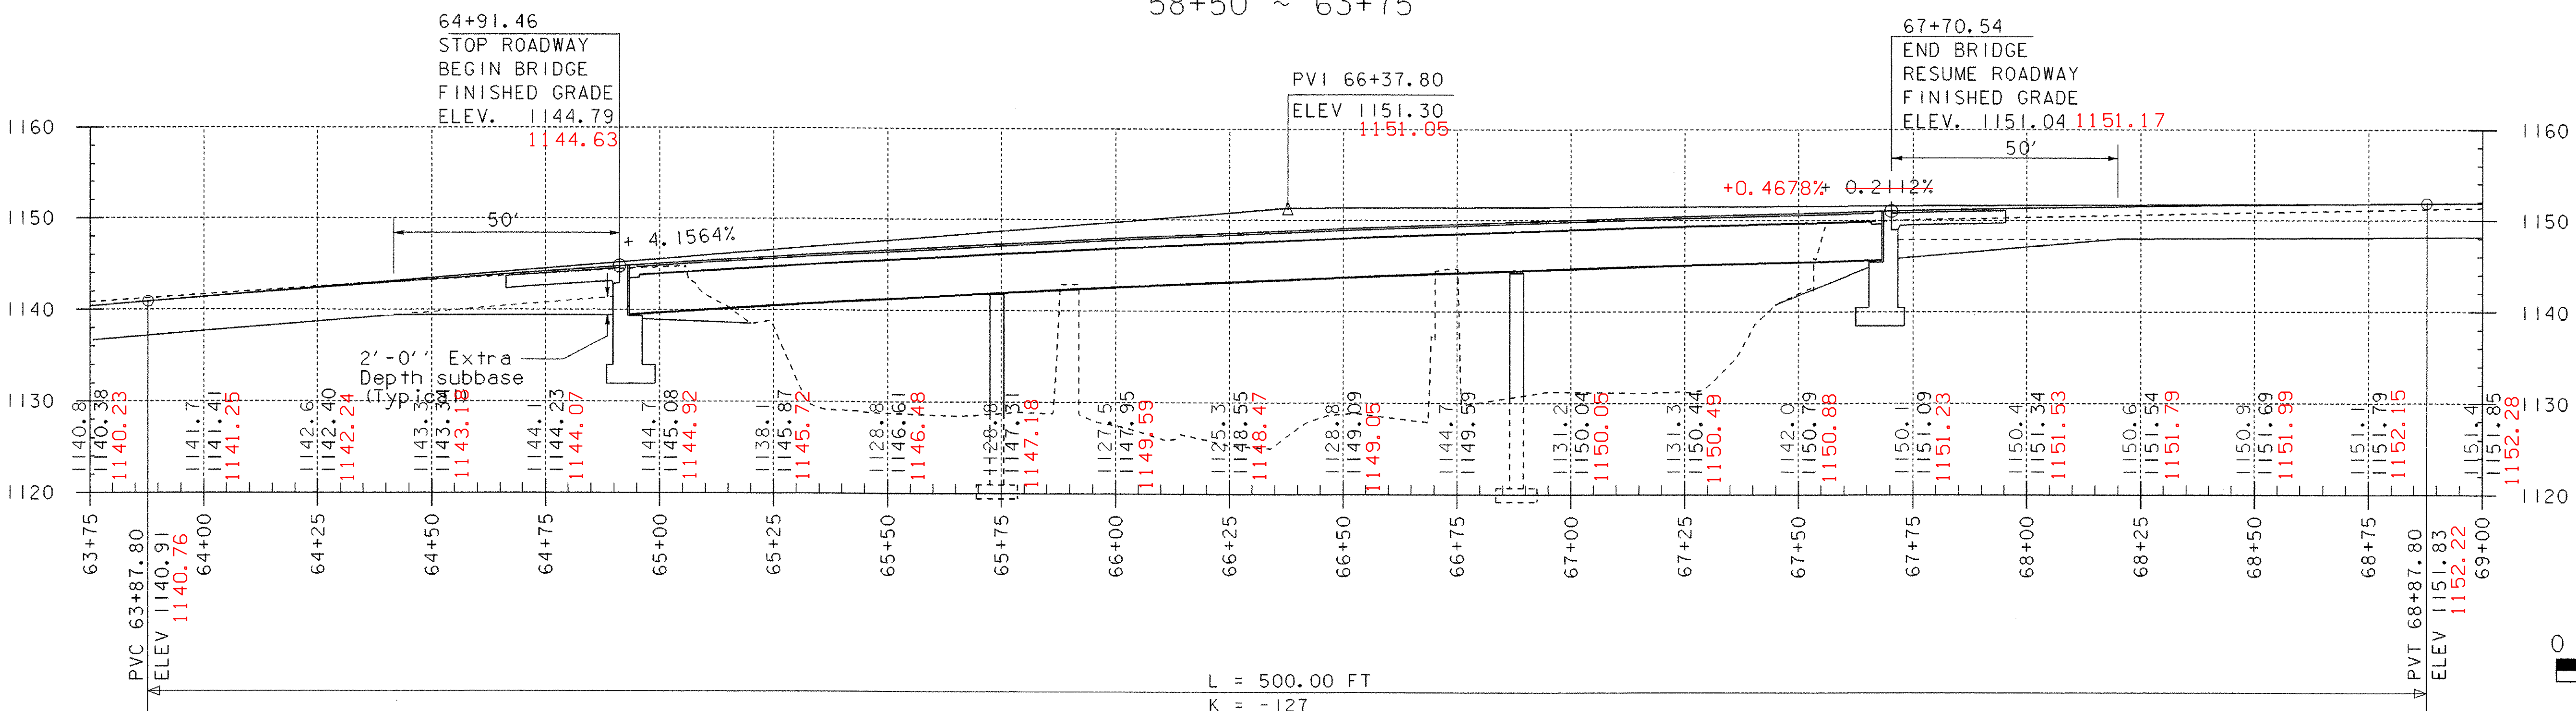

63+75 ~ 69+00

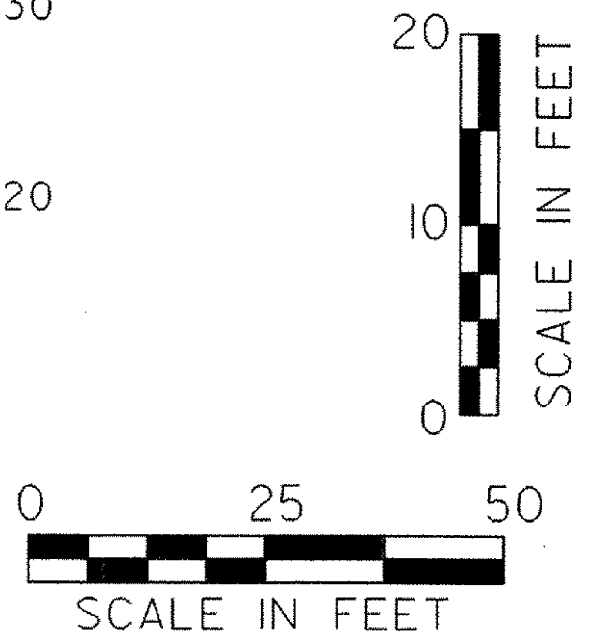

PROFILE #1 STATION 58+50 ~ 69+00

DATUM	
VERTICAL	NGVD 1929
HORIZONTAL	N/A

PROJECT: WOODFORD	PROJECT NO.: BHF 010-1(29)
DESIGN FILE NAME: /84e039/structures/de039bdr.dgn	PLOT DATE: 03-OCT-2005
IPARM FILE NAME: DE039PRI.I	SURVEY DATE: 12-88
SURVEYED BY: MOREAU	DRAWN BY: EVANS-MONGEON
SQUAD LEADER: PORTALUPI	SHEET: 15 OF 106