
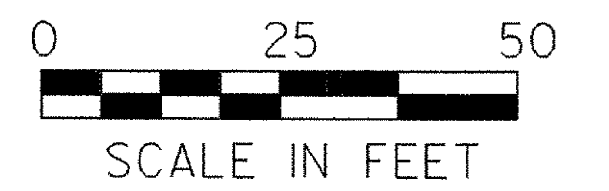


69+00 ~ 73+50

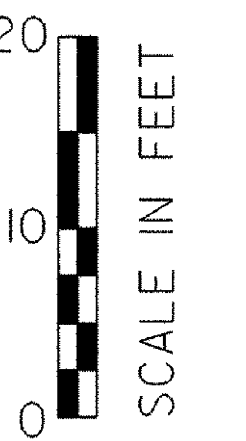

DATUM	
VERTICAL	NGVD 1929
HORIZONTAL	N/A

PROFILE #2 STATION 69+00 ~ 73+50

PROJECT: WOODFORD	PROJECT NO.: BHF 010-1(29)
DESIGN FILE NAME: /84e039/structures/de039bdr.dgn	PLOT DATE: 03-OCT-2005
IPARM FILE NAME: DE039PR2.1	SURVEY DATE: 12-88
SURVEYED BY: MOREAU	DRAWN BY: EVANS-MONGEON
SQUAD LEADER: PORTALUPI	SHEET: 16 OF 106