



- WETLANDS
- RIPARIAN BUFFER
- PDF - PROJECT DEMARCATION FENCE
- SILT FENCE
- DE-WATERING STRUCTURE (TYPICAL)
- JUTE EROSION MATTING

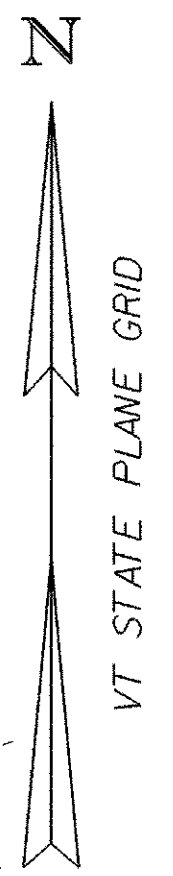

DATUM	
VERTICAL	NGVD 1929
HORIZONTAL	N/A

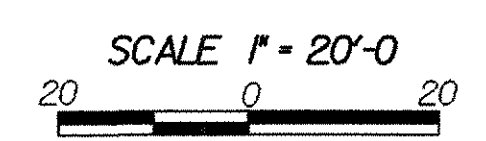

EROSION CONTROL SITE PLAN SHEET #2

PROJECT NAME:	WOODFORD	PLOT DATE:	03-OCT-2005
PROJECT NUMBER:	BHF 010-I(29)	DRAWN BY:	W FARLEY
FILE NAME:	84e039/structures/84e039erobdr.dgn	DESIGNED BY:	W FARLEY
PROJECT LEADER:	M EVANS-MONGEON	CHECKED BY:	
IPARM:	epsconstr2.i	SHEET	29 OF 106