



- WETLANDS
- PROJECT DEMARCATION FENCE
- SILT FENCE
- JUTE EROSION MATTING

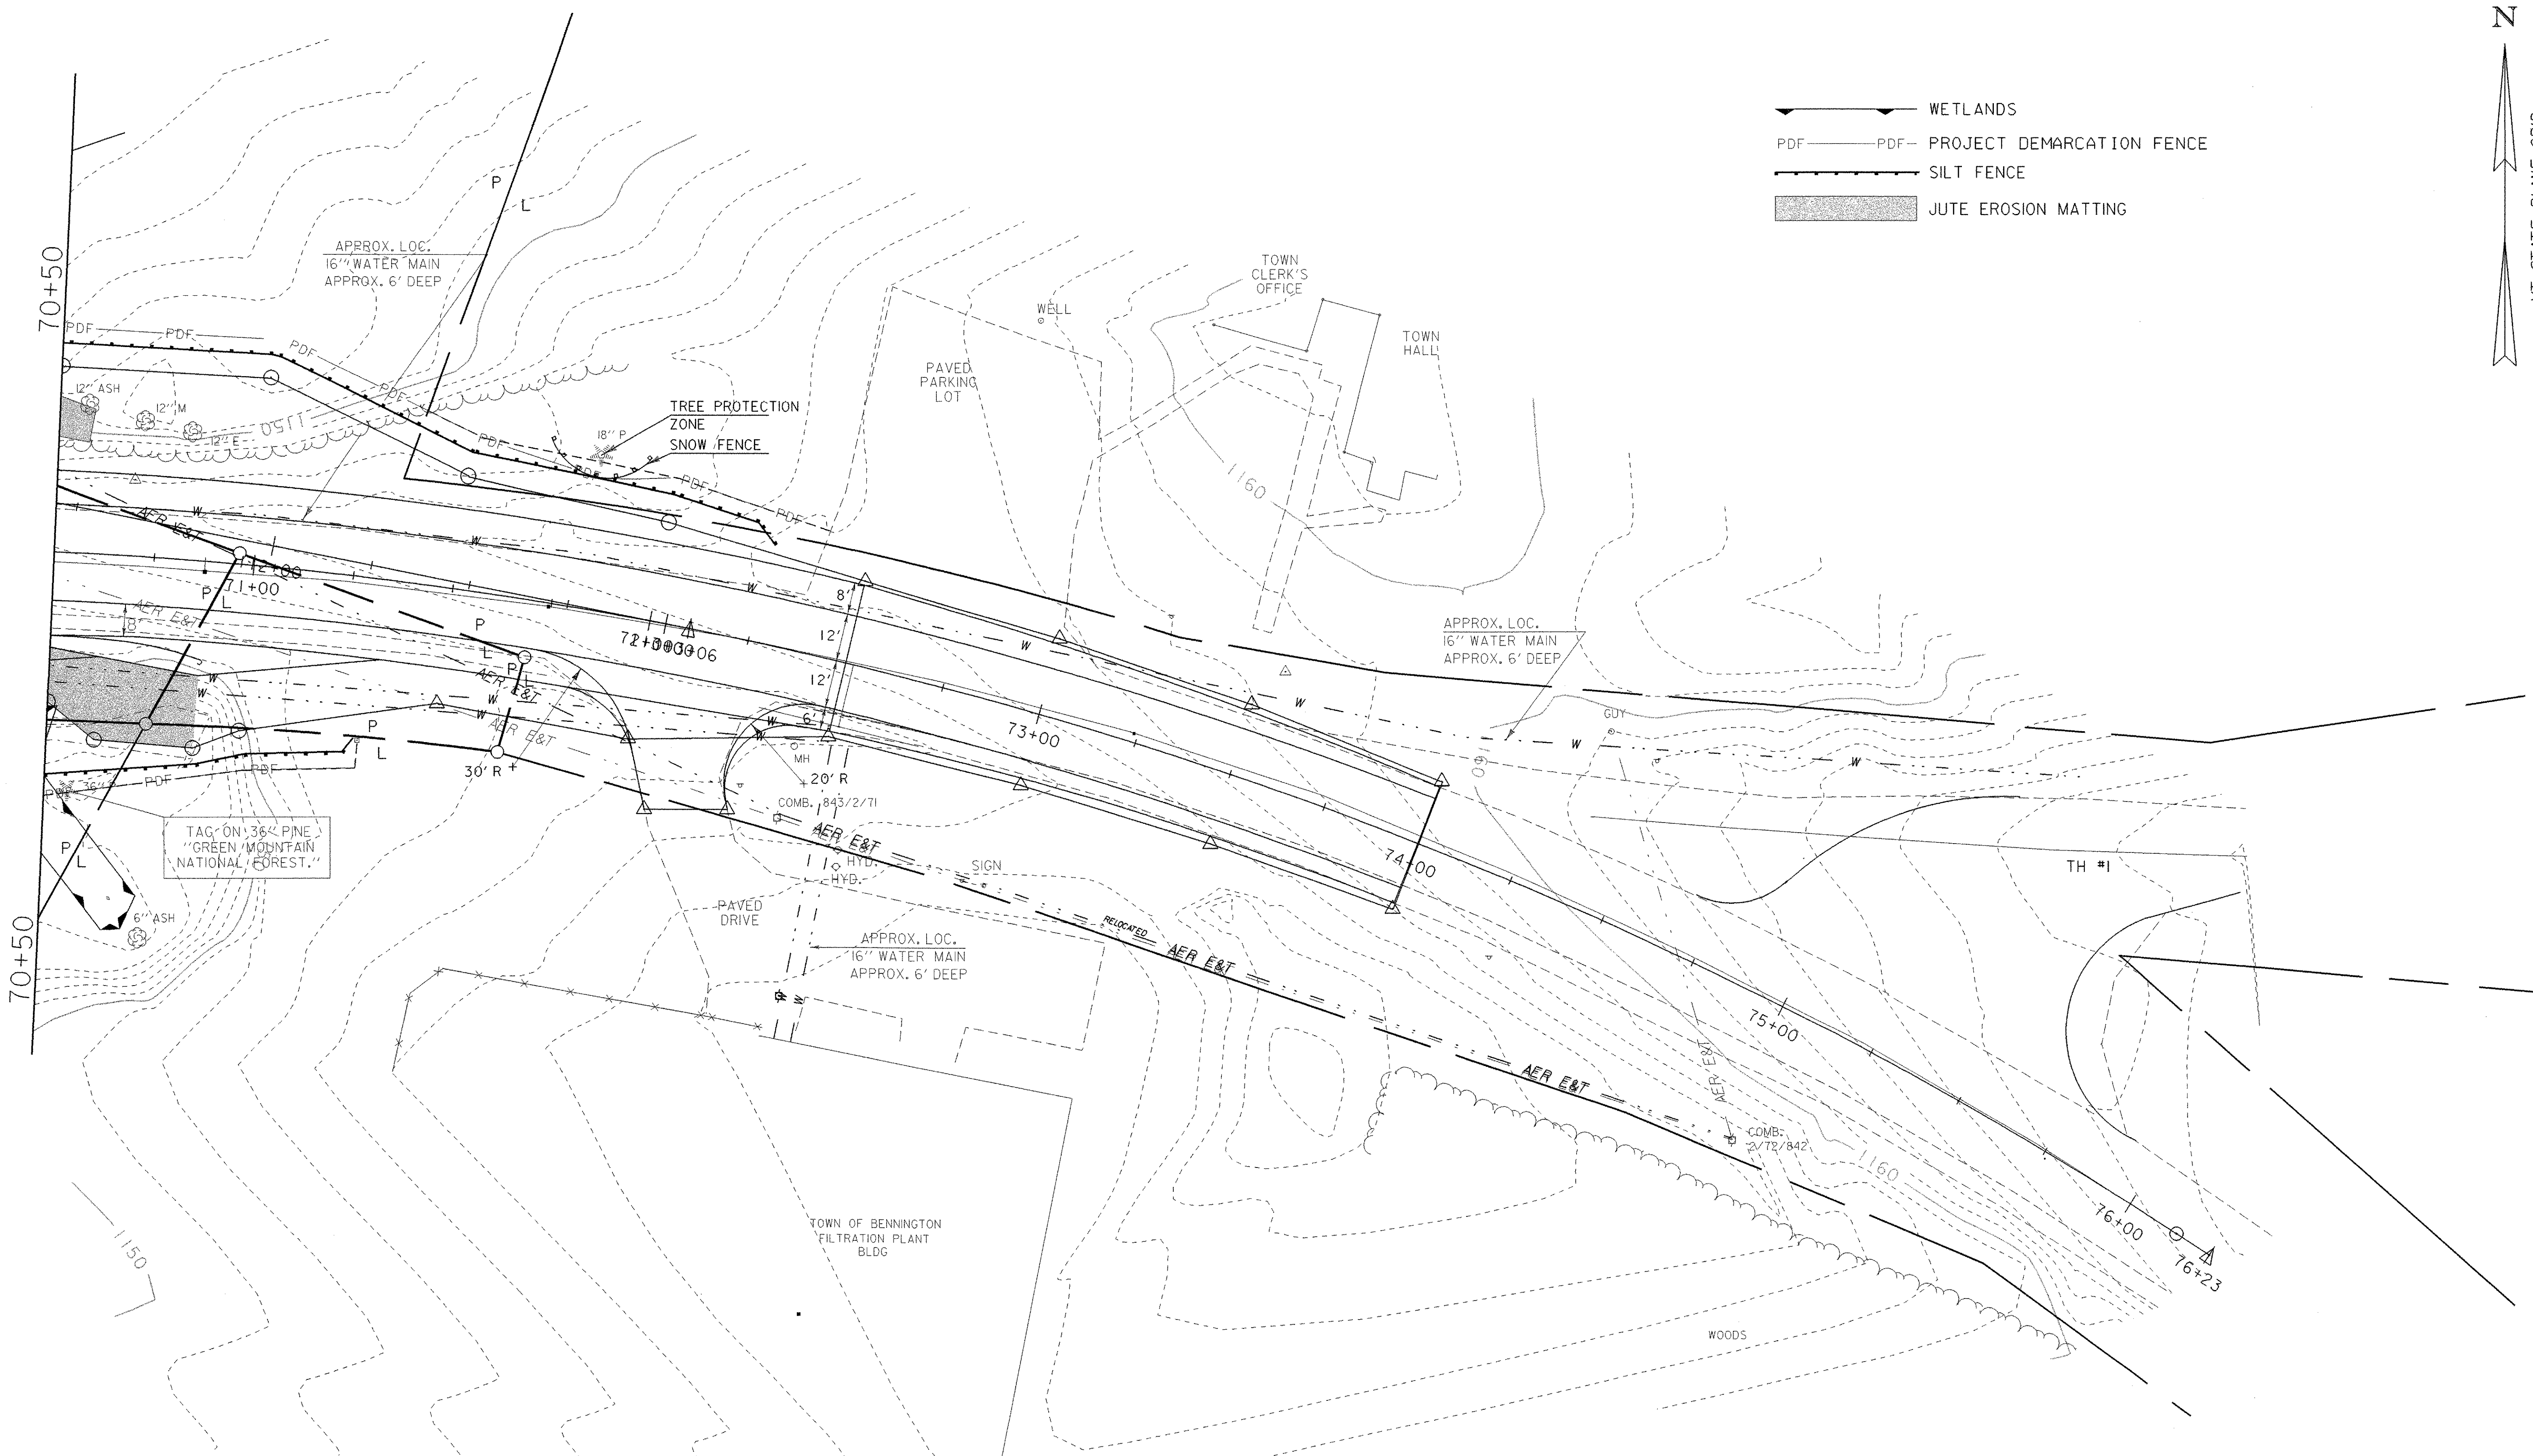

DATUM	
VERTICAL	NGVD 1929
HORIZONTAL	N/A

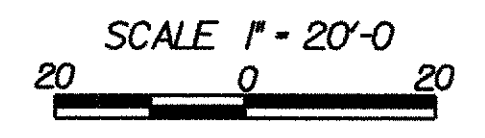

EROSION CONTROL SITE PLAN SHEET #3

PROJECT NAME:	WOODFORD
PROJECT NUMBER:	BHF 010-1(29)
FILE NAME:	84e039/structures/84e039erobdr.dgn
PROJECT LEADER:	M EVANS-MONGEON
DESIGNED BY:	W FARLEY
IPARM:	epsconstr3.i
PLOT DATE:	03-OCT-2005
DRAWN BY:	W FARLEY
CHECKED BY:	
SHEET	30 OF 106