




ABUTMENT NO. 1 PLAN

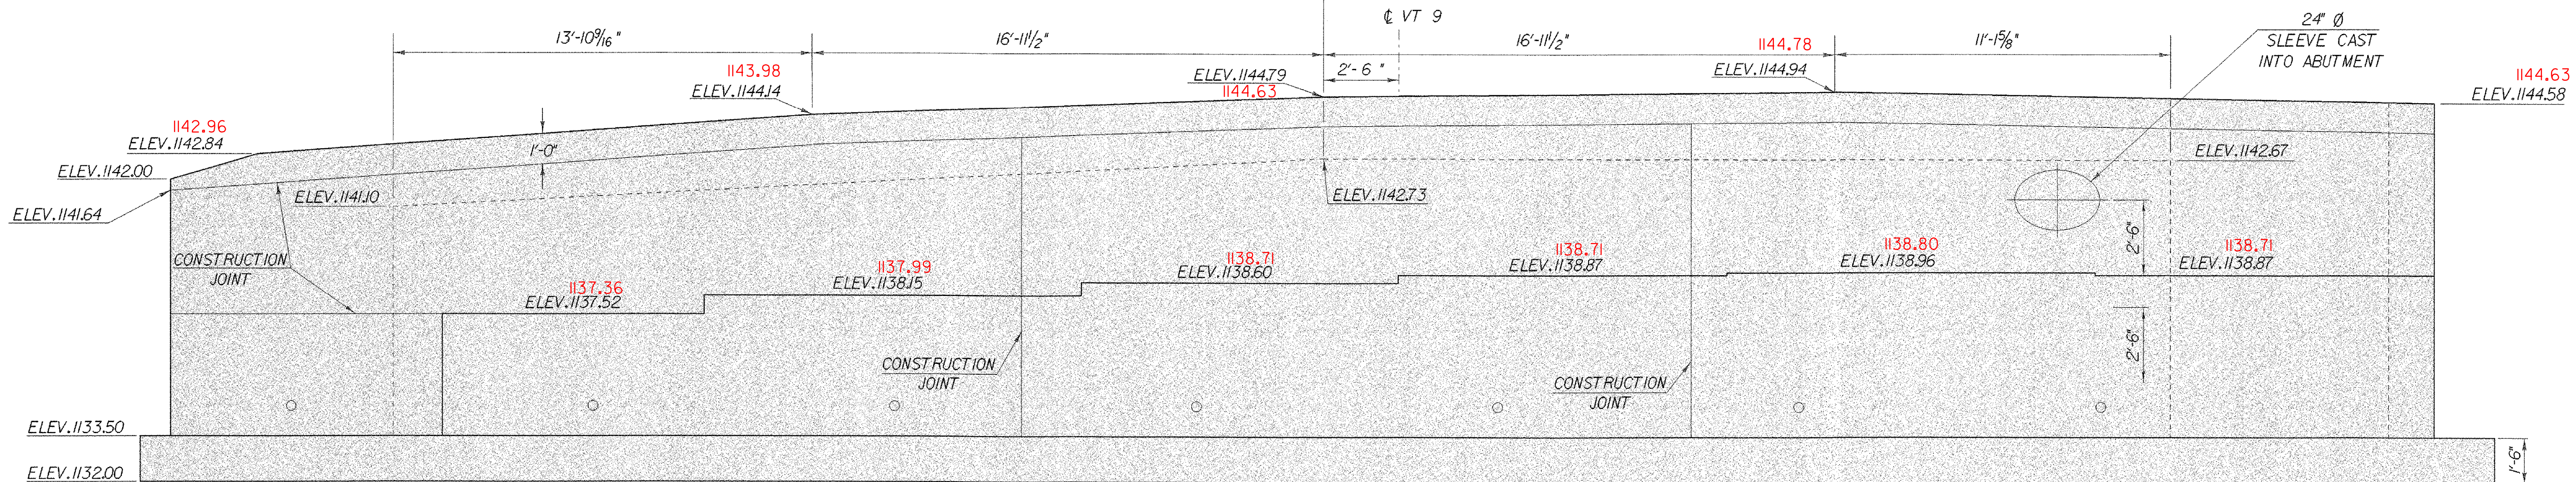

ABUTMENT NO. 1 ELEVATION

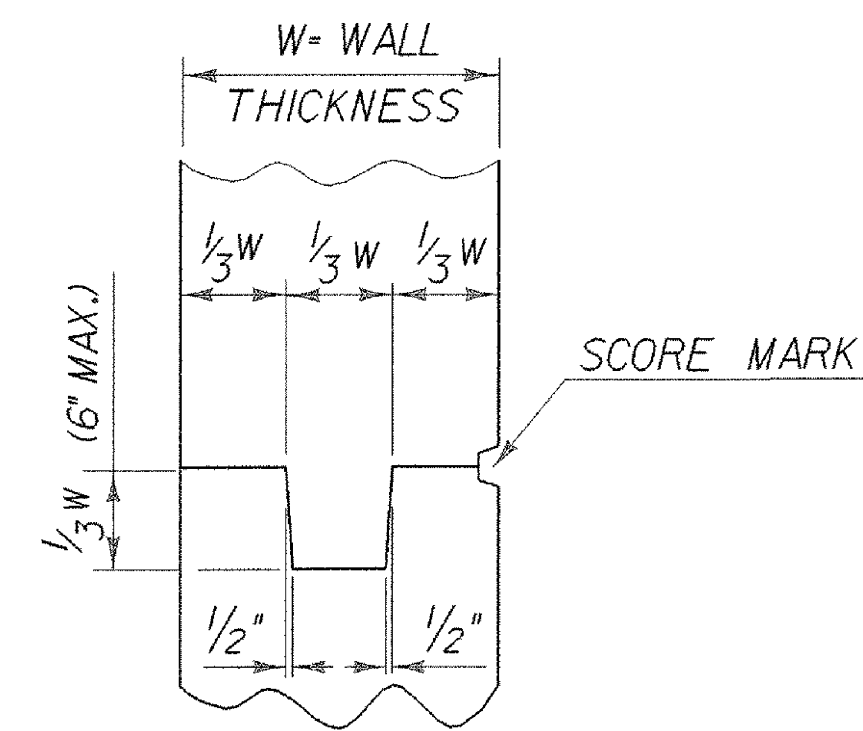

TYPICAL CONCRETE CONSTRUCTION JOINT

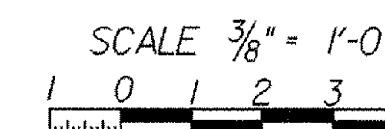

<b>STATE OF VERMONT AGENCY OF TRANSPORTATION</b>			
Town Of	WOODFORD	Bridge No.	BR 11
Highway No.	VT 9	Log Sta.	
		Surv. Sta.	
<b>VT 9 OVER ROARING BRANCH OF WALLOOMSAC ABUTMENT * I PLAN AND ELEVATION</b>			
Designed By	M. EVANS-MONGEON	Drawn By	R. PELLETT
Checked By	M. EVANS-MONGEON	Date	
		Bridge Design Supervisor	A. PORTALUPI
PROJECT	WOODFORD	PROJECT NO.	BHF 010-1(29)
I.G.C. Info. /346039/structures/se039sub.dgn		se039abl1	
Bridge Sheet No.		Sheet 69 of 106	