


ABUTMENT #1 FOOTING REINFORCING

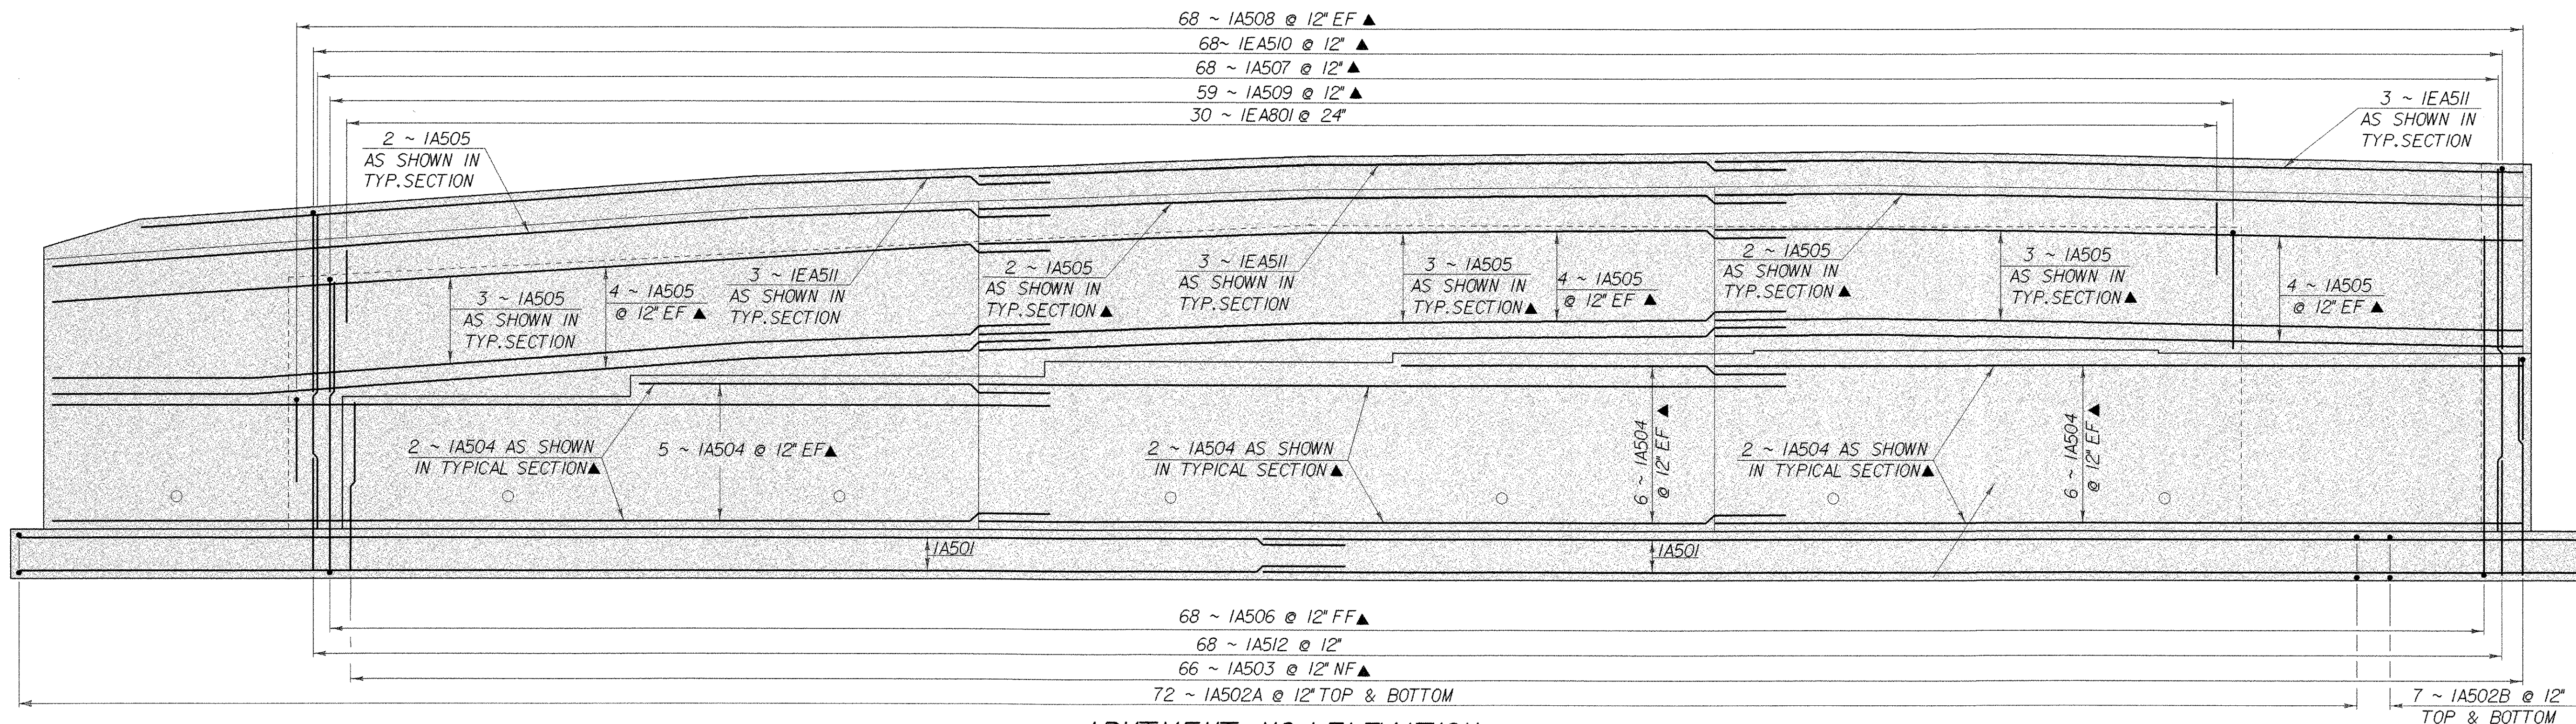

ABUTMENT NO.1 ELEVATION

NOTE:

NF - NEAR FACE
 FF - FAR FACE
 EF - EACH FACE
 ▲ - CUT TO FIT IN FIELD
 3" CLR. UNLESS OTHERWISE SPECIFIED ON THE PLANS.

SCALE 3/8" = 1'-0"
 1 0 1 2 3 4

STATE OF VERMONT AGENCY OF TRANSPORTATION	
Town Of WOODFORD	Bridge No. BR 11
Highway No. VT 9	Log Sta. _____ Surv. Sta. _____
VT 9 OVER ROARING BRANCH OF WALLOOMSAC ABUTMENT #1 REINFORCING	
Designed By M.EVANS-MONGEON	Drawn By R.PELLETT
Checked By M.EVANS-MONGEON	Date _____ Bridge Design Supervisor A.PORTALUPI Date _____
PROJECT WOODFORD	PROJECT NO. BHF 010-1(29)
I.G.C. Info. /84e039/structures/se039sub.dgn	se039ar11
Bridge Sheet No. _____	Sheet 70 of 106