


ABUTMENT NO.2 PLAN

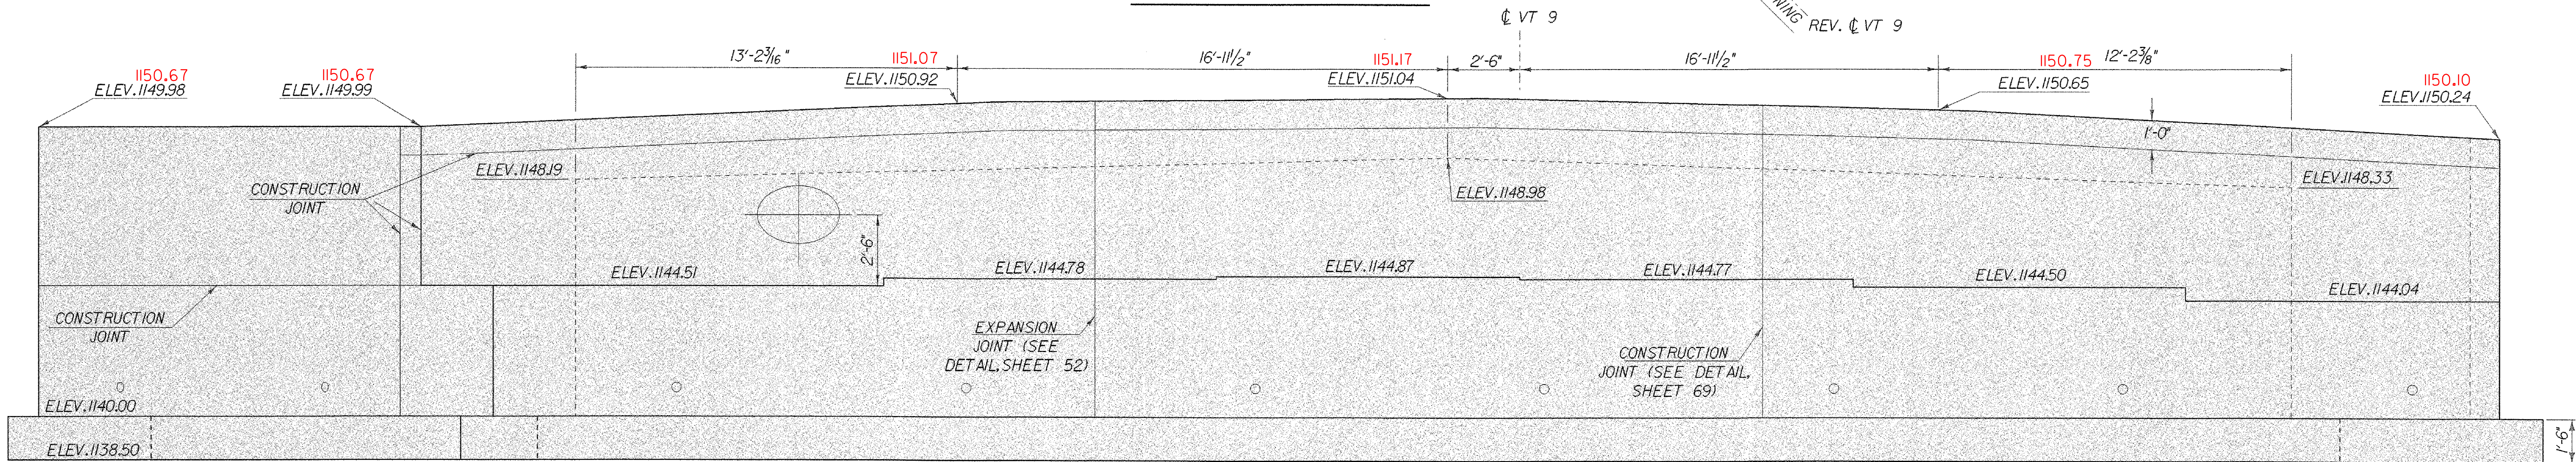

ABUTMENT NO.2 ELEVATION

STATE OF VERMONT AGENCY OF TRANSPORTATION	
Town Of WOODFORD	Bridge No. BR 11
Highway No. VT 9	Log Sta. Surv. Sta.
VT 9 OVER ROARING BRANCH OF WALLOOMSAC ABUTMENT * 2 PLAN & ELEVATION	
Designed By M.EVANS-MONGEON	Drawn By R.PELLETT
Checked By M.EVANS-MONGEON	Date A.PORTALUPI Date
PROJECT WOODFORD	PROJECT NO. BHF 010-1(29)
I.G.C. Info. /84e039/structures/se039sub2j	se039ab2j
Bridge Sheet No.	Sheet 71 of 106

