



RAIL PLACEMENT
(WINGWALL # 1)

SCALE 3/4" = 1'-0"

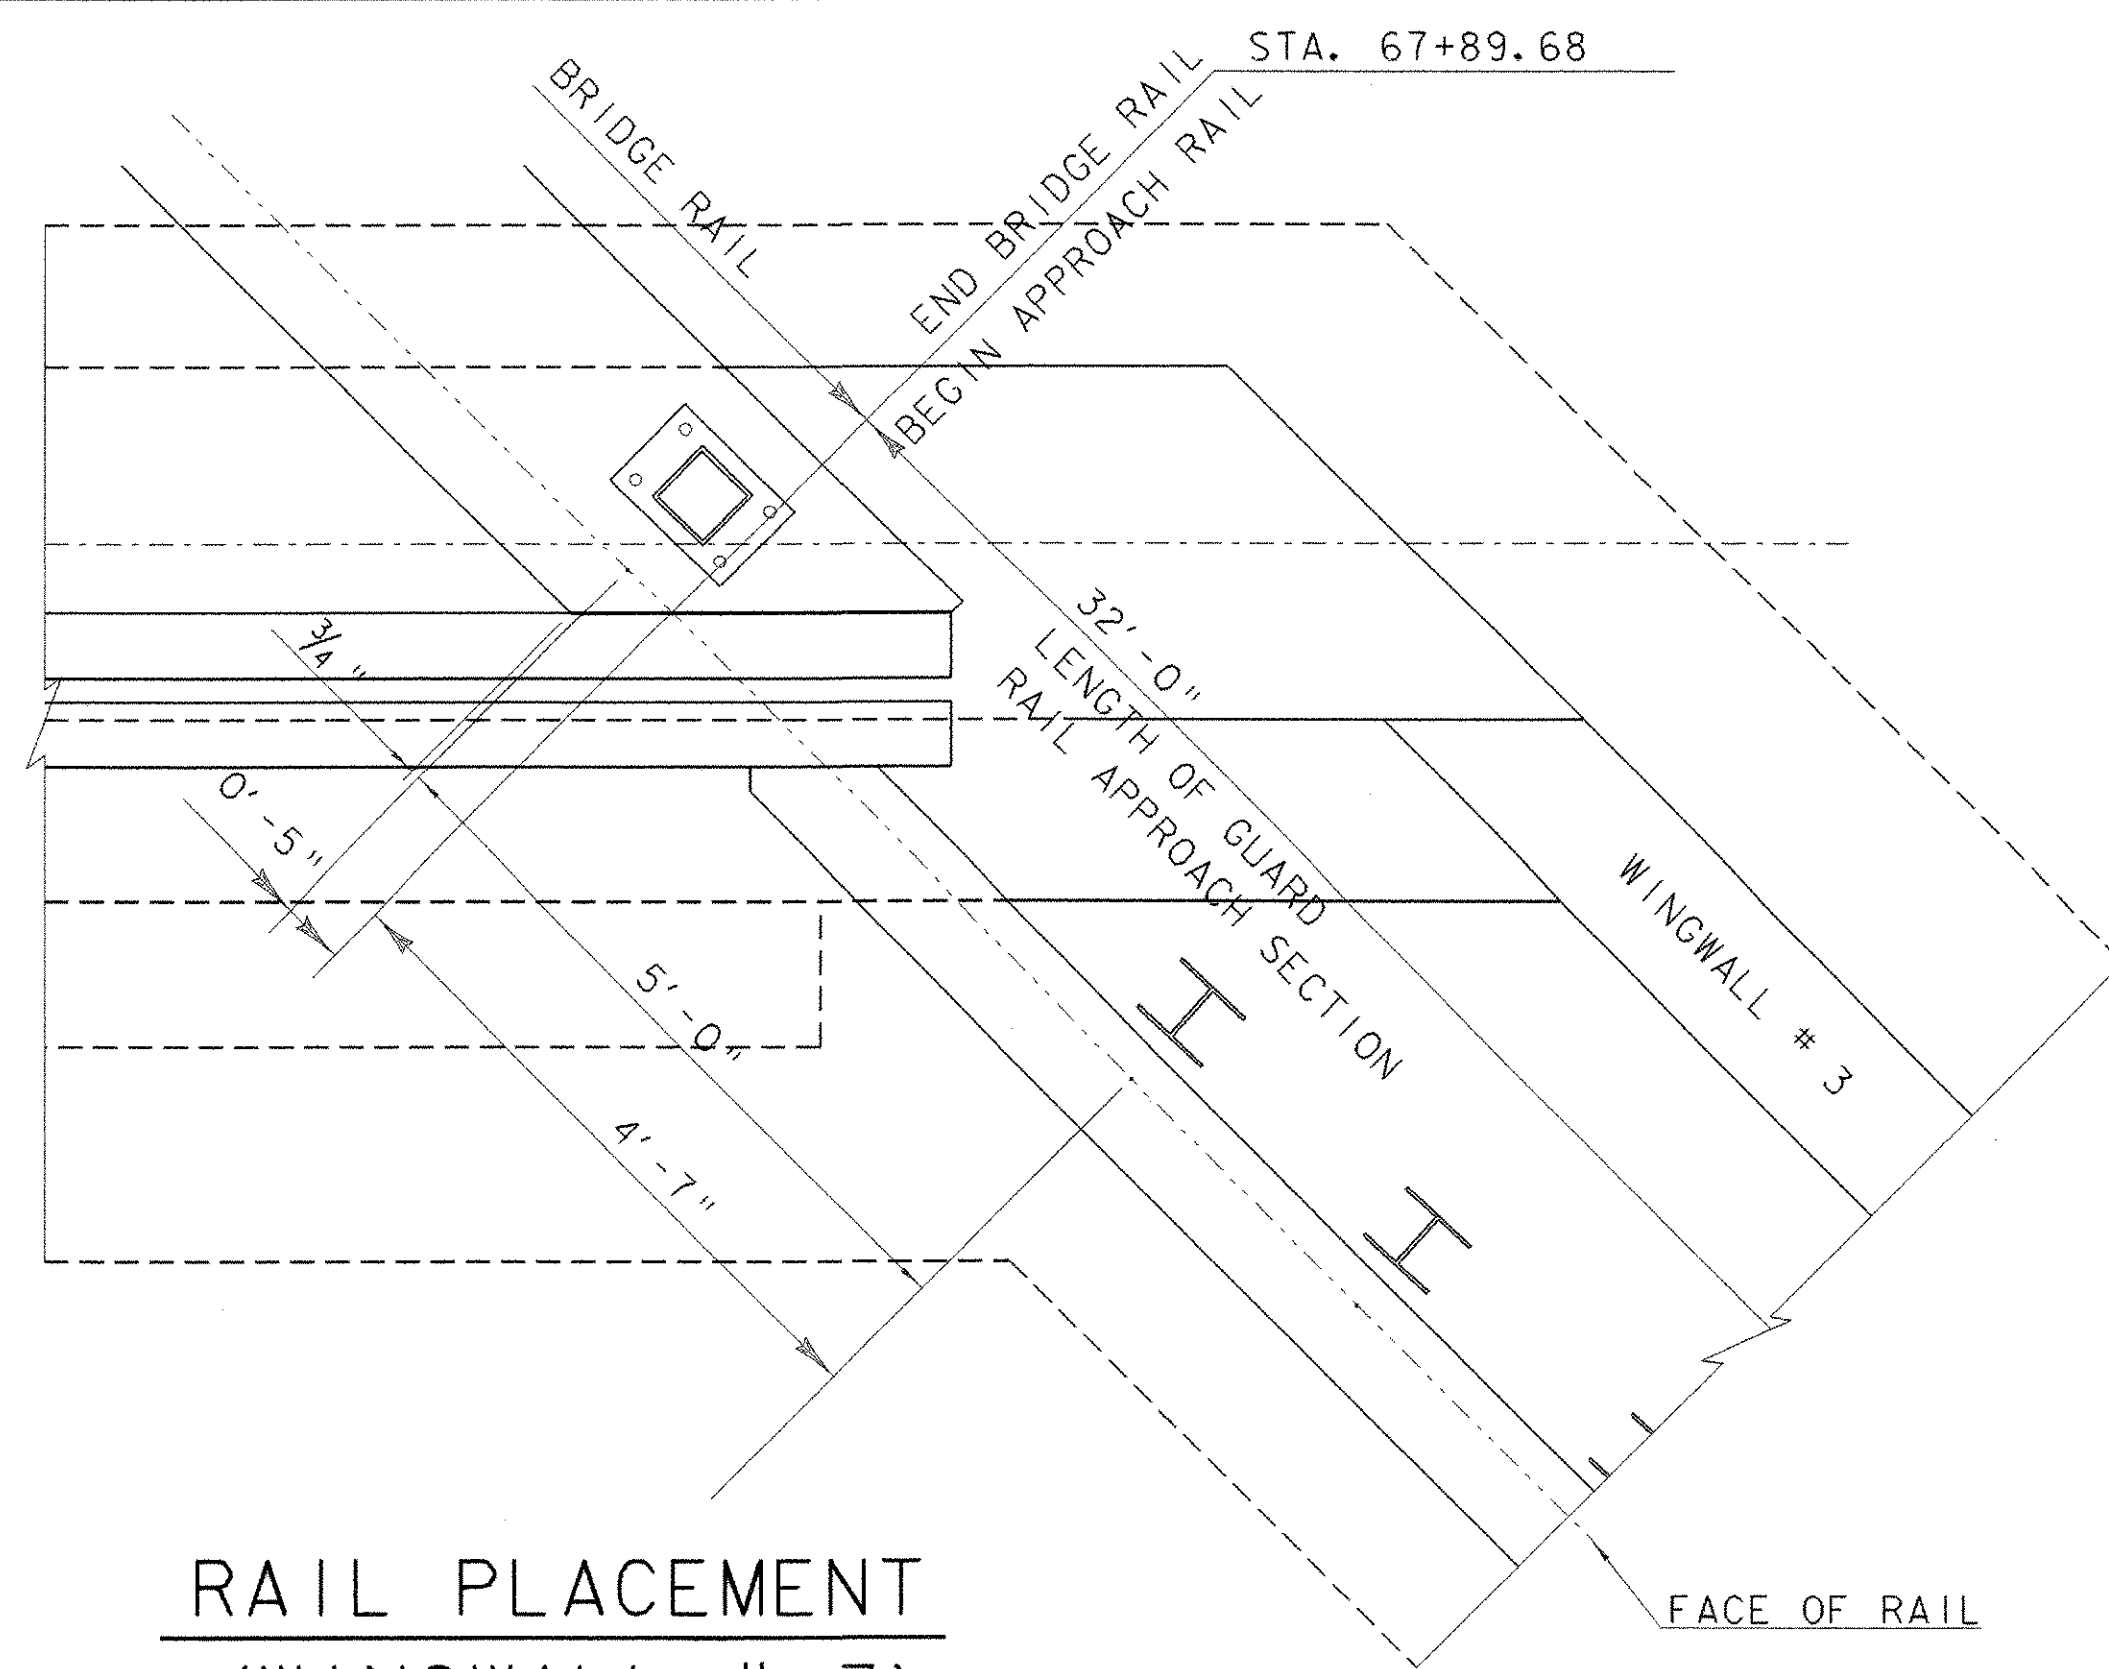


RAIL PLACEMENT
(WINGWALL # 3)

SCALE 3/4" = 1'-0"

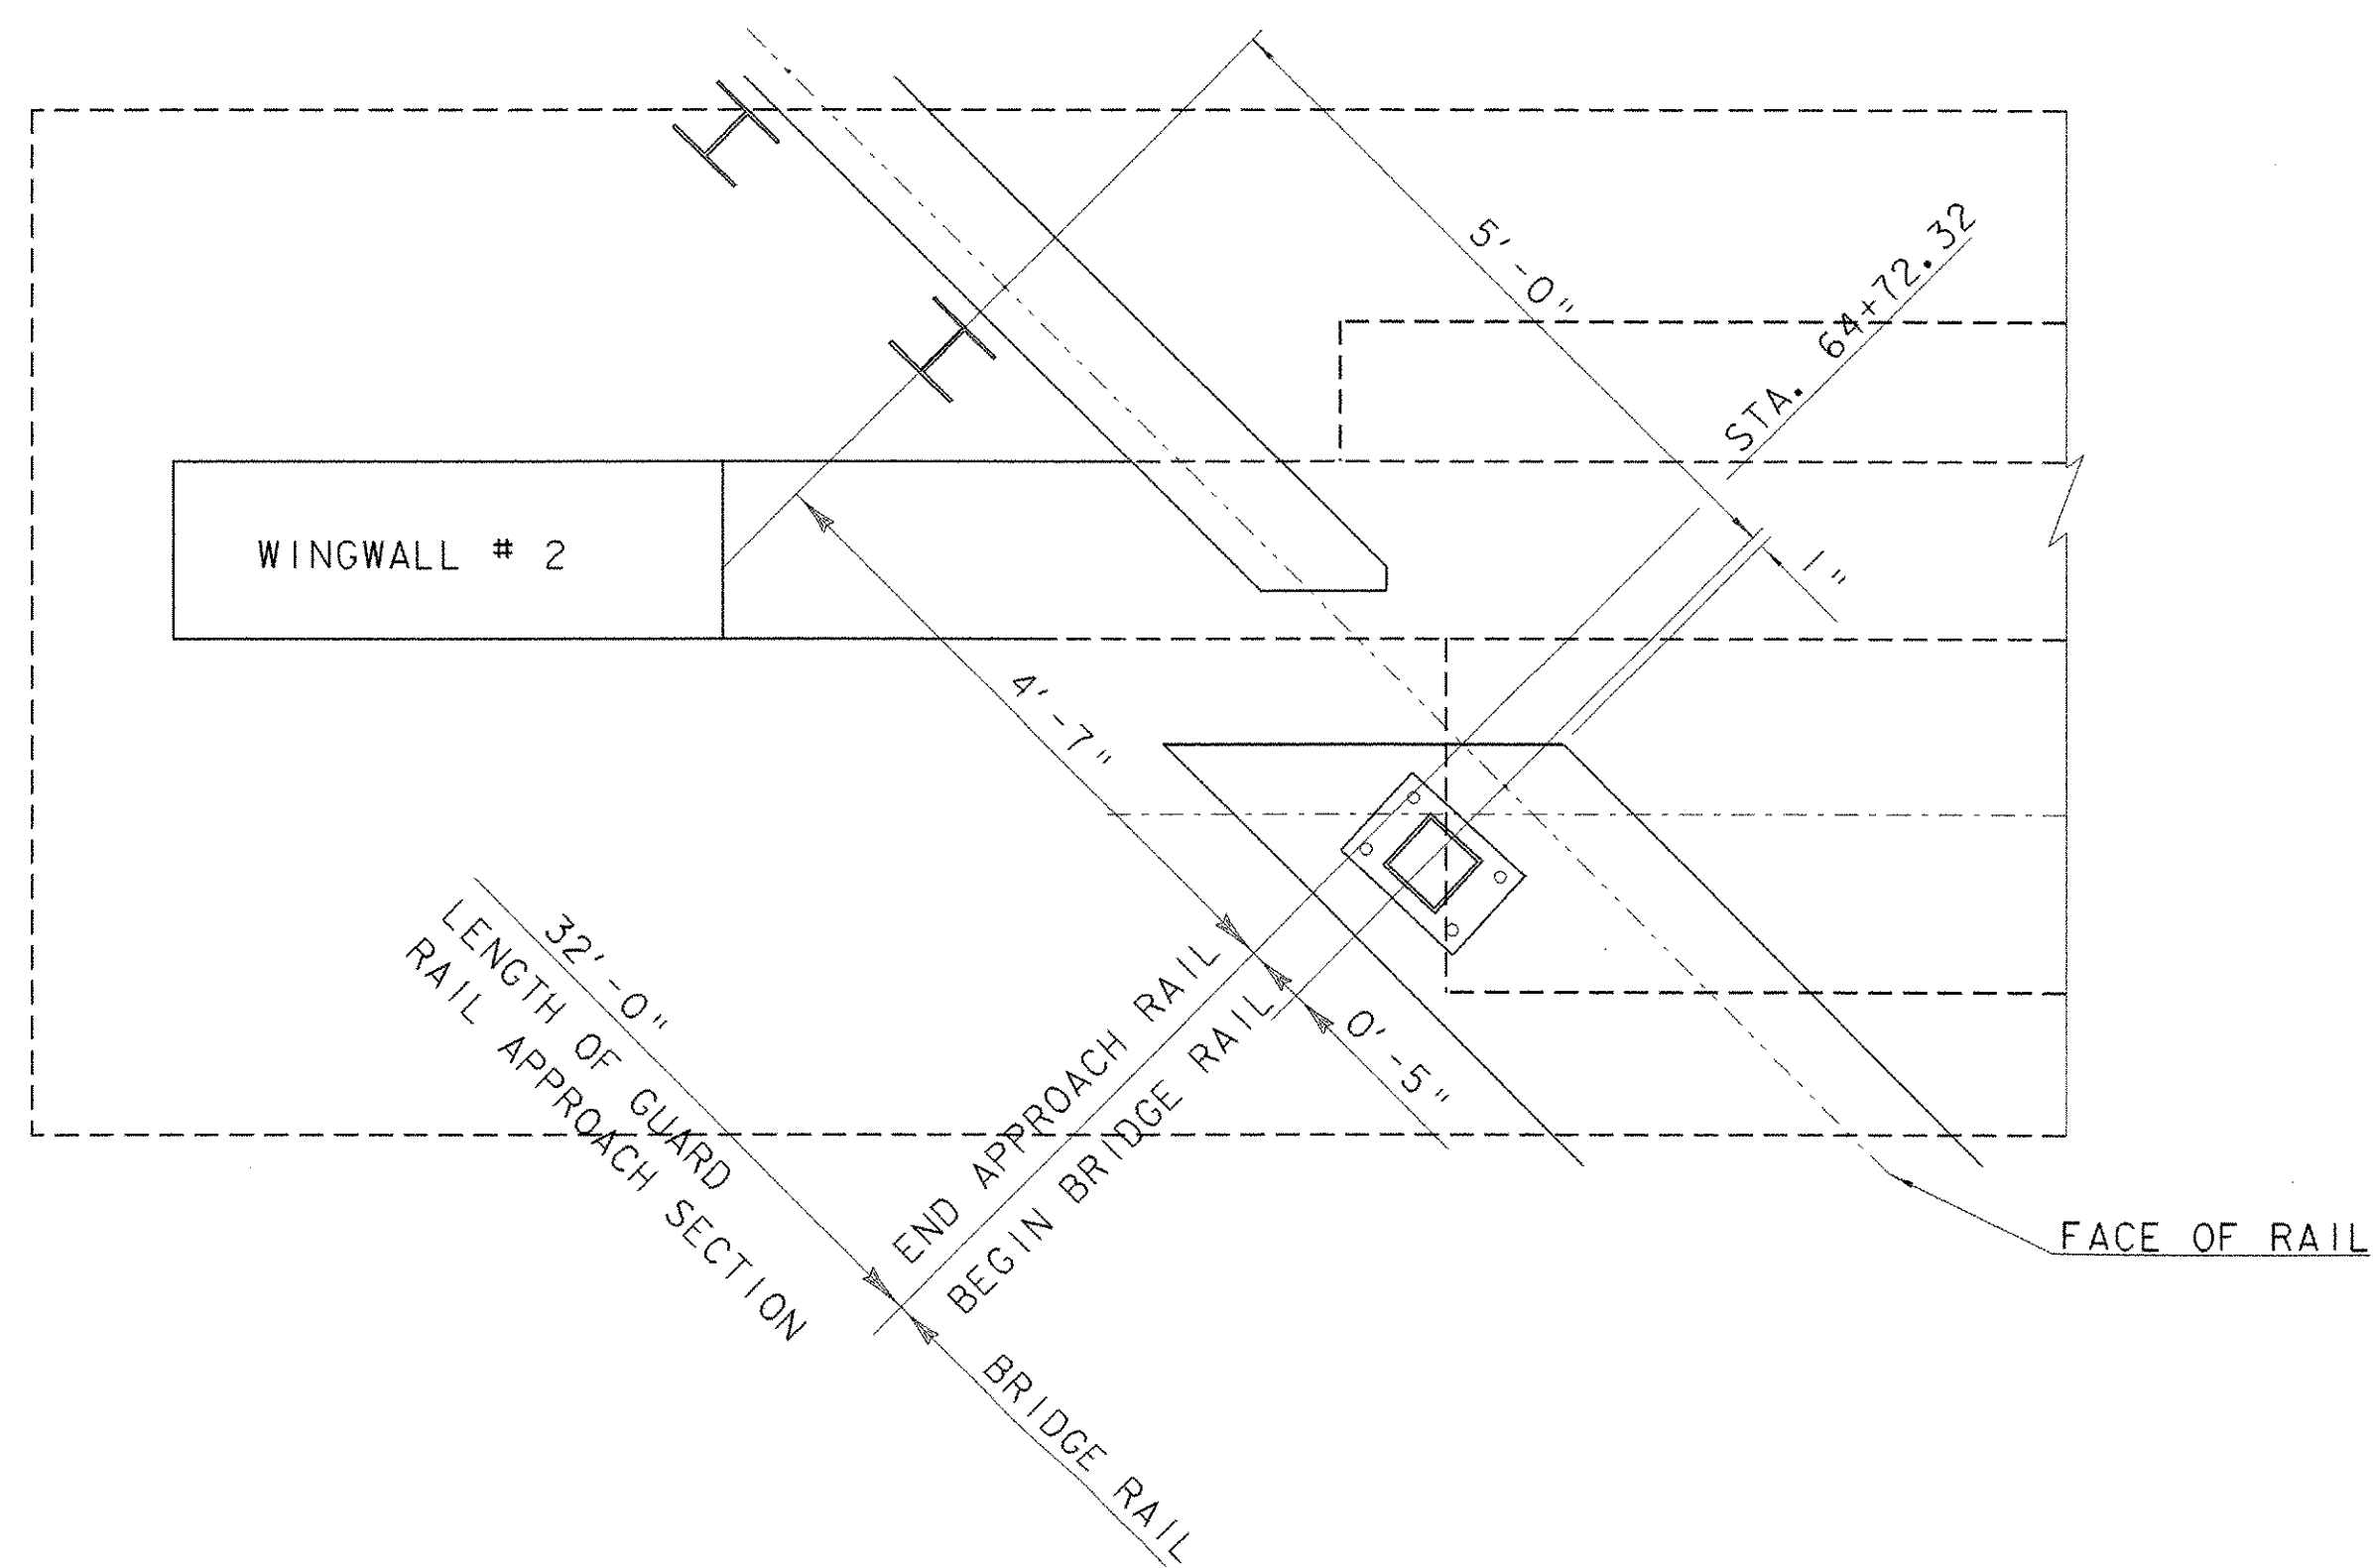

RAIL PLACEMENT
(WINGWALL # 2)

SCALE 3/4" = 1'-0"

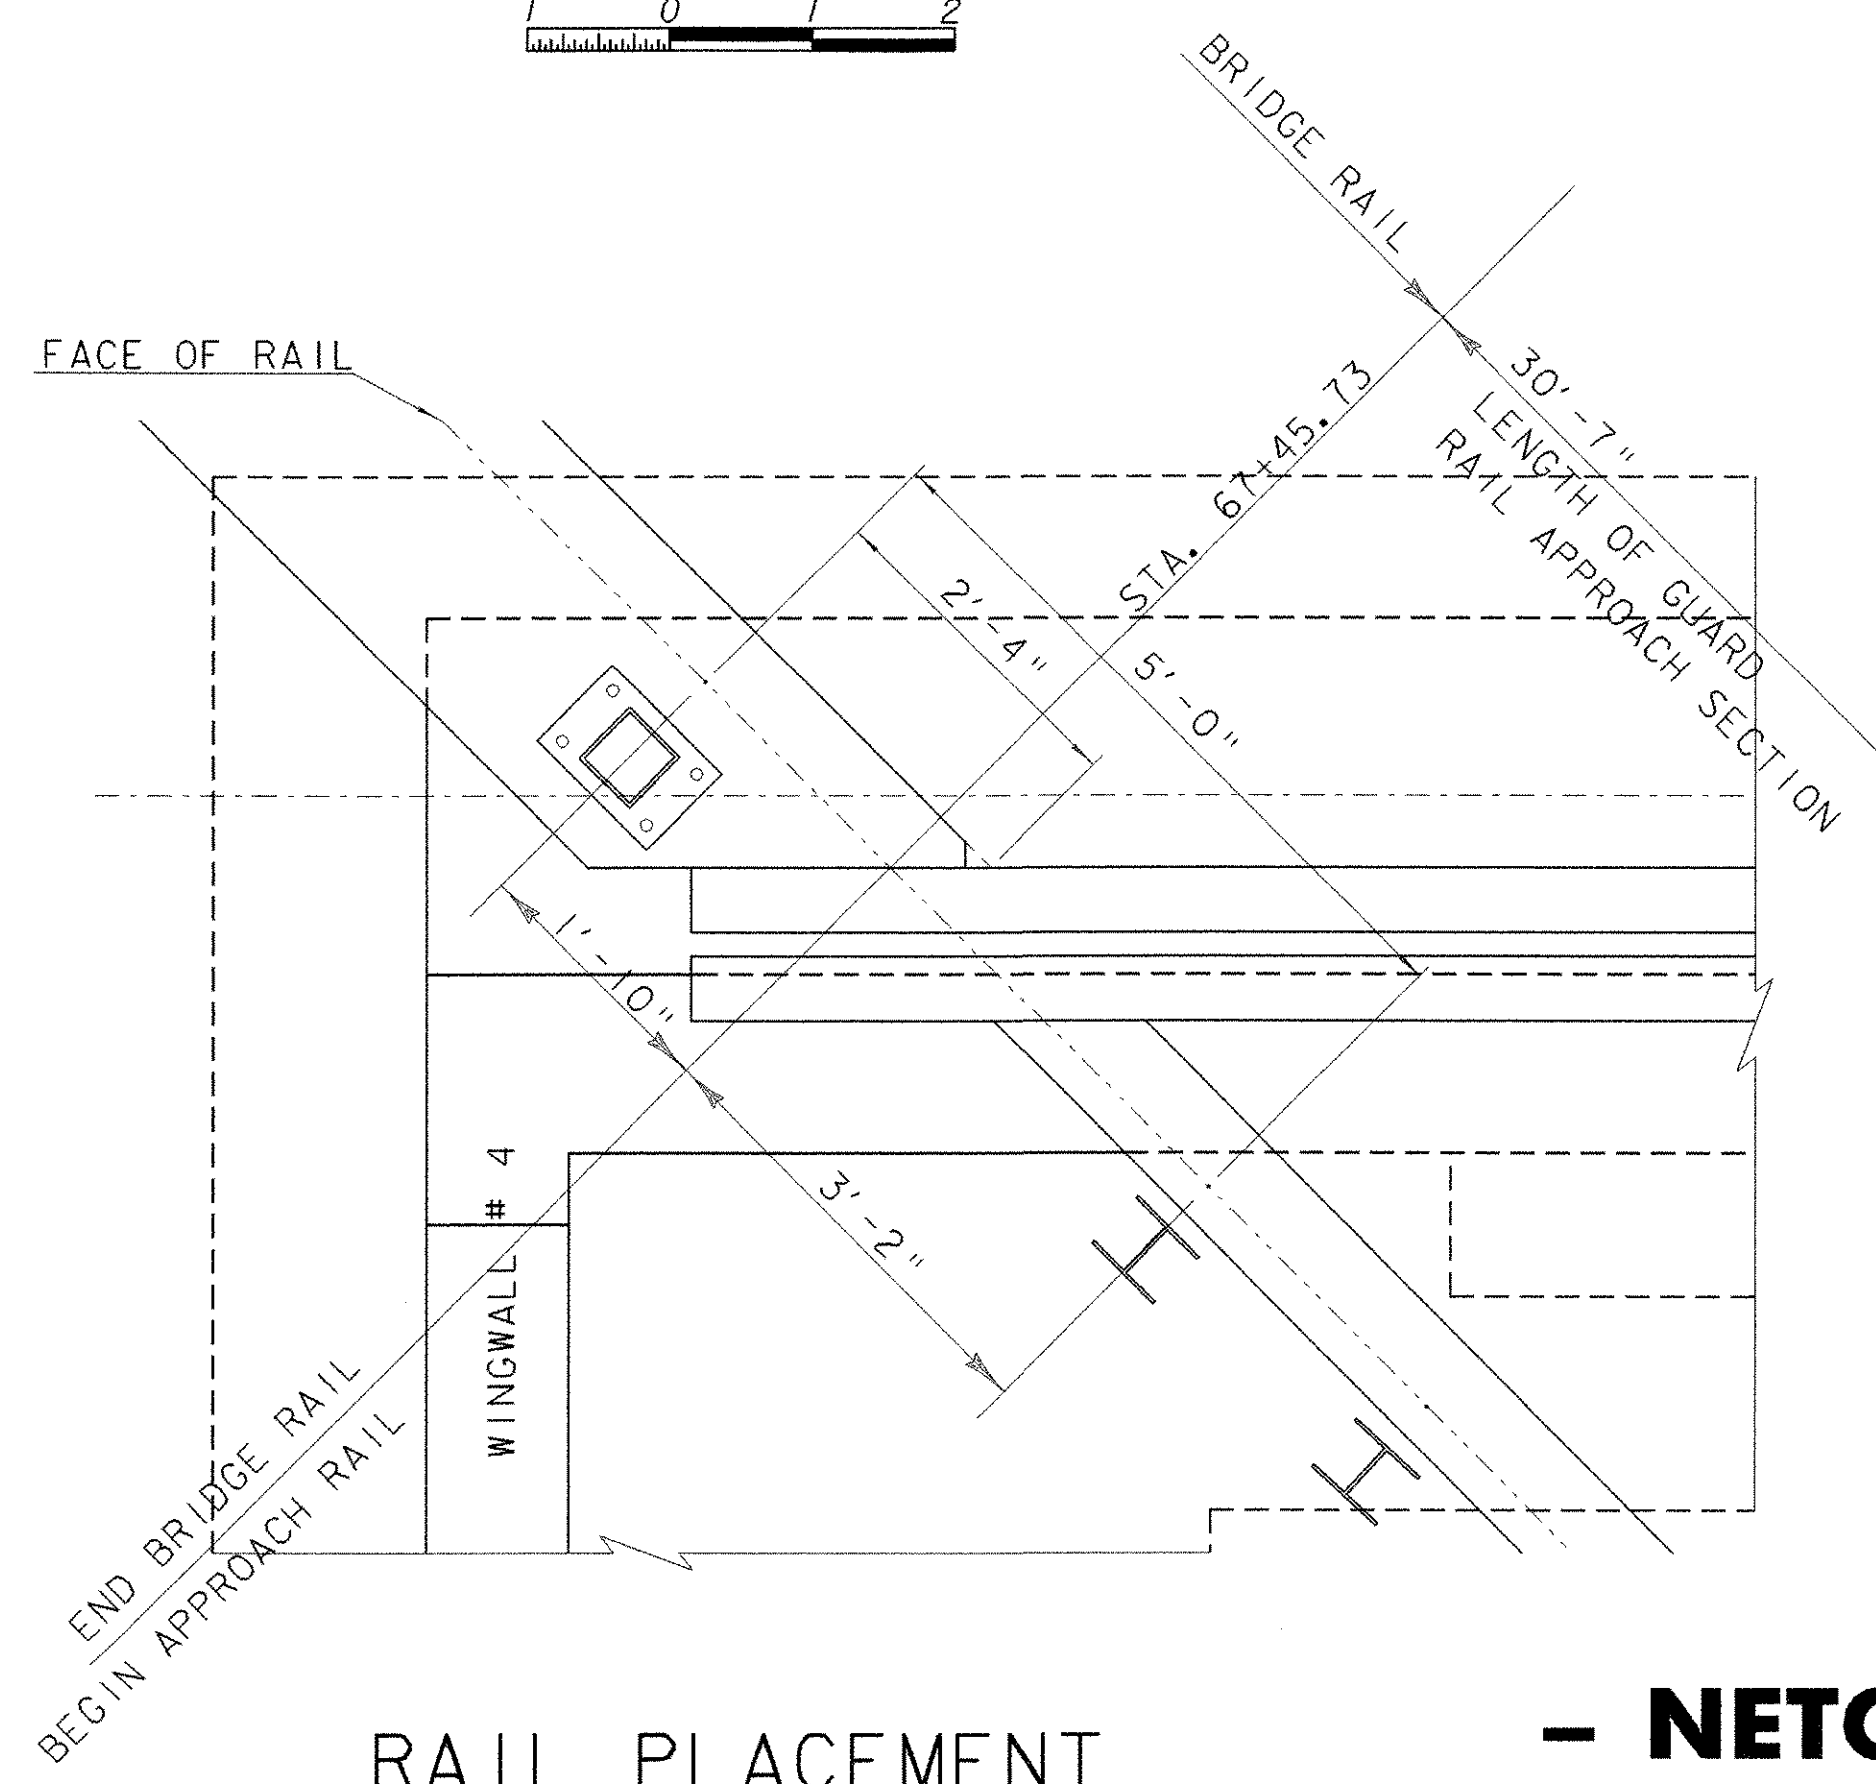

RAIL PLACEMENT
(WINGWALL # 4)

SCALE 3/4" = 1'-0"

**BRIDGE RAILING
- NETC 2 RAIL - PLACEMENT**

PROJECT NAME: WOODFORD	PLOT DATE: 03-OCT-2005
PROJECT NUMBER: BHF 010-1(29)	DRAWN BY: VAN HAMBURG
FILE NAME: /84e039/se039r all.dgn	CHECKED BY: EVANS-MONGEON
PROJECT LEADER: A. PORTALUPI	SHEET 82 OF 106
DESIGNED BY: M.EVANS-MONGEON	