



# BANKING DIAGRAM

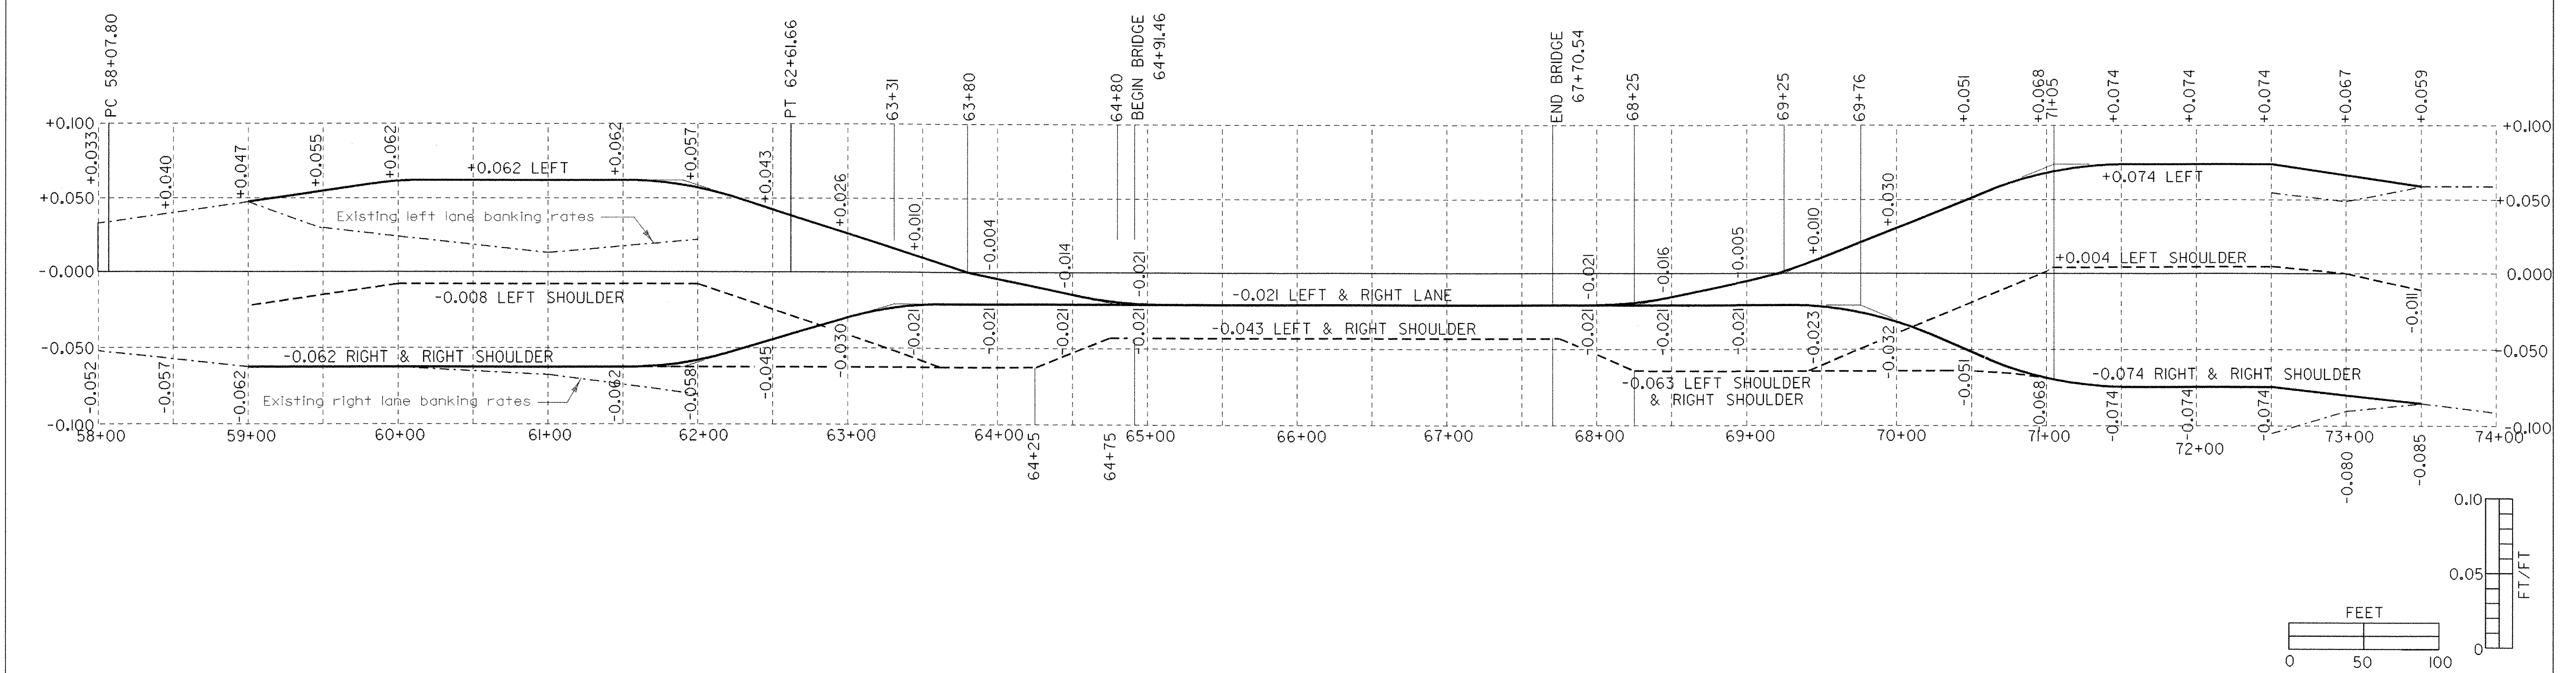

# MATERIAL TRANSITION DIAGRAM

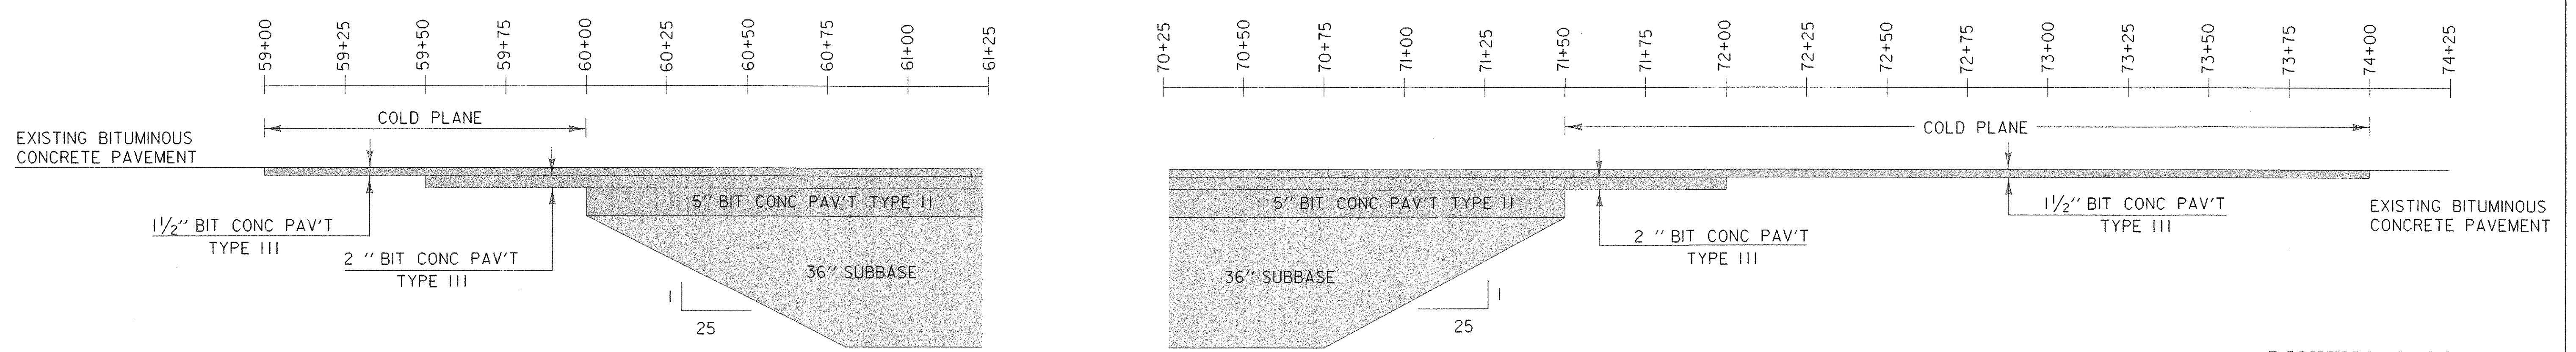

NOT TO SCALE

### BANKING DIAGRAM AND DEPTH TRANSITIONS

DRAWN BY	G. SHANGRAW	DATE	4-12-96
SQUAD LEADER	A. PORTALUPI		
DESIGN FILE NO.	84e039/structures/de039xs.dgn		
IPARM FILE	de039bnk.i	DATE PLOTTED	03-OCT-2005
PROJ. NAME	WOODFORD		
PROJ. NO.	BHF 010-(129)		
SHEET	83	OF	106 SHEETS