


DATUM
 VERTICAL NGVD 1929
 HORIZONTAL N/A

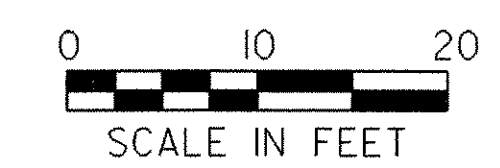

59+00
Begin
Approach

58+00 - 59+50

| | |
|---------------------------------------|------------------------------|
| PROJECT: WOODFORD | PROJECT NO.: BHF 010-(29) |
| DESIGN FILE NAME: /84e039/de039xs.dgn | PLOT DATE: 03-OCT-2005 |
| IPARM FILE NAME: de039x01.i | SURVEY DATE: 12-88 |
| SURVEYED BY: MOREAU | DRAWN BY: EVANS-MONGEON |
| SQUAD LEADER: PORTALUPI | SHEET: 86 OF 106 |