




61+50

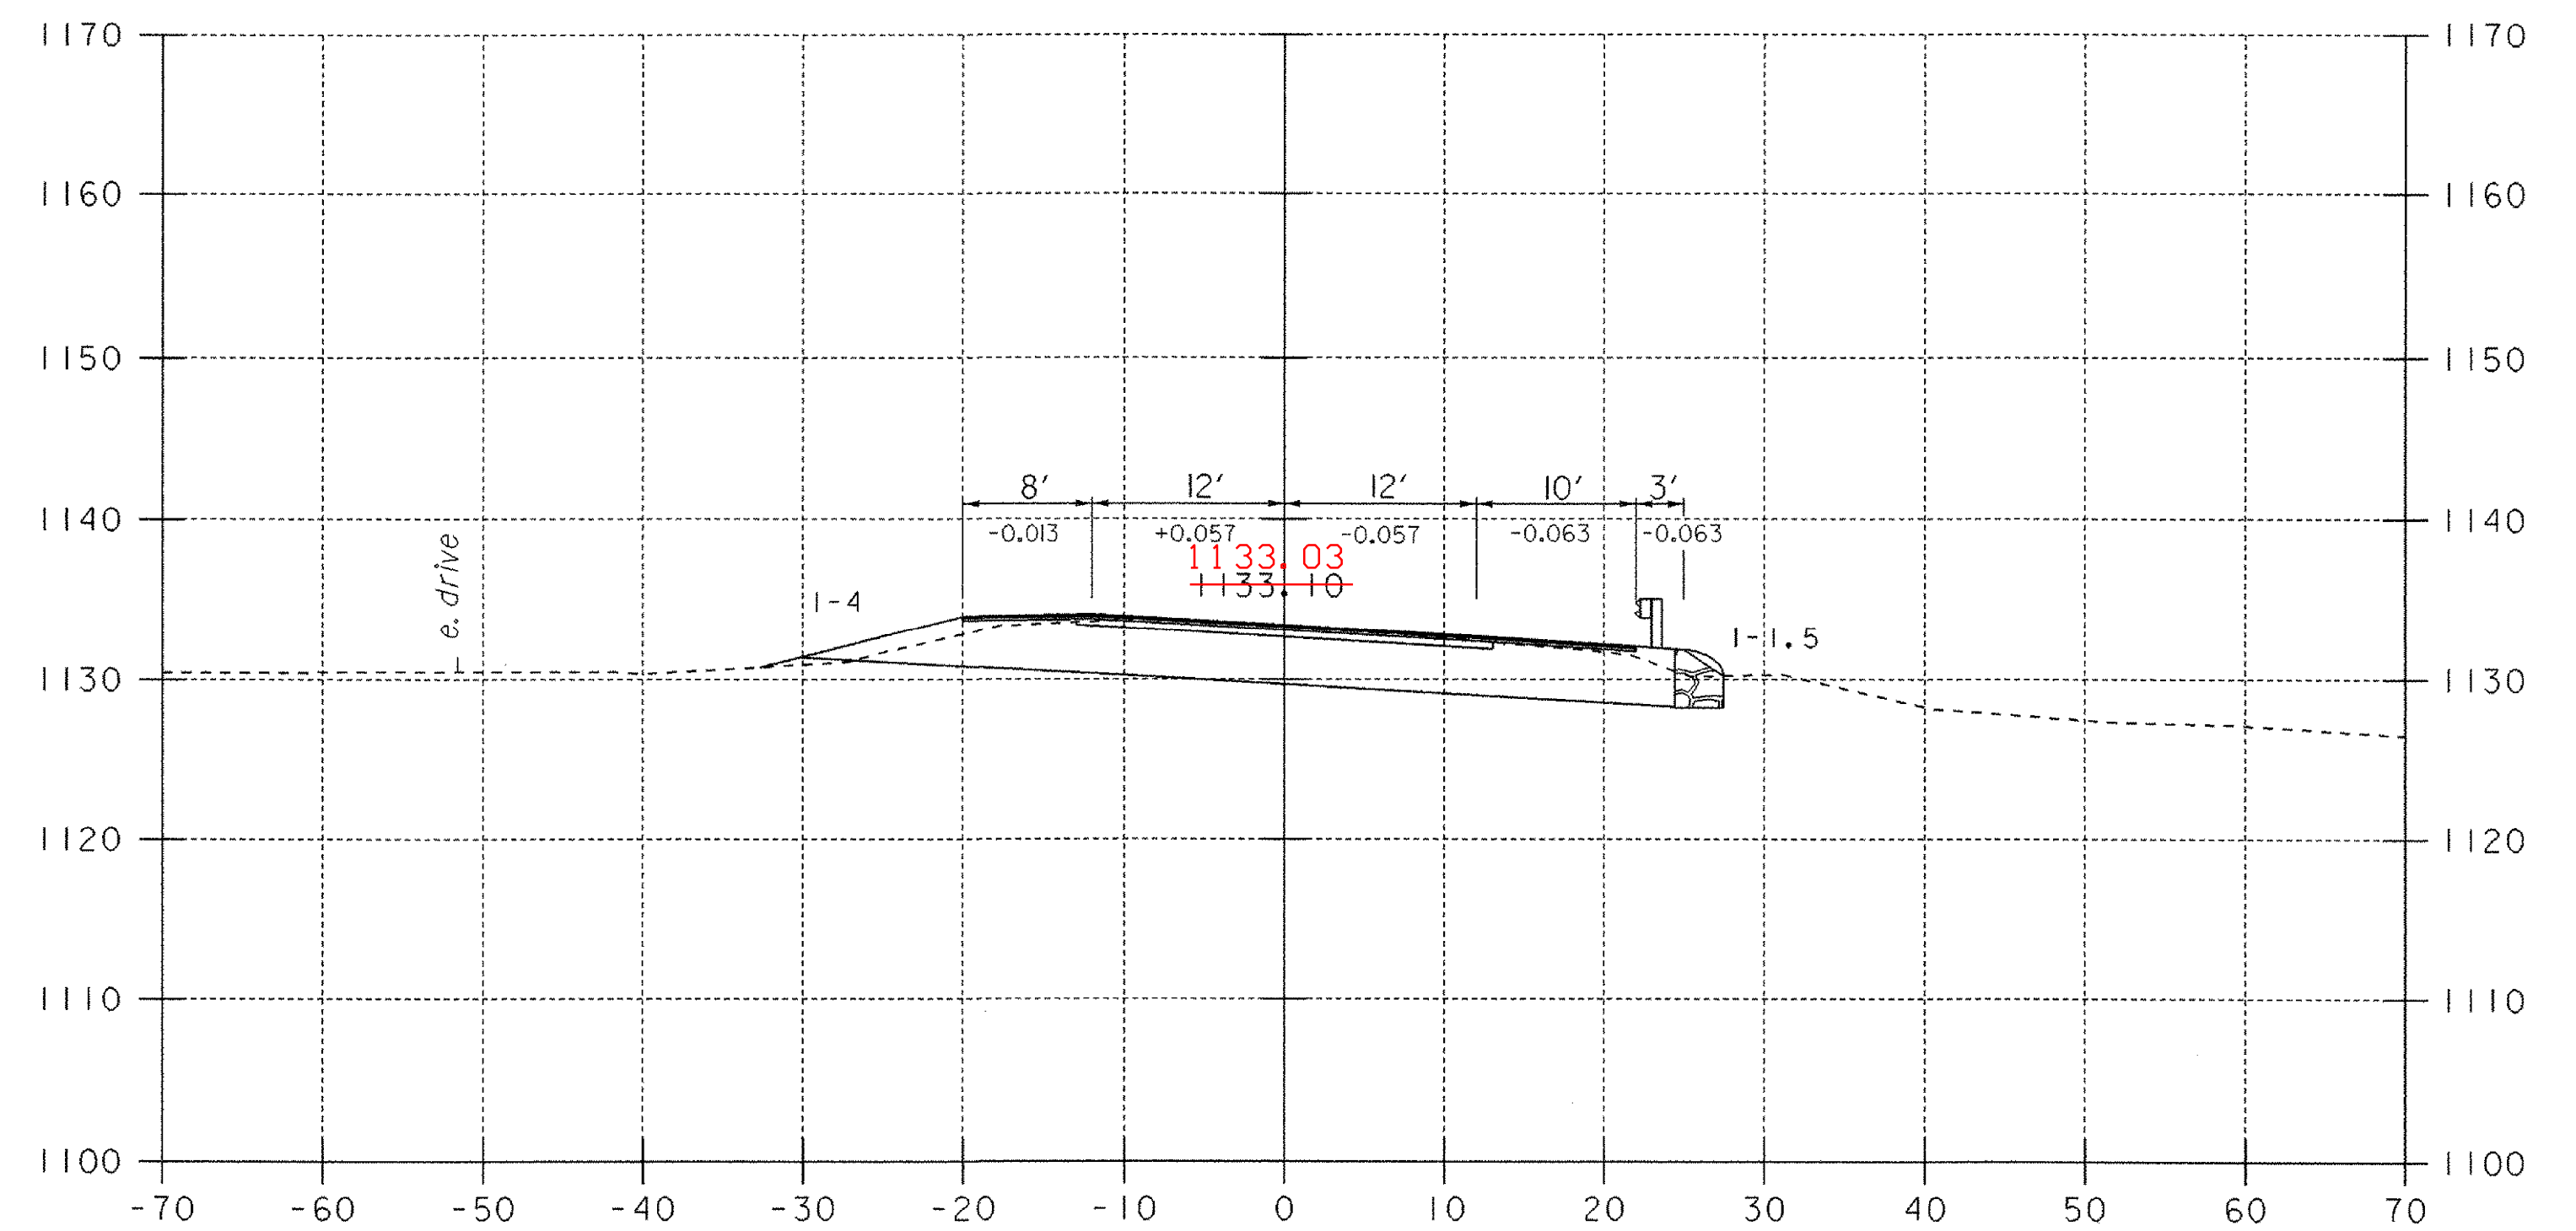

62+00

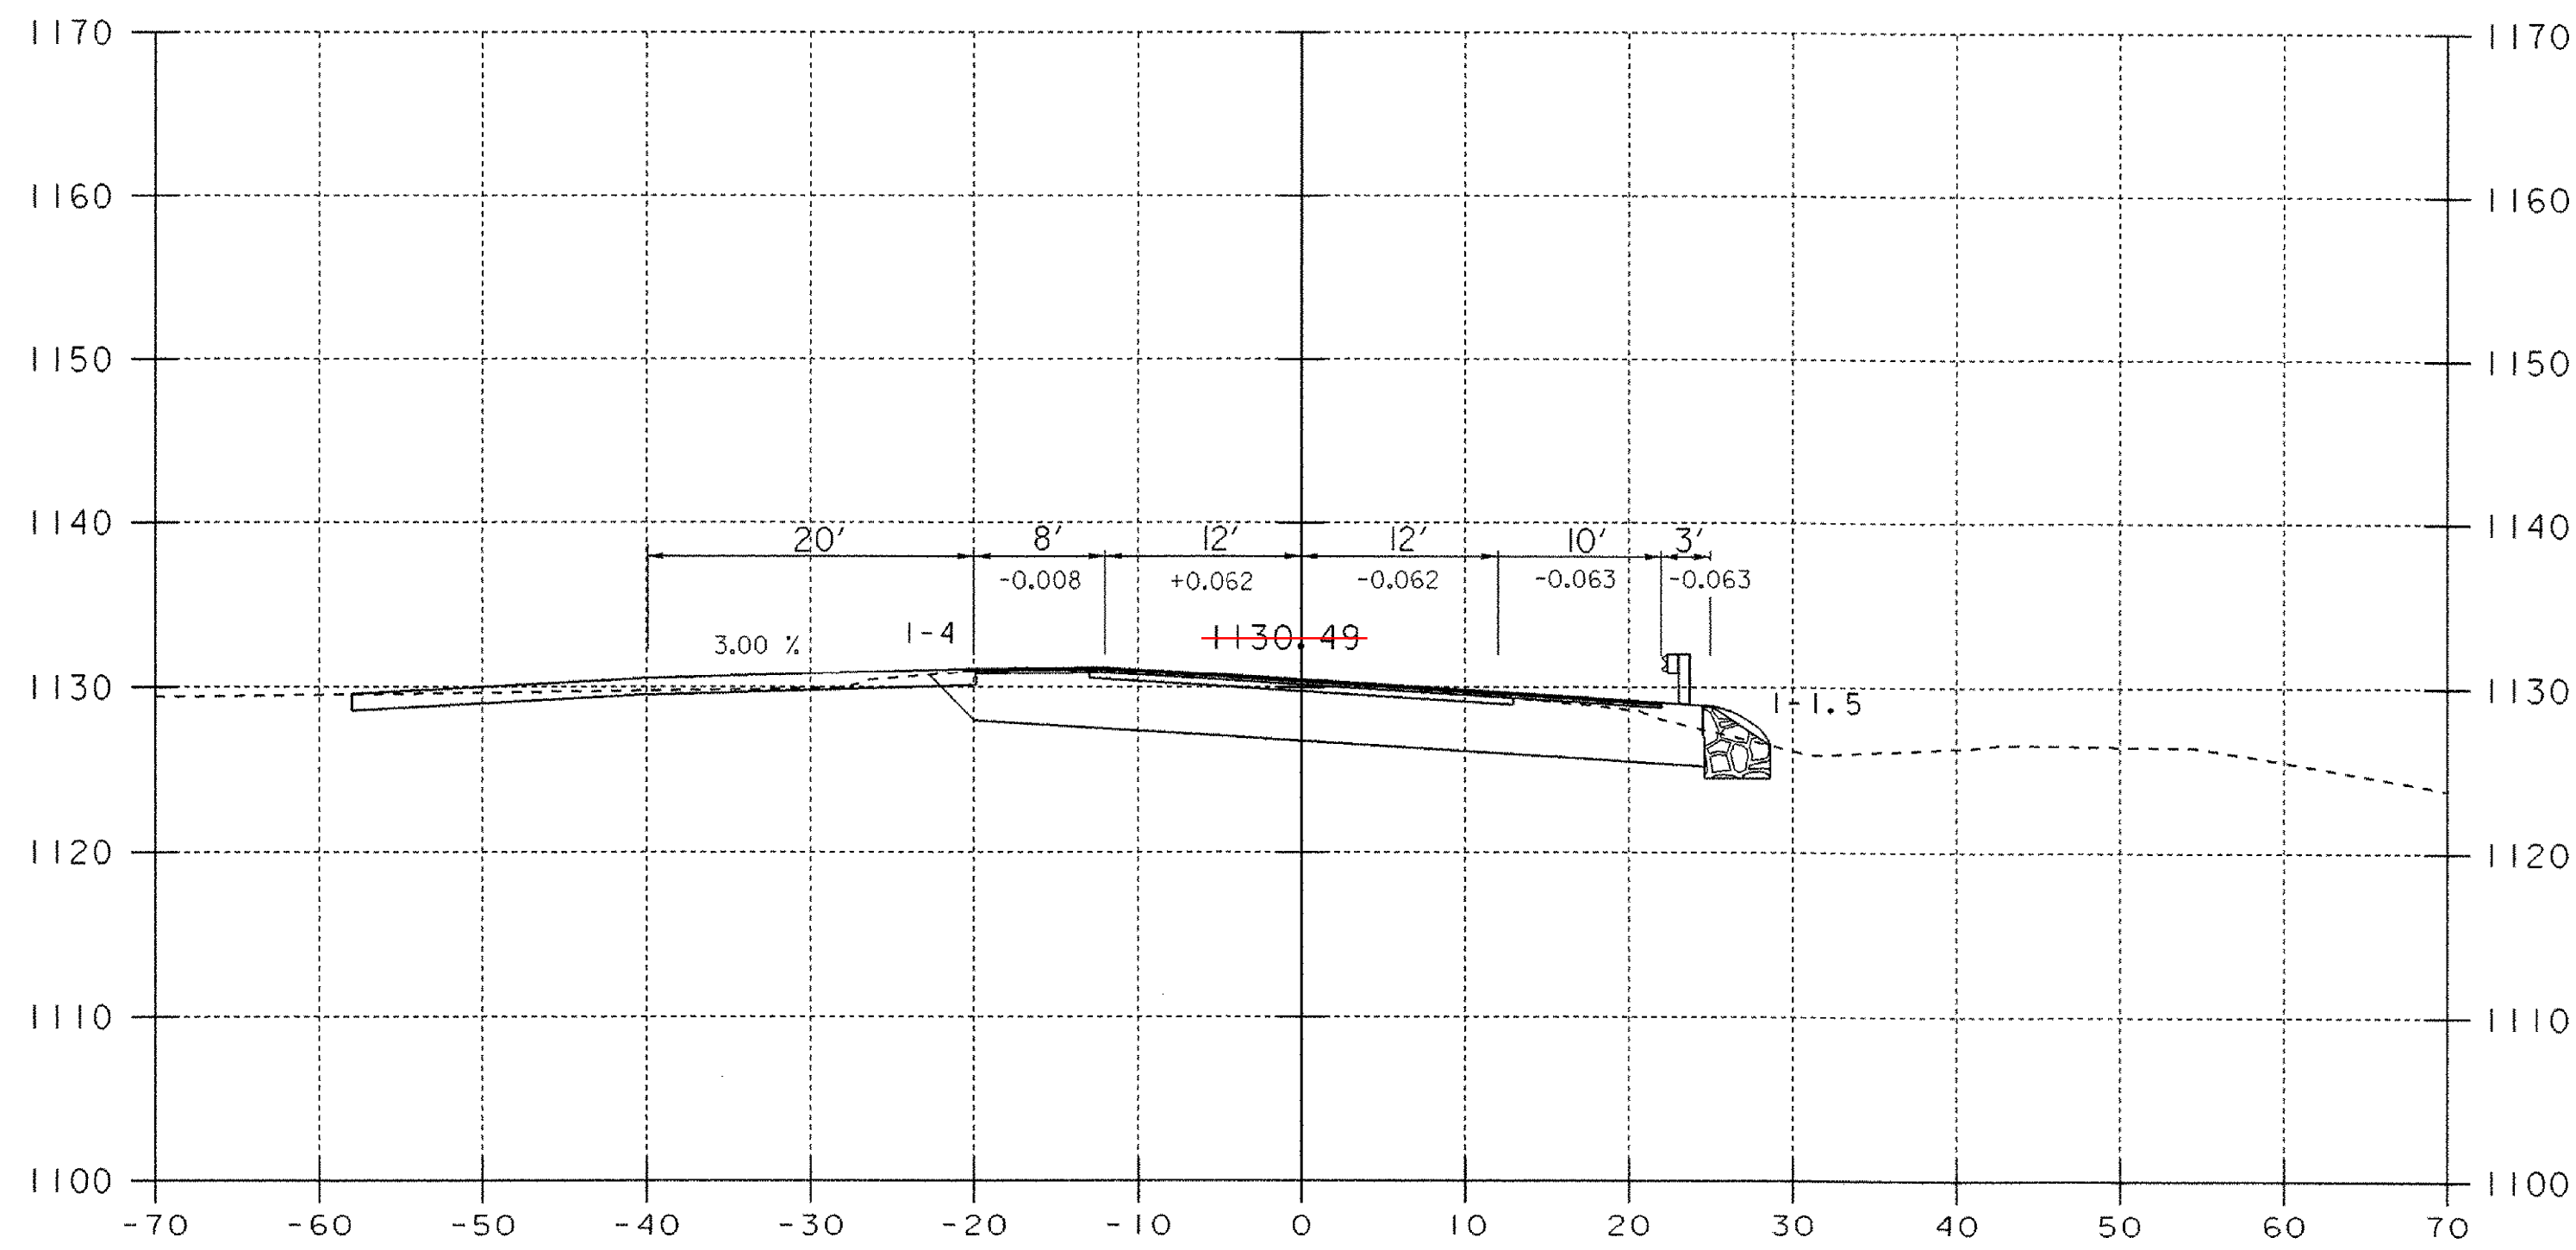


61+25

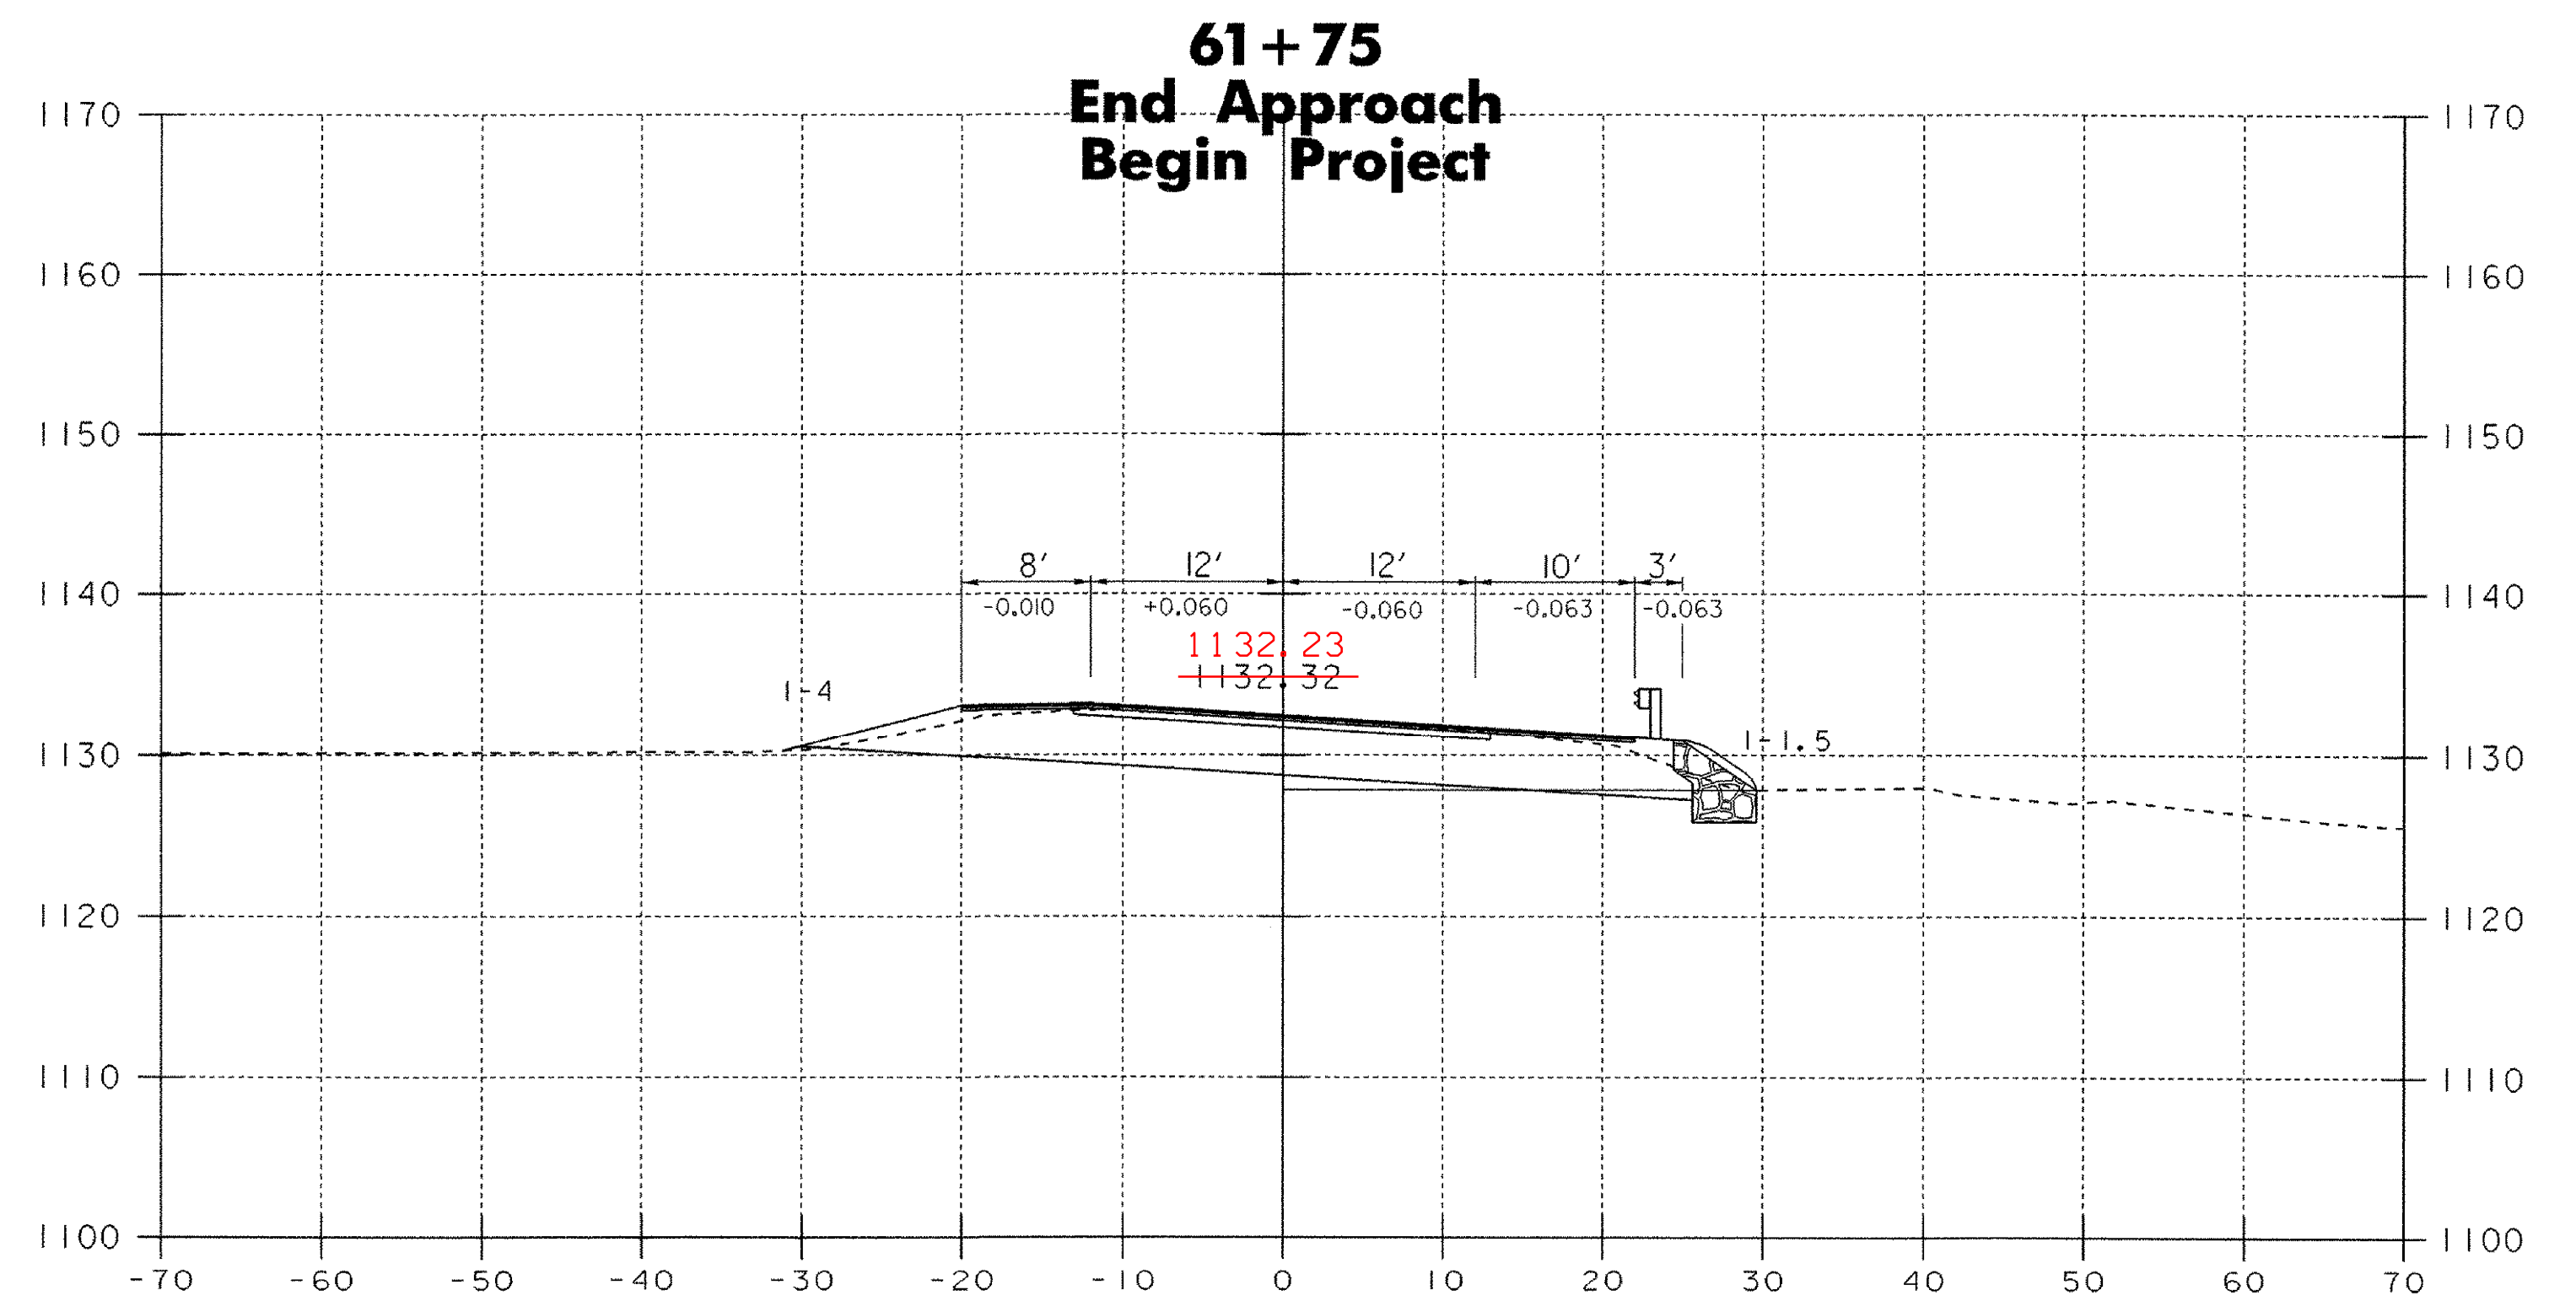

61+80

61+25 - 62+00

DATUM  
 VERTICAL NGVD 1929  
 HORIZONTAL N/A

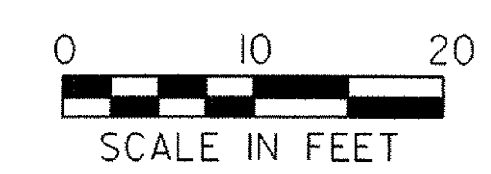

PROJECT: WOODFORD	PROJECT NO. : BHF 010-1(29)
DESIGN FILE NAME: /84e039/de039xs.dgn	PLOT DATE: 03-OCT-2005
IPARM FILE NAME: de039x03.1	SURVEY DATE: 12-88
SURVEYED BY: MOREAU	DRAWN BY: EVANS-MONGEON
SQUAD LEADER: PORTALUPI	SHEET: 88 OF 106