


DATUM  
VERTICAL NGVD 1929  
HORIZONTAL N/A

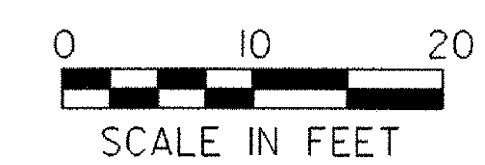

PROJECT: <b>WOODFORD</b>	PROJECT NO. : <b>BHF 010-1(29)</b>
DESIGN FILE NAME: /84e039/de039xs.dgn	PLOT DATE: 03-OCT-2005
IPARM FILE NAME: de039x05.1	SURVEY DATE: 12-88
SURVEYED BY: MOREAU	DRAWN BY: EVANS-MONGEON
SQUAD LEADER: PORTALUPI	SHEET: 90 OF 106

**63+50 - 64+50**