


64+68 - 65+50

DATUM	NGVD 1929
VERTICAL	
HORIZONTAL	N/A

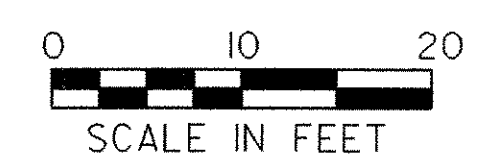

PROJECT: WOODFORD	PROJECT NO.: BHF 010-(29)
DESIGN FILE NAME: /84e039/de039xs.dgn	PLOT DATE: 03-OCT-2005
IPARM FILE NAME: de039x06.i	SURVEY DATE: 12-88
SURVEYED BY: MOREAU	DRAWN BY: EVANS-MONGEON
SQUAD LEADER: PORTALUPI	SHEET: 91 OF 106