




**70+50**  
End Project  
Begin Approach

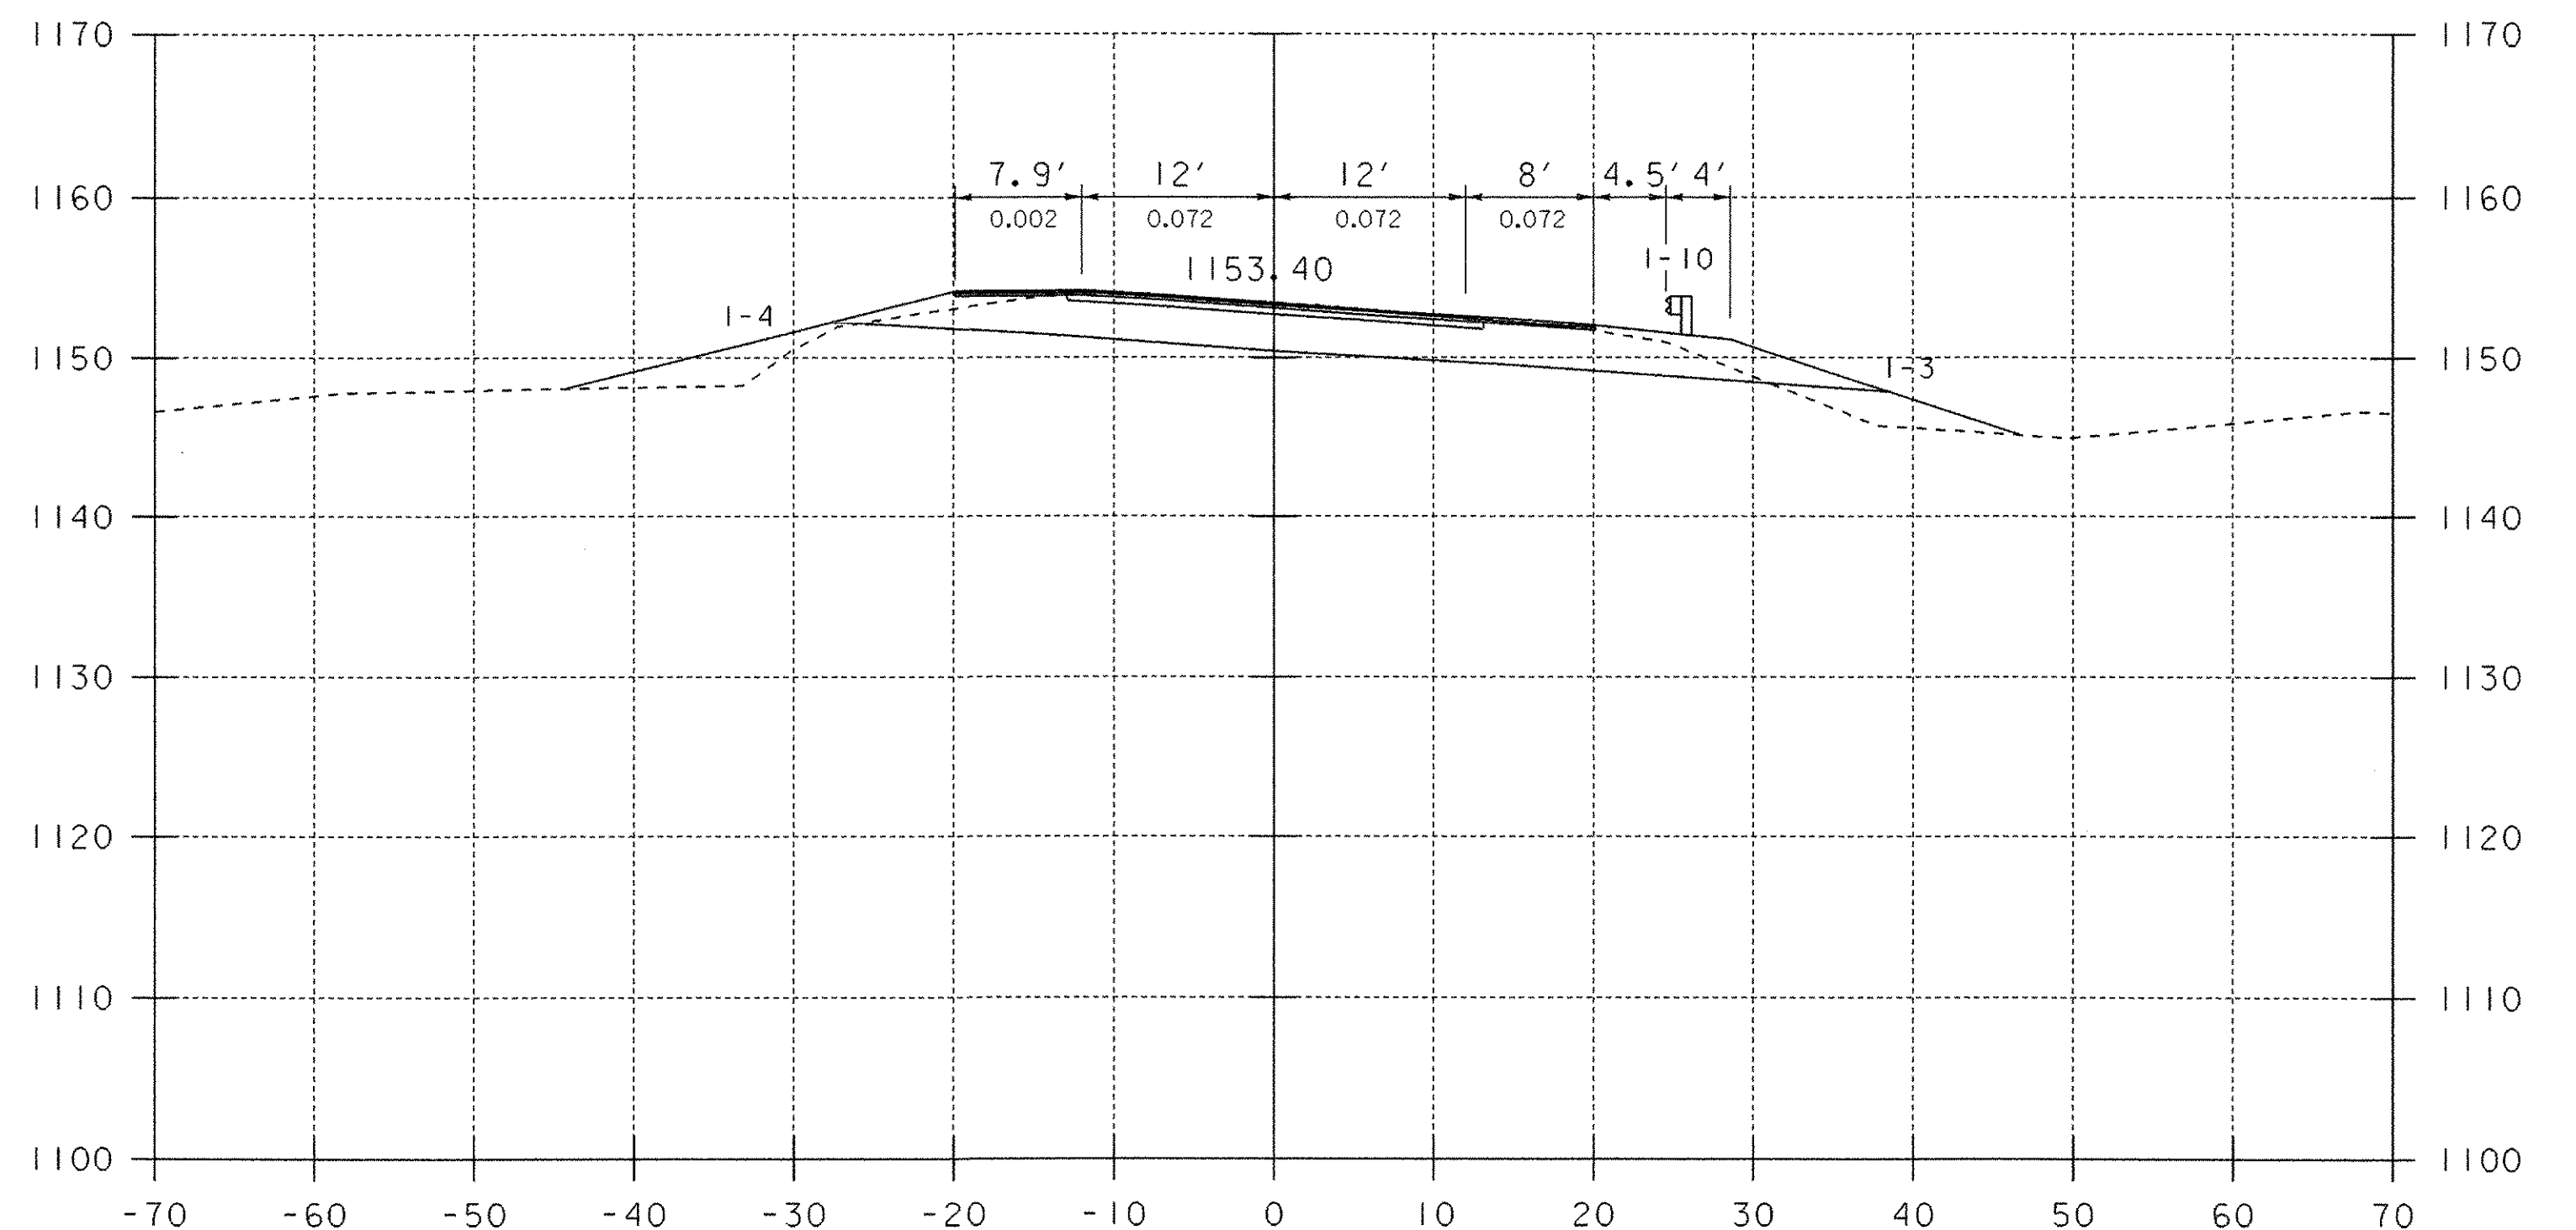

**70+88**

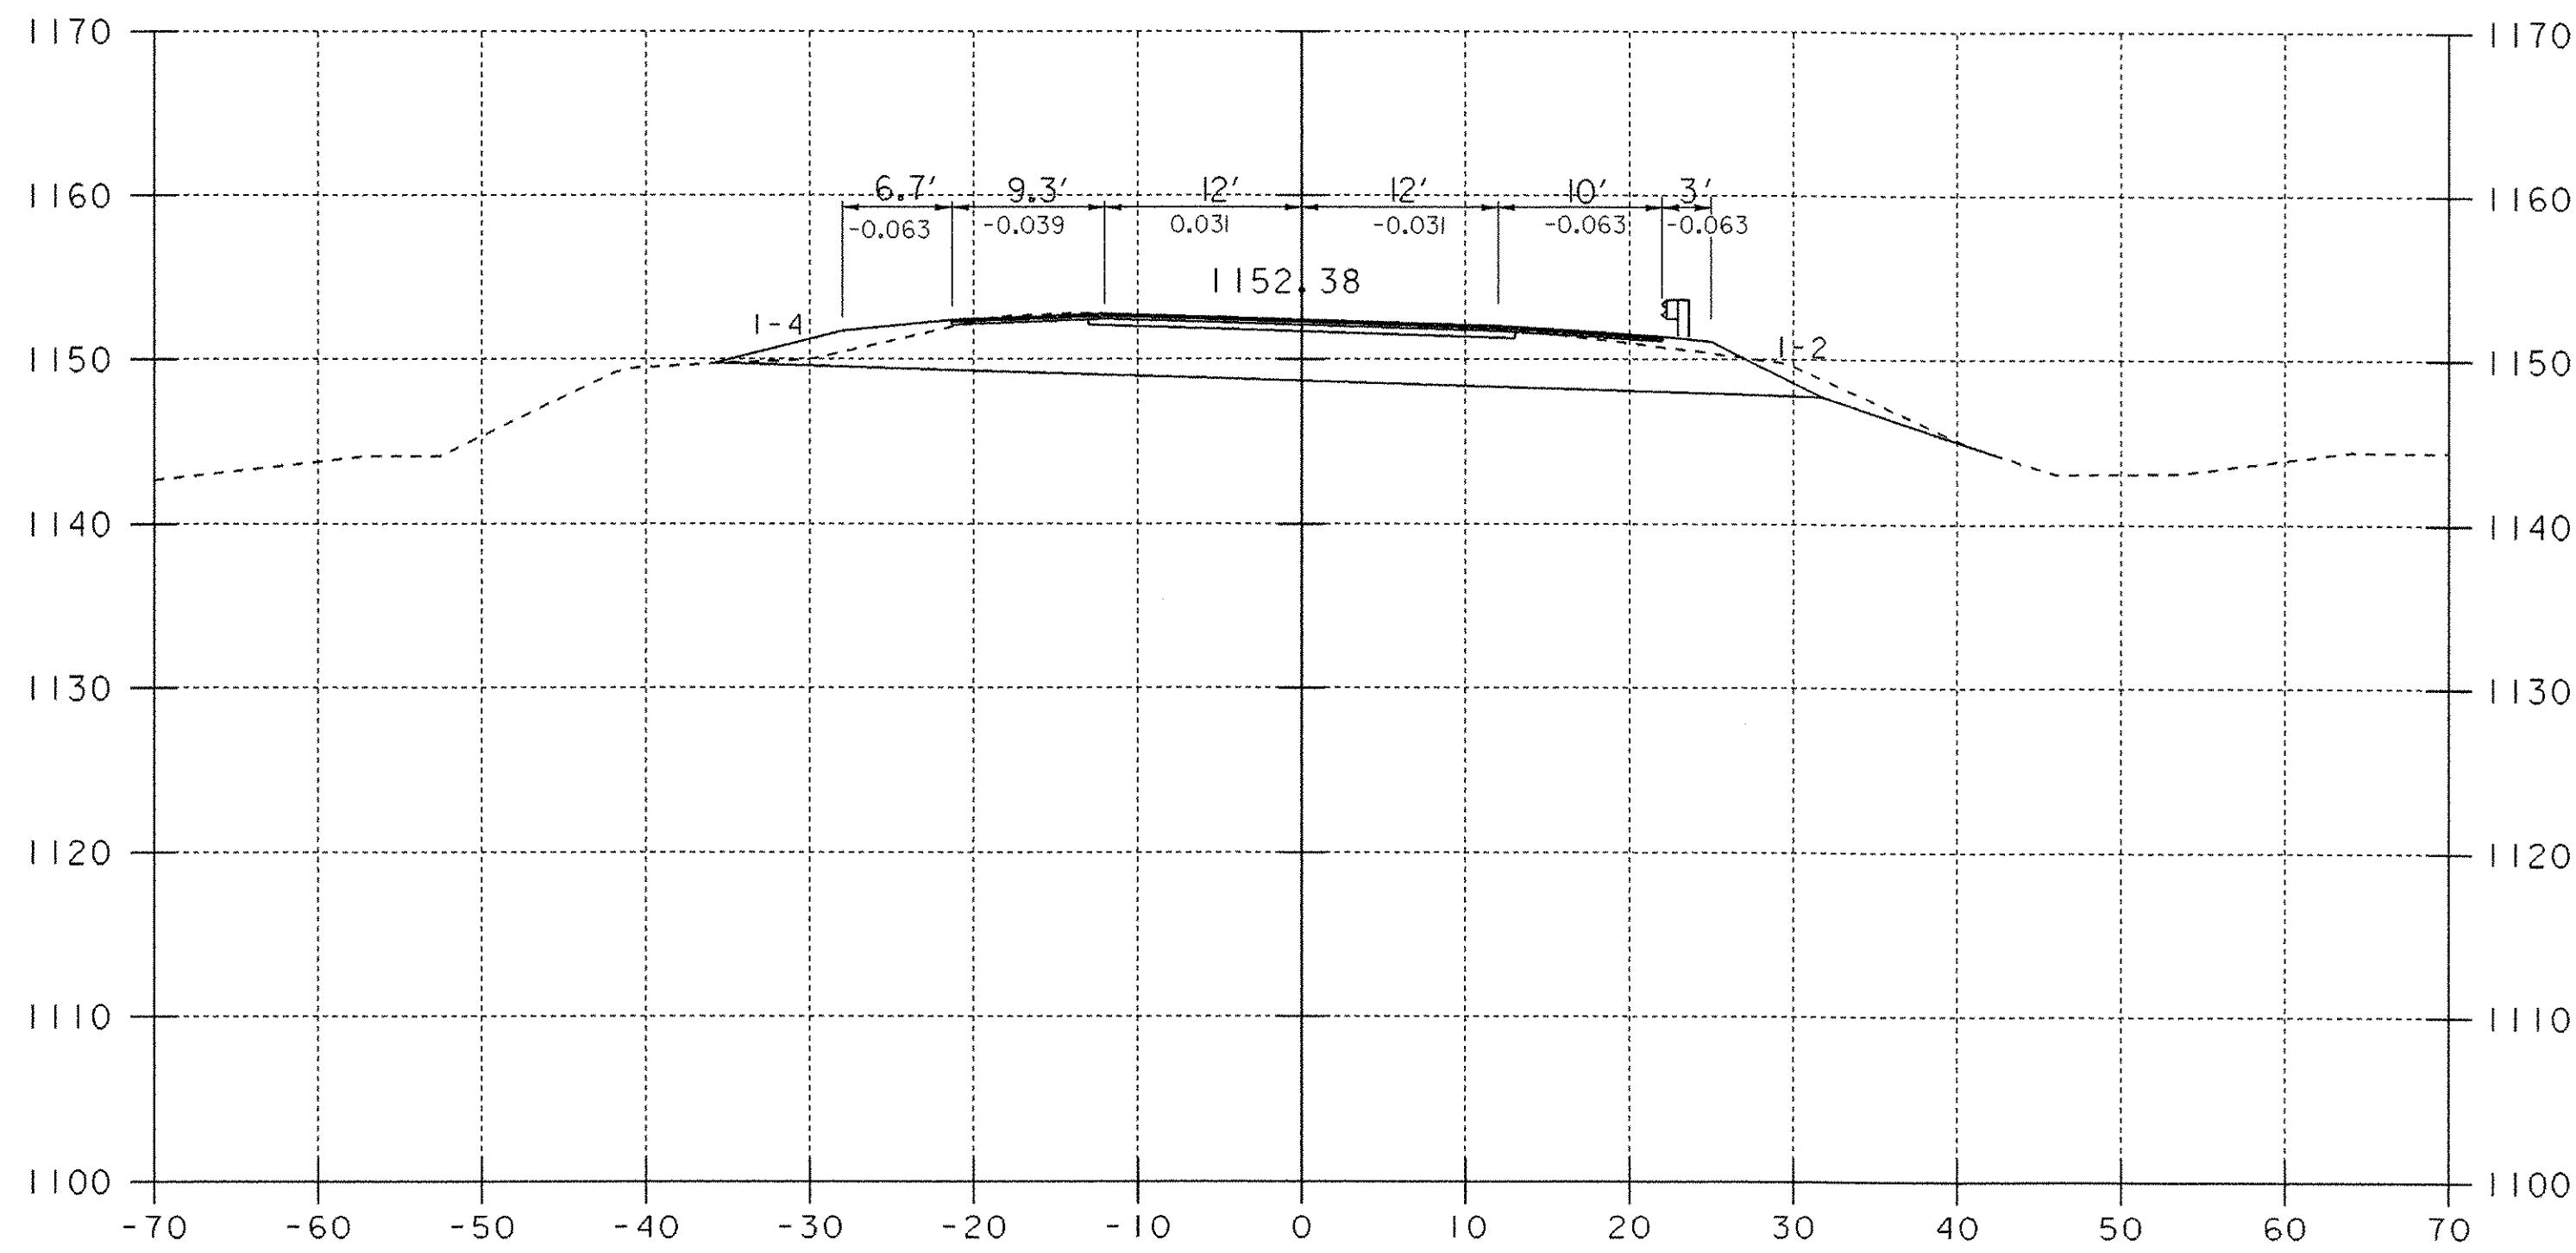


**70+00**

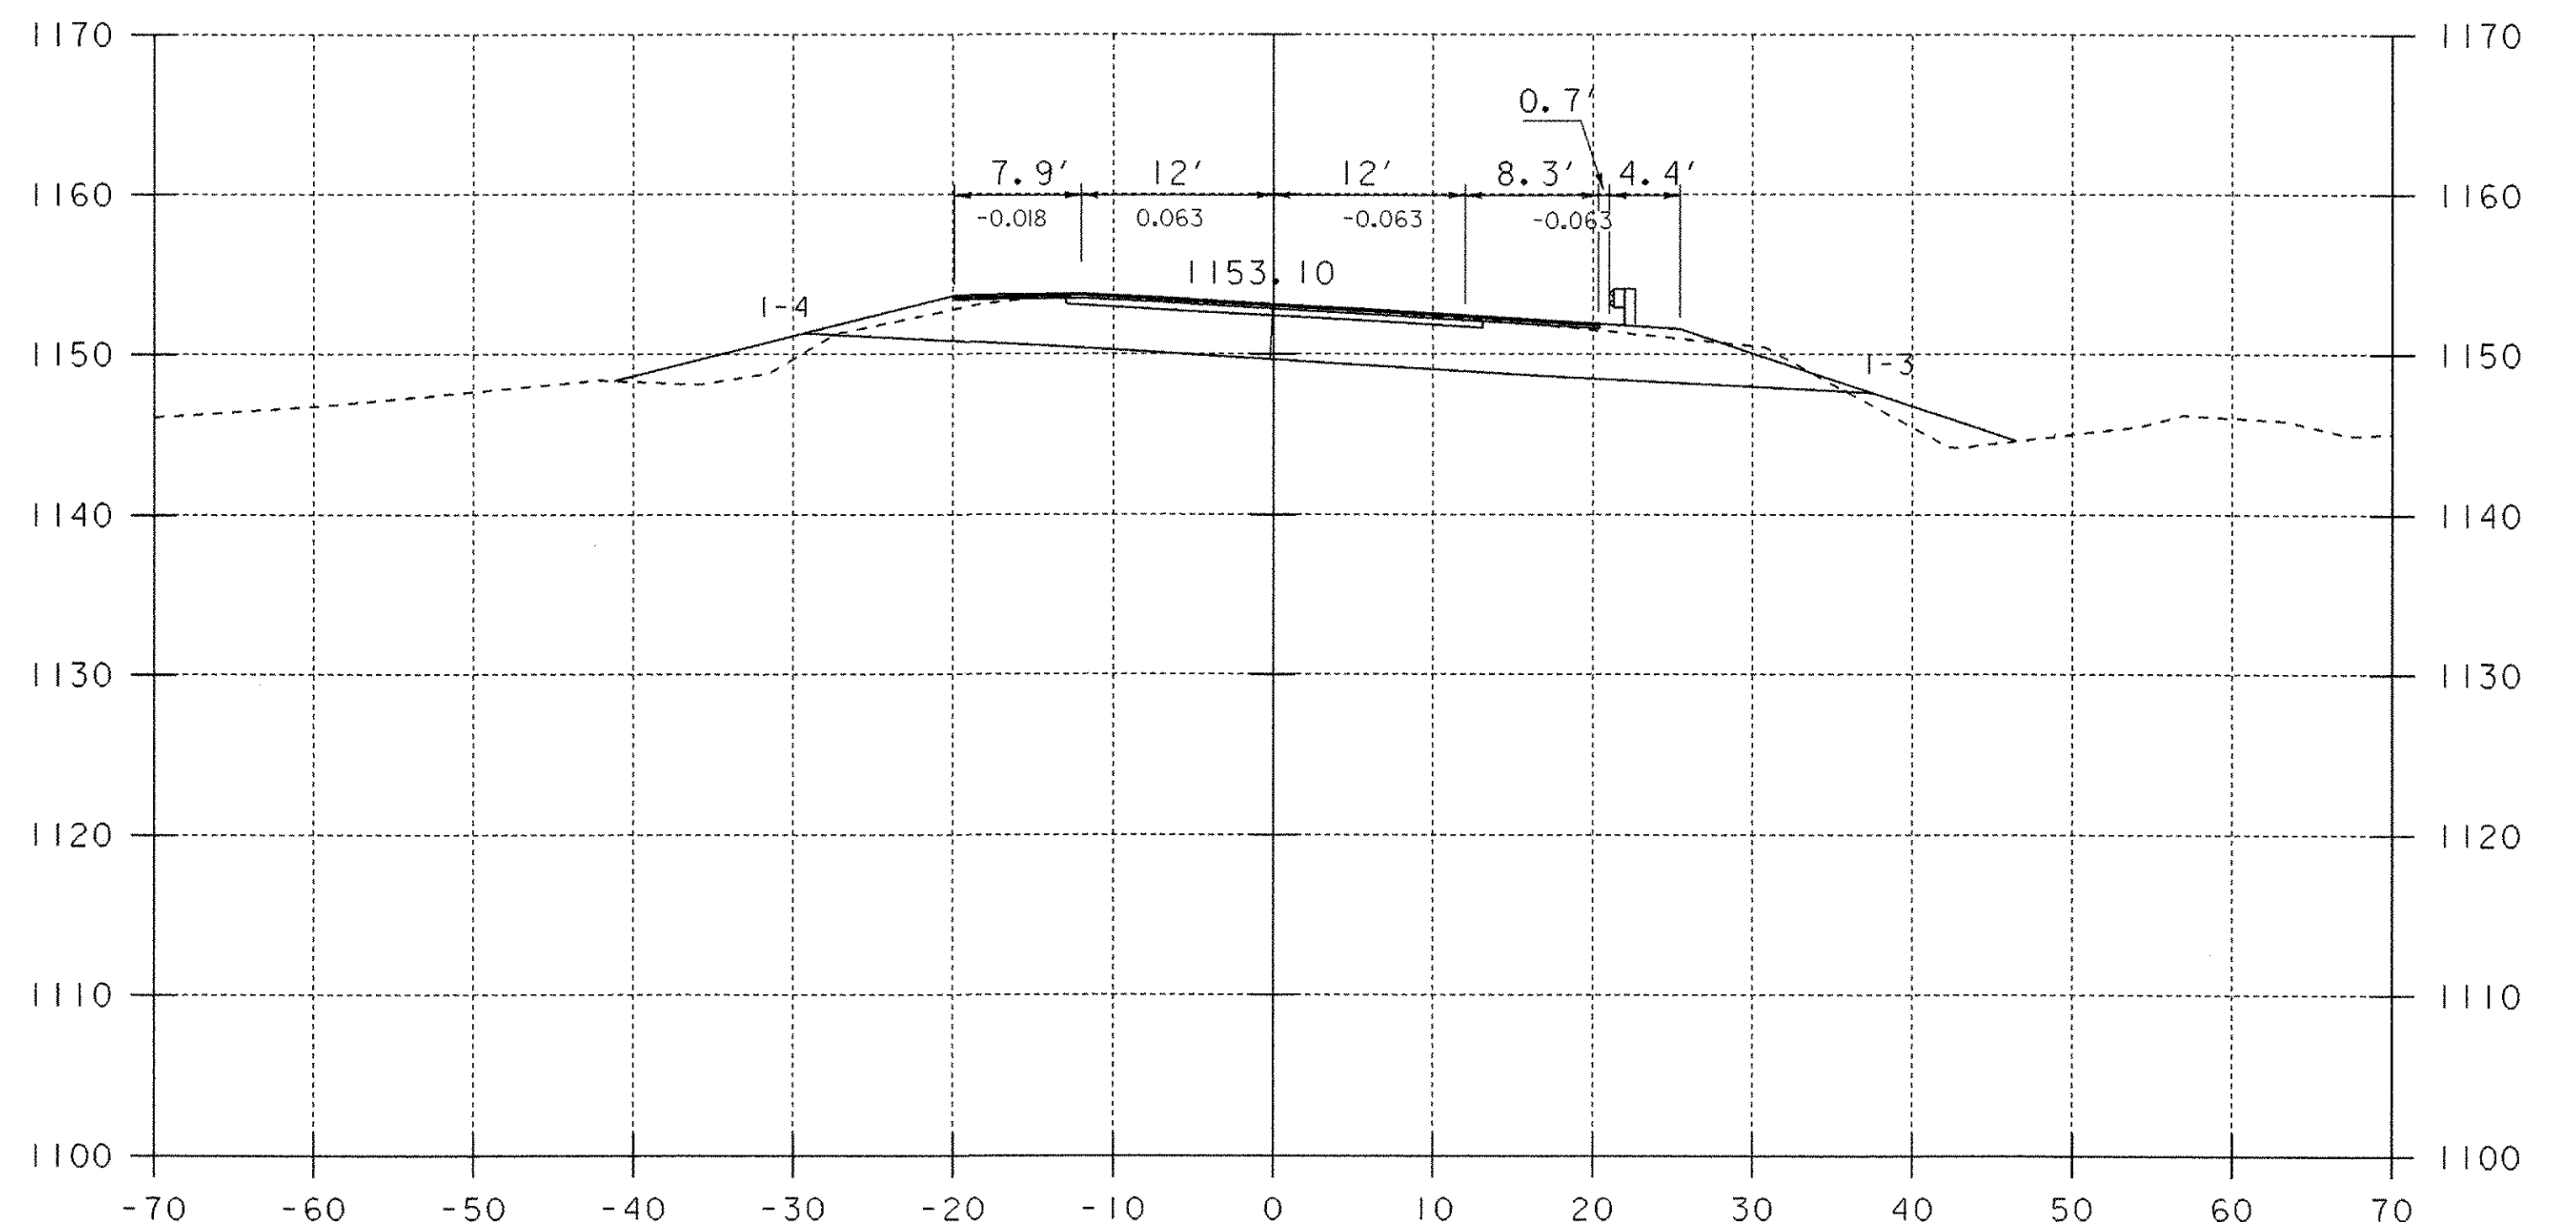

**70+63**

**70+00 - 70+50**

<b>DATUM</b>	NGVD 1929
VERTICAL	
HORIZONTAL	N/A

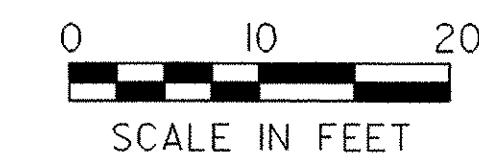

PROJECT: <b>WOODFORD</b>	PROJECT NO. : BHF 010-(29)
DESIGN FILE NAME: /84e039/de039xs.dgn	PLOT DATE: 03-OCT-2005
IPARM FILE NAME: de039x10.1	SURVEY DATE: 12-88
SURVEYED BY: MOREAU	DRAWN BY: EVANS-MONGEON
SQUAD LEADER: PORTALUPI	SHEET: 95 OF 106