


71+00 - 72+12

DATUM
 VERTICAL NGVD 1929
 HORIZONTAL N/A

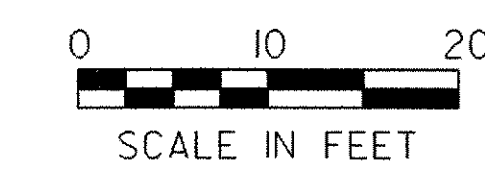

PROJECT: WOODFORD	PROJECT NO.: BHF 010-1(29)
DESIGN FILE NAME: /84e039/de039xs.dgn	PLOT DATE: 03-OCT-2005
IPARM FILE NAME: de039x11.1	SURVEY DATE: 12-88
SURVEYED BY: MOREAU	DRAWN BY: EVANS-MONGEON
SQUAD LEADER: PORTALUPI	SHEET: 96 OF 106