




73+00

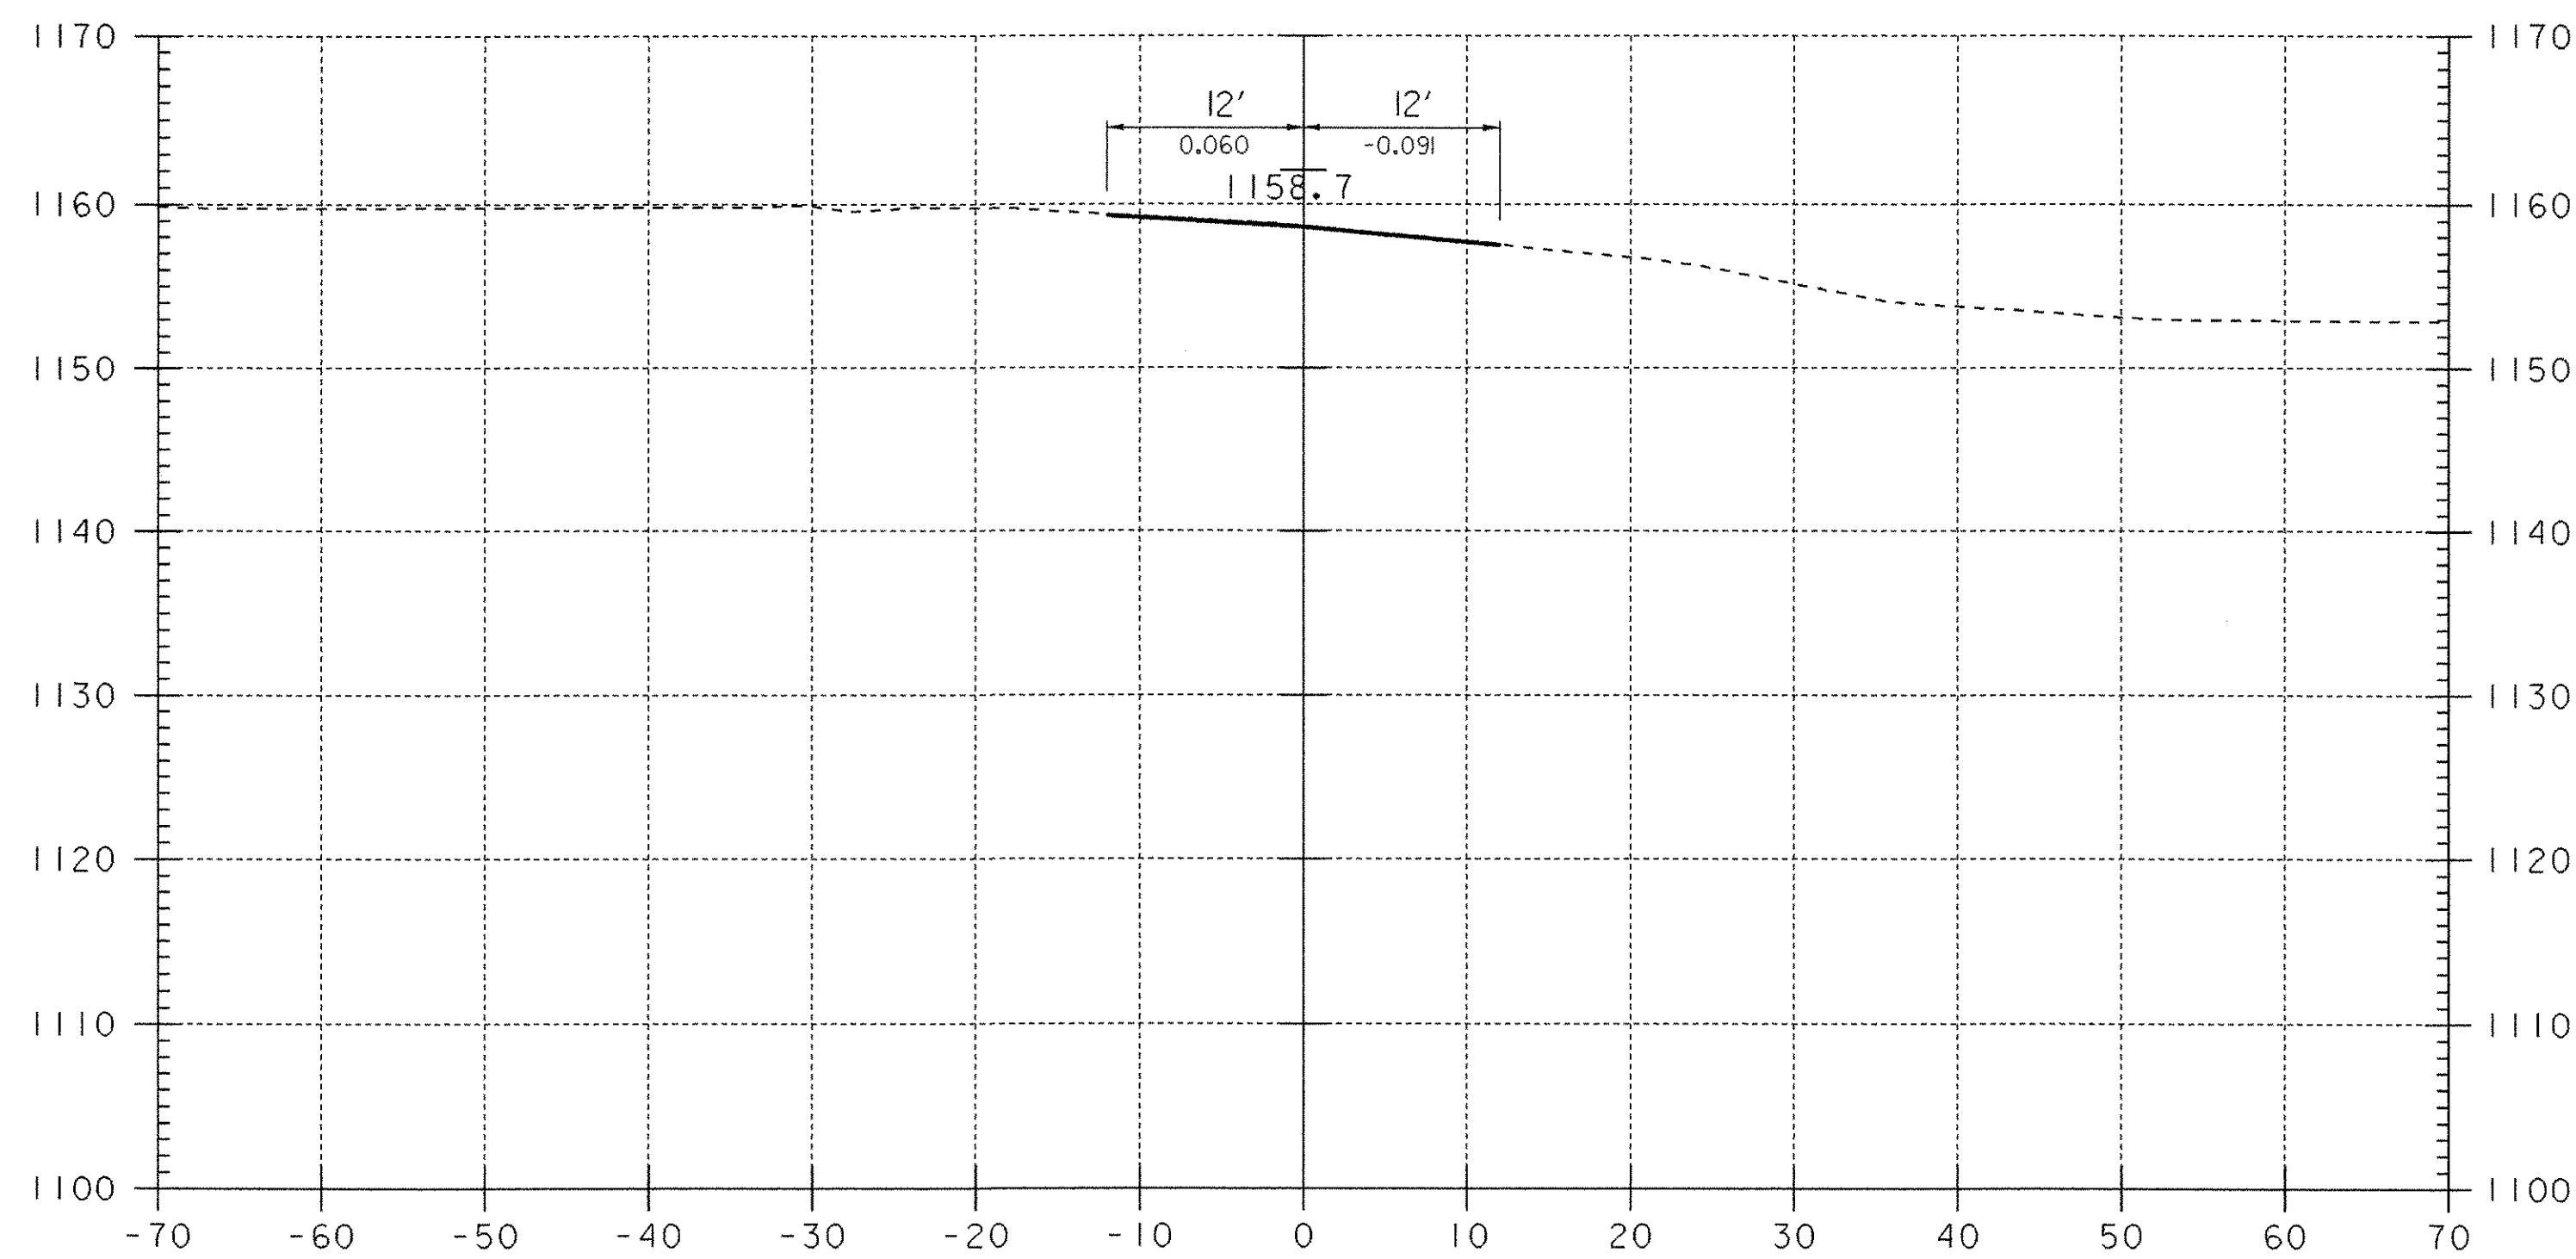

74+00
End Approach

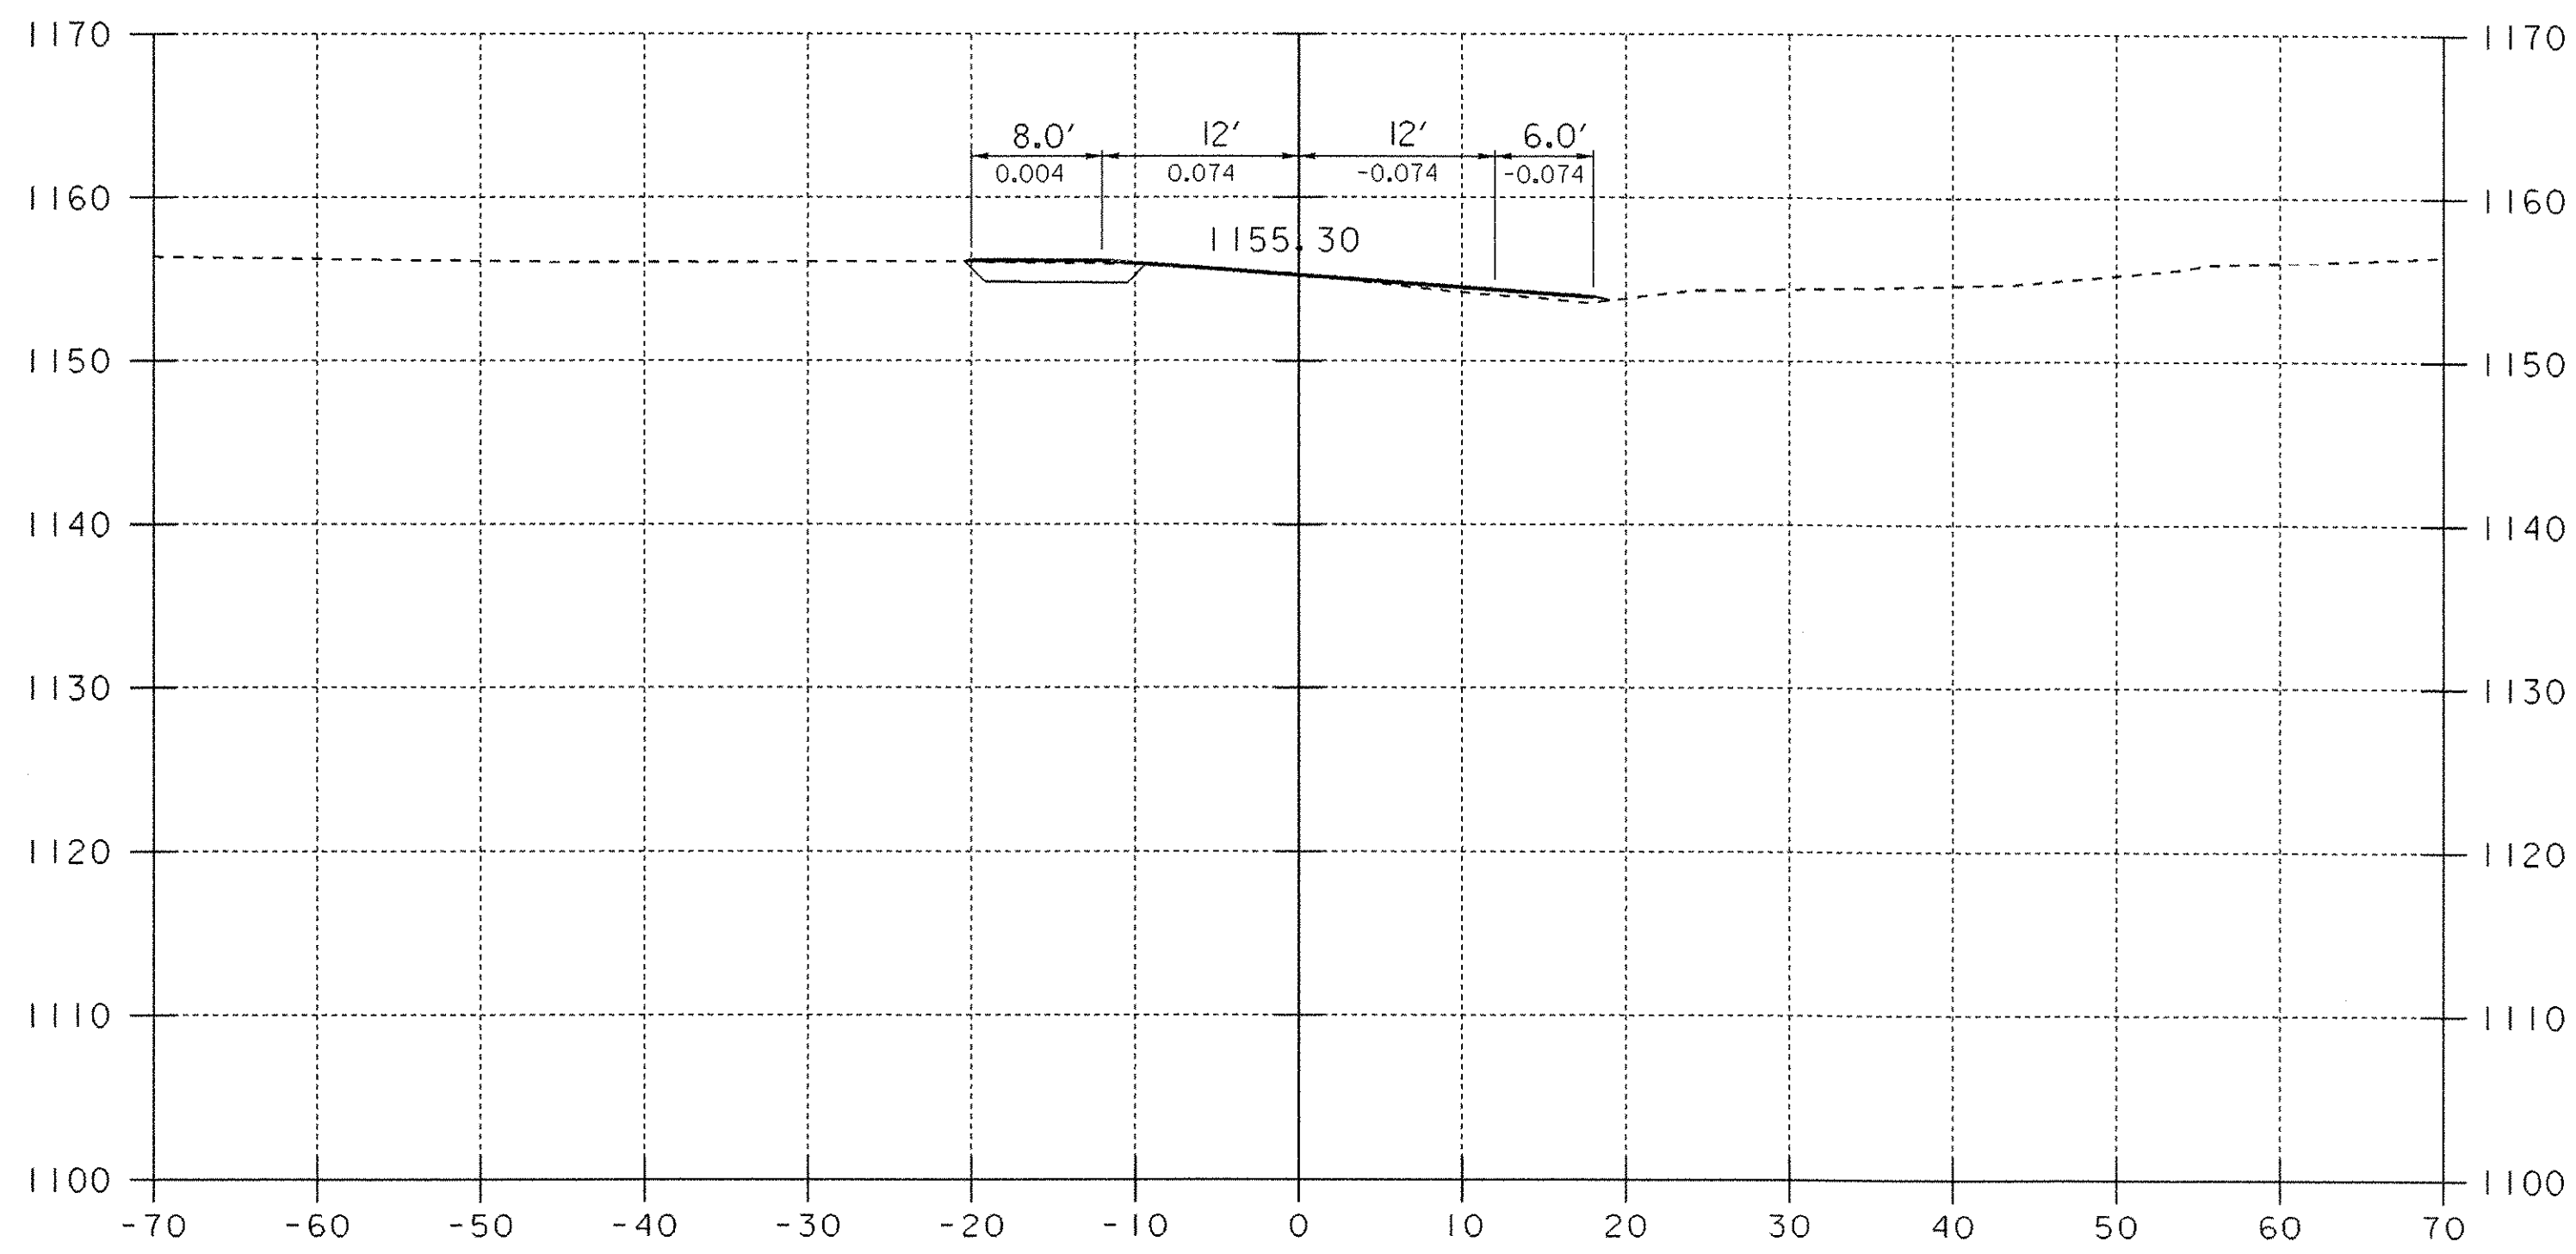

72+50

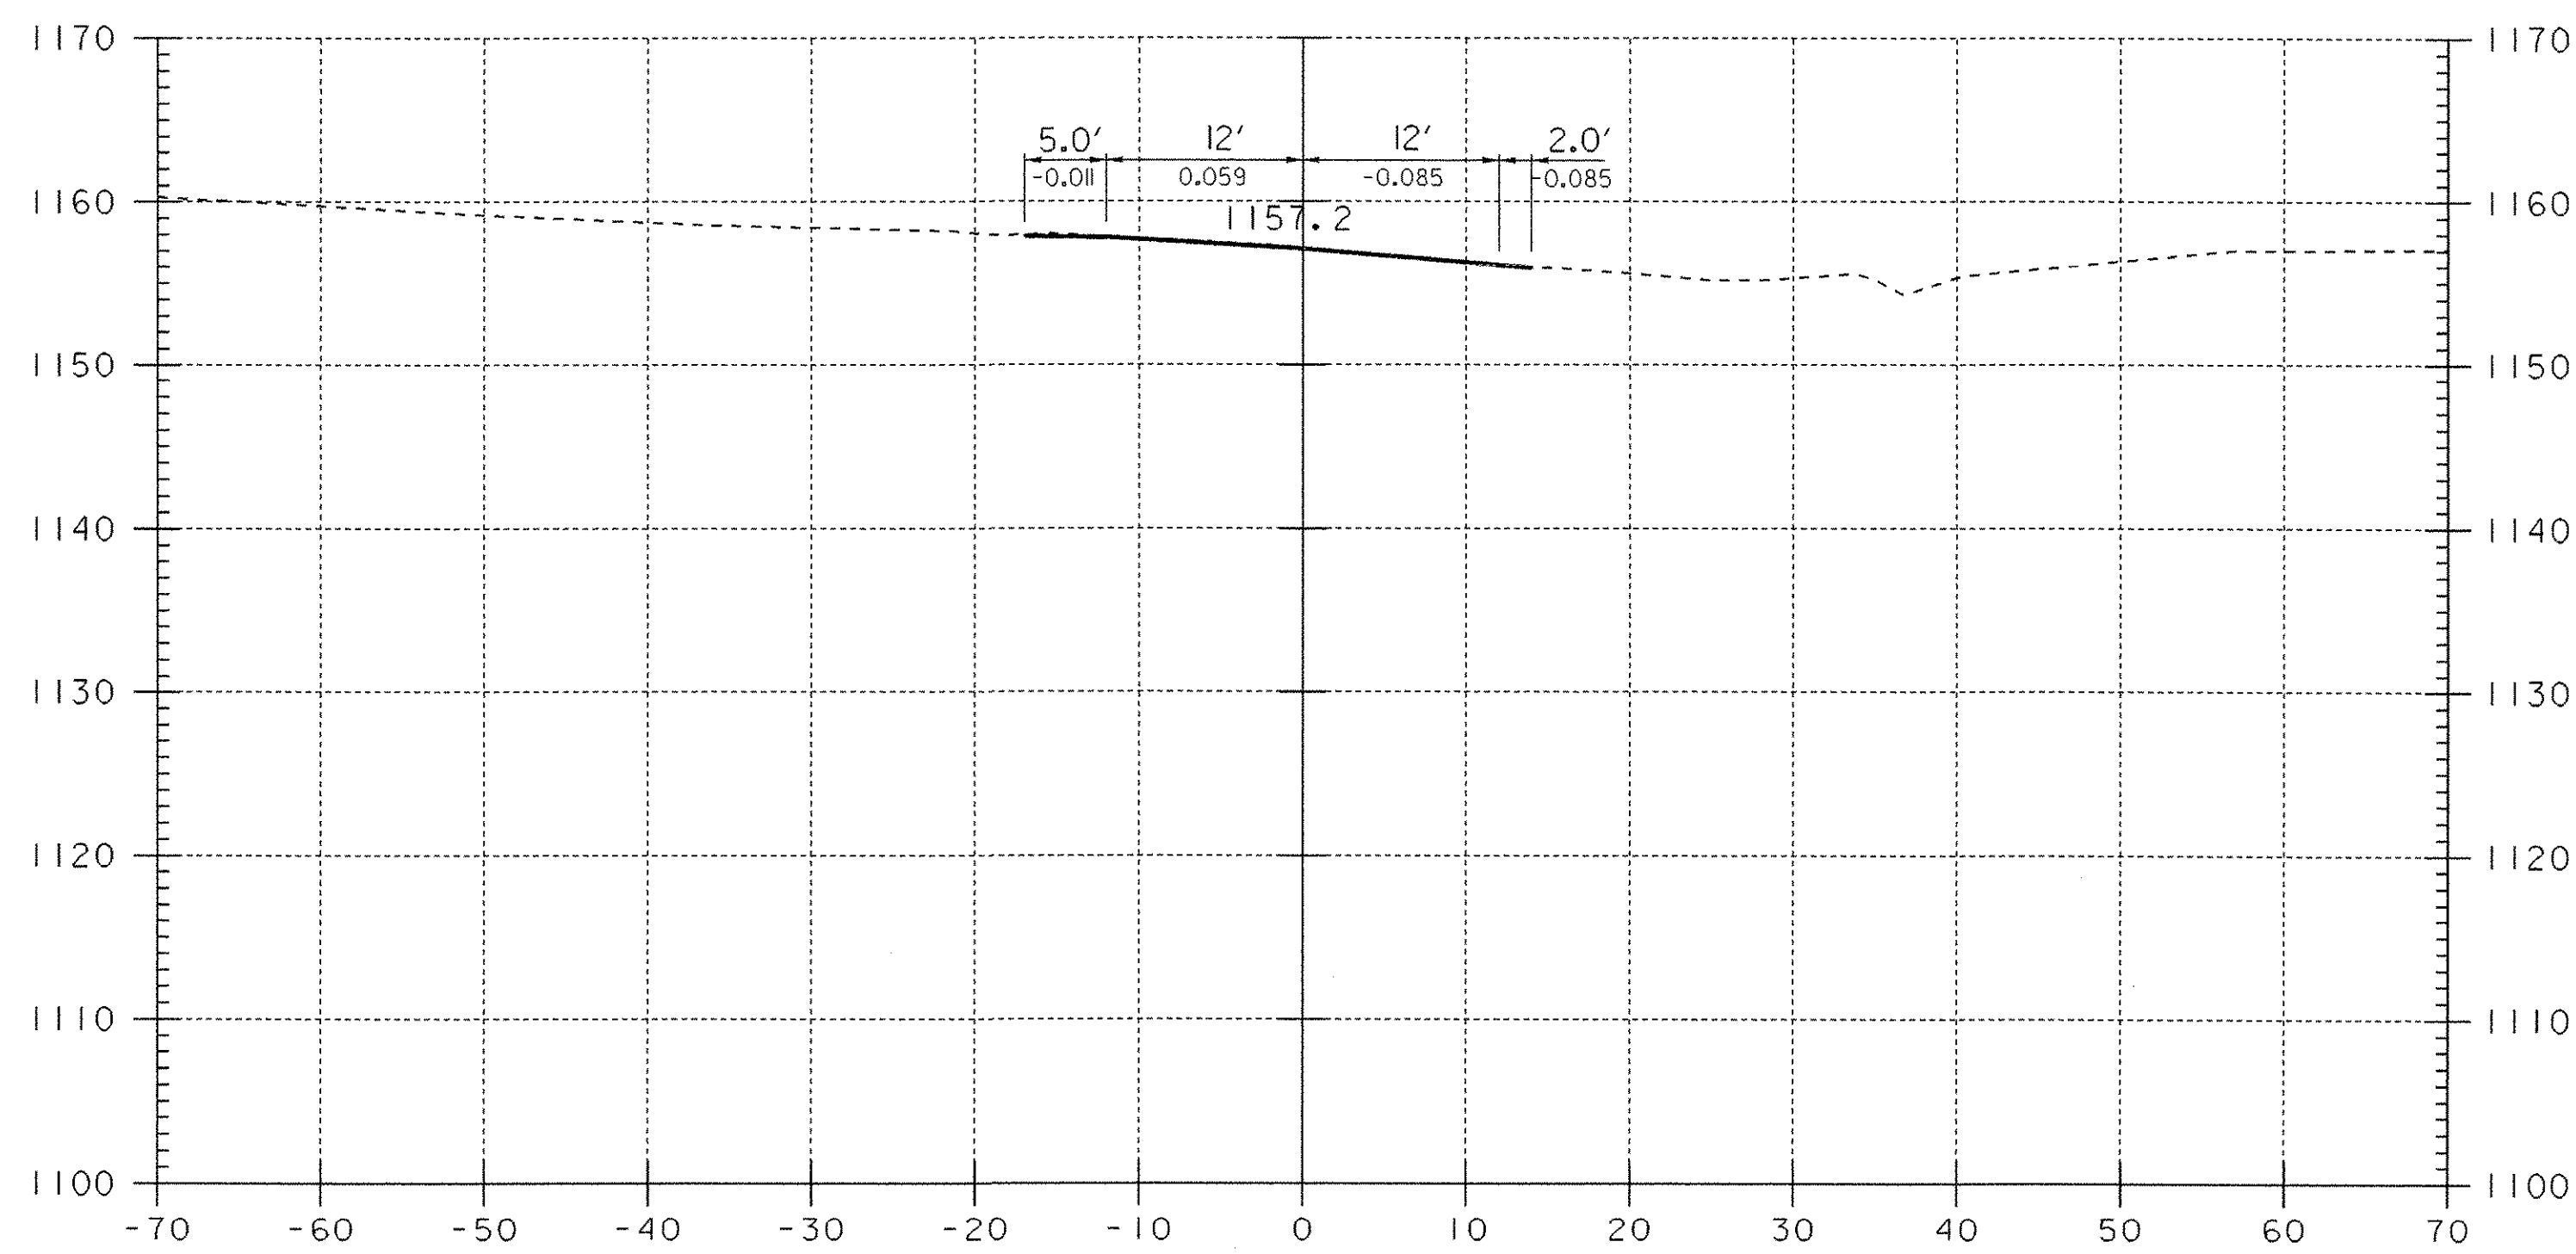

73+50

72+50 - 73+00

DATUM	
VERTICAL	NGVD 1929
HORIZONTAL	N/A



PROJECT: WOODFORD	PROJECT NO.: BHF 010-K(29)
DESIGN FILE NAME: /84e039/de039xs.dgn	PLOT DATE: 03-OCT-2005
IPARM FILE NAME: de039x12.i	SURVEY DATE: 12-88
SURVEYED BY: MOREAU	DRAWN BY: EVANS-MONGEON
SQUAD LEADER: PORTALUPI	SHEET: 97 OF 106