




0+40

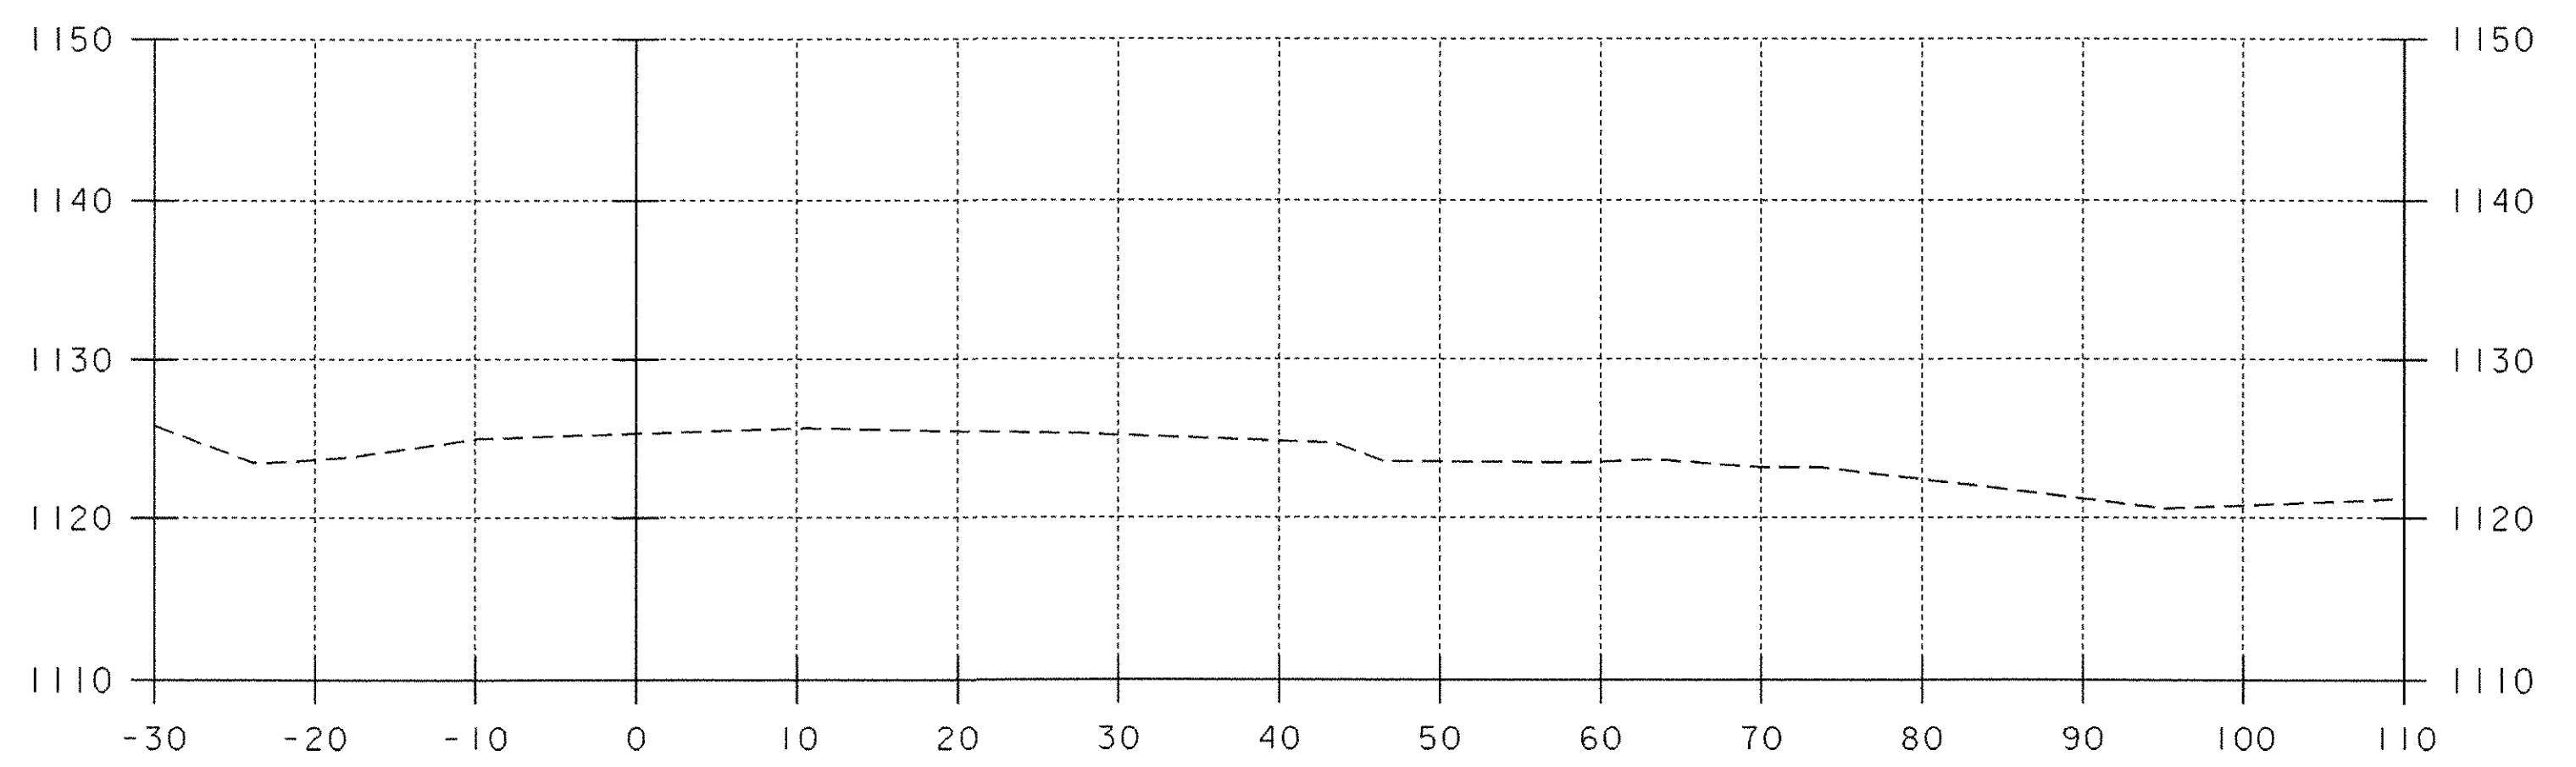


1+00

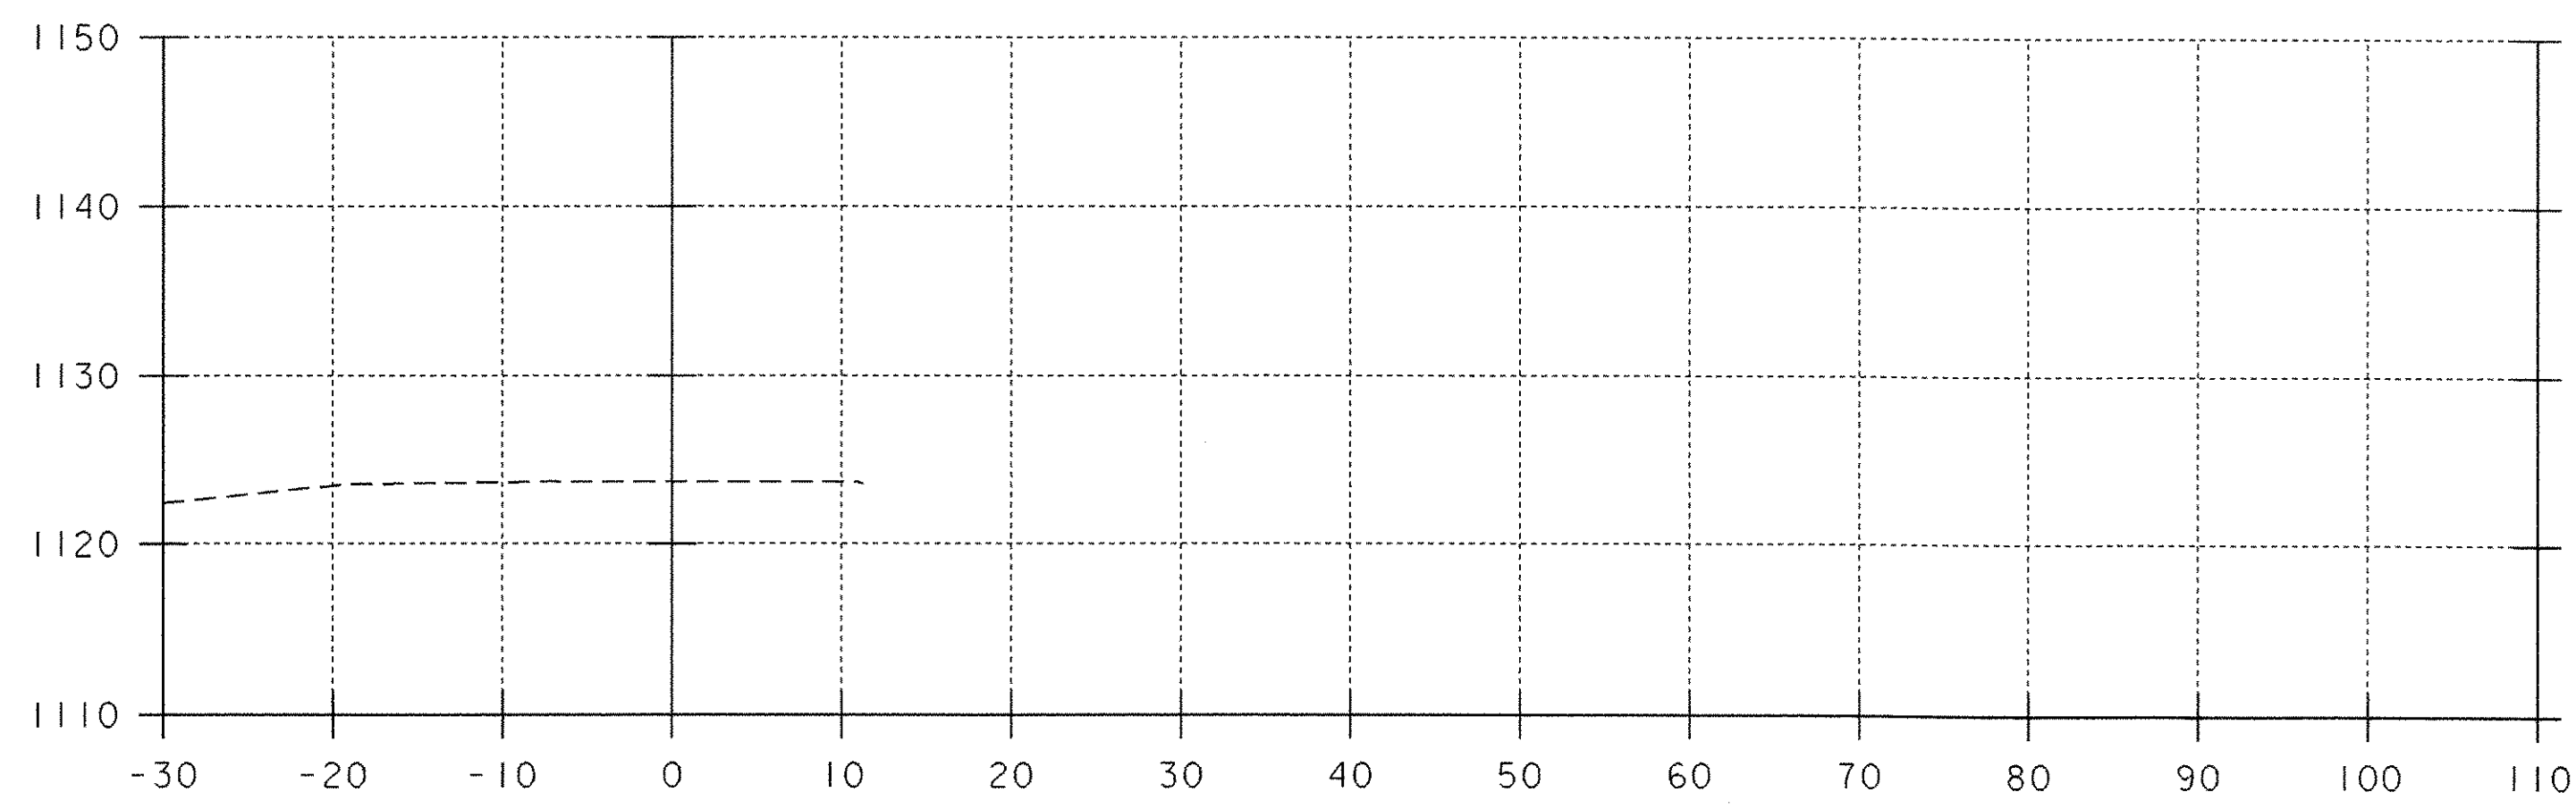


0+20

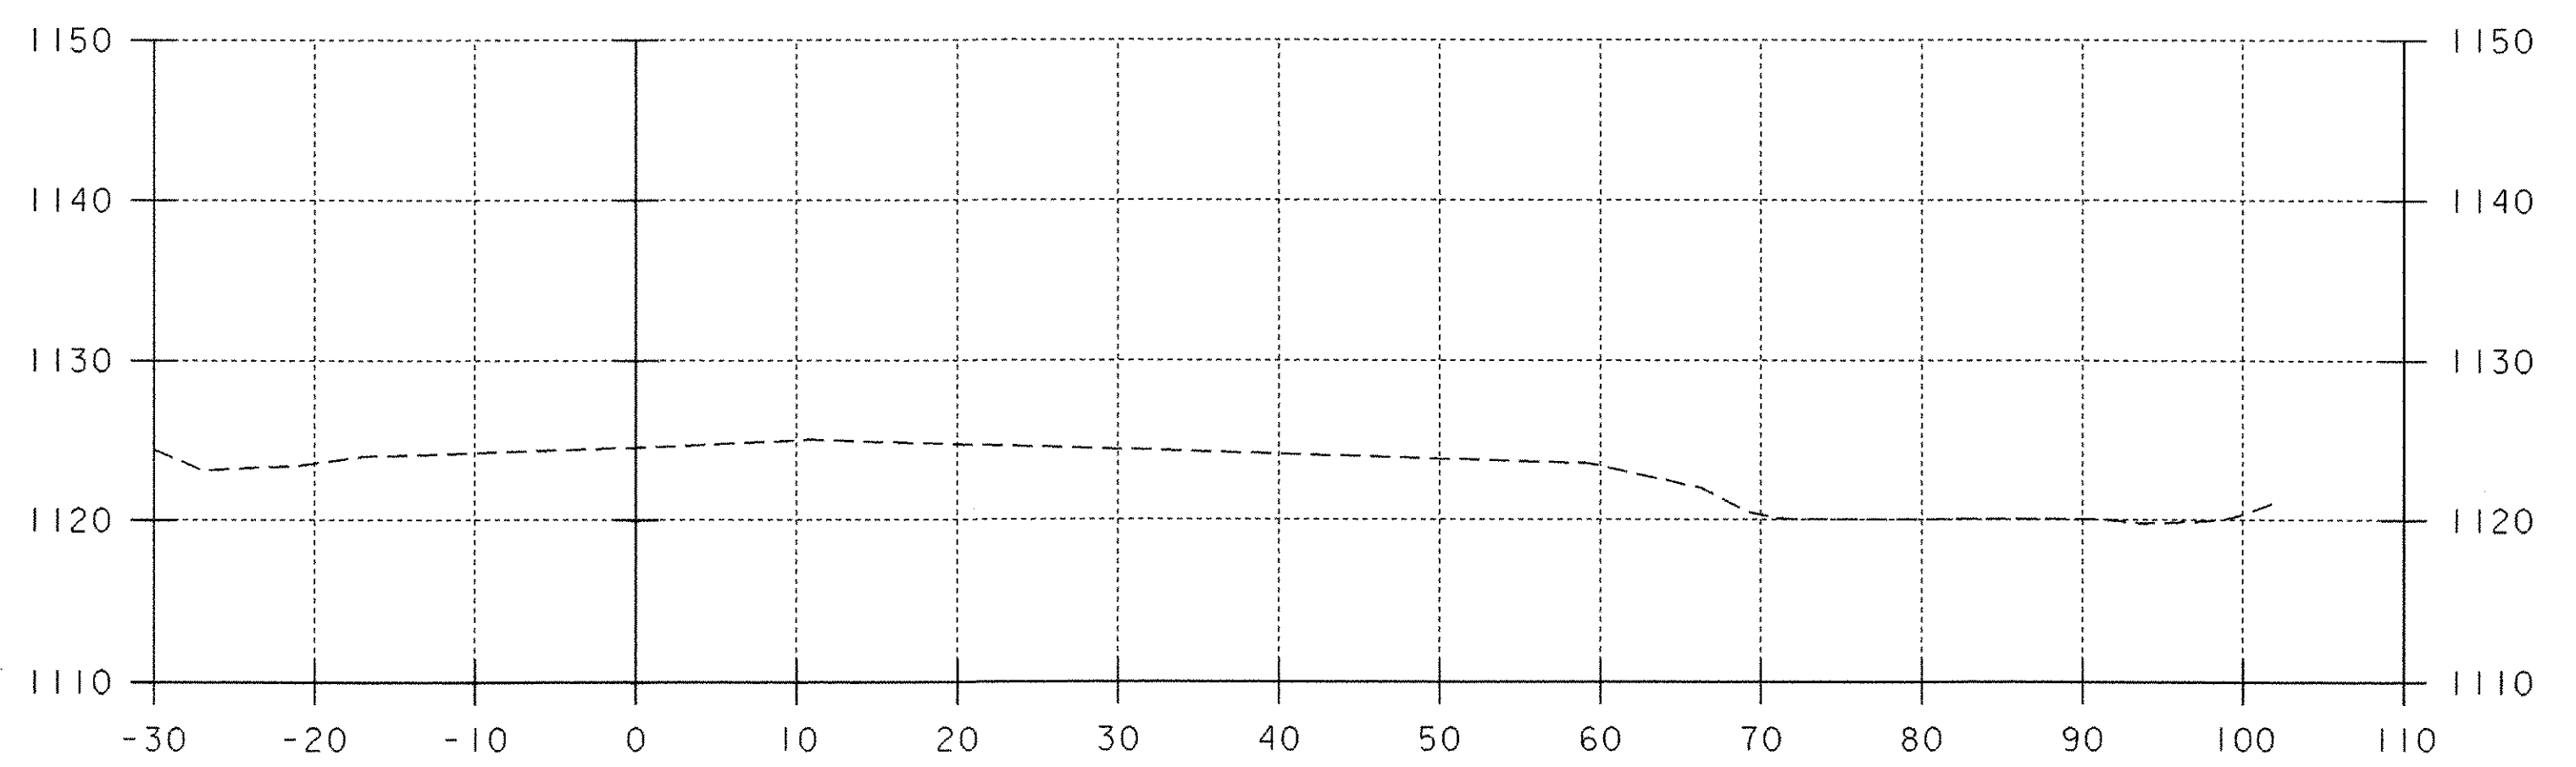

0+80

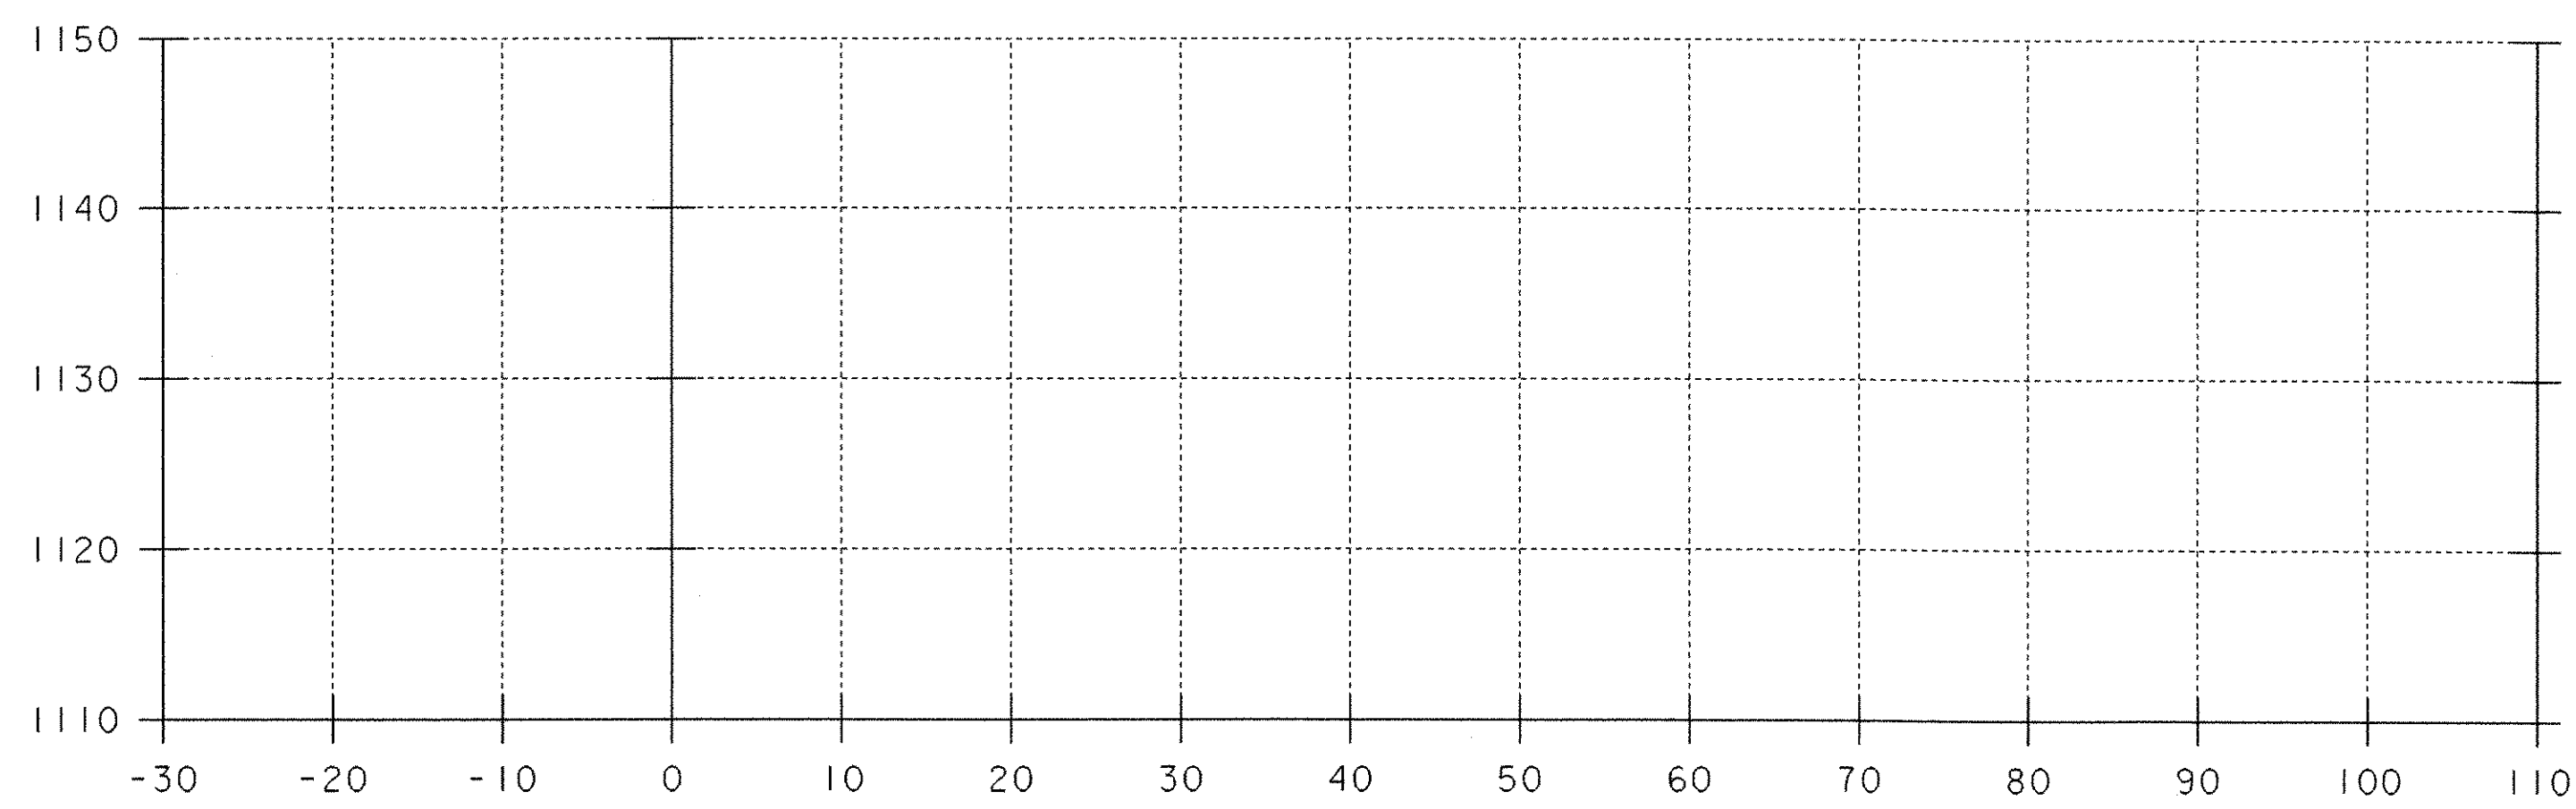


0+00

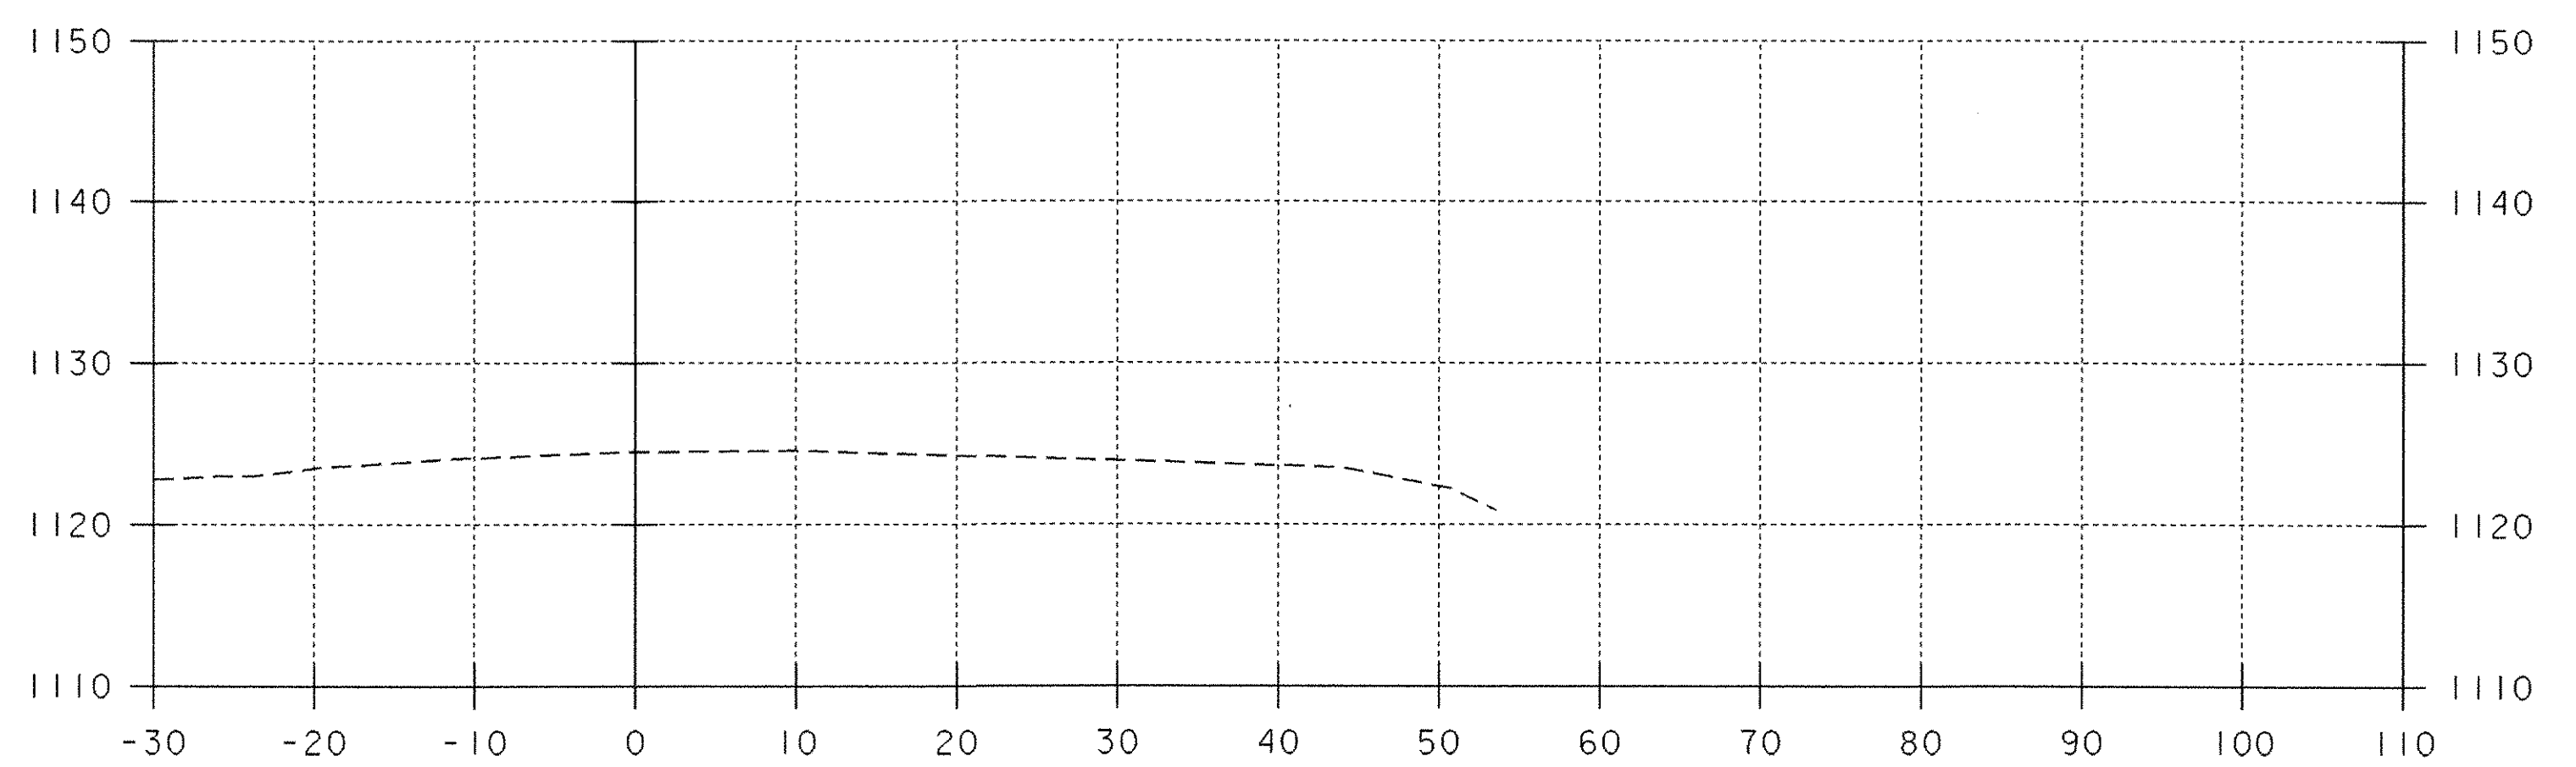

0+60

CHANNEL CROSS SECTIONS 0+00 ~ 1+00

DATUM
 VERTICAL NGVD 1929
 HORIZONTAL N/A

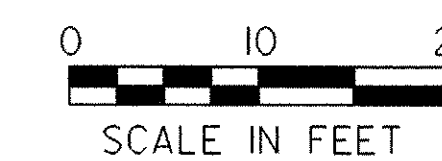

PROJECT: WOODFORD	PROJECT NO.: BHF 010-1(29)
DESIGN FILE NAME: /84e039/se039xs.dgn	PLOT DATE: 03-OCT-2005
IPARM FILE NAME: se039cx.l1	SURVEY DATE: 12-88
SURVEYED BY: MOREAU	DRAWN BY: EVANS-MONGEON
SQUAD LEADER: A. PORTALUPI	SHEET: 99 OF 106