


**CHANNEL CROSS SECTIONS 2+40 ~ 2+80**

**DATUM**  
 VERTICAL NGVD 1929  
 HORIZONTAL N/A

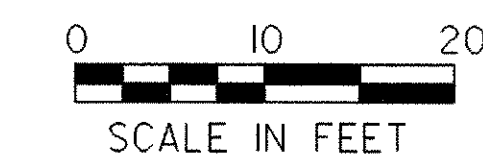

PROJECT: WOODFORD	PROJECT NO.: BHF 010-1(29)
DESIGN FILE NAME: /84e039/se039xs.dgn	PLOT DATE: 03-OCT-2005
IPARM FILE NAME: se039cx4.i	SURVEY DATE: 12-88
SURVEYED BY: MOREAU	DRAWN BY: EVANS-MONGEON
SQUAD LEADER: A. PORTALUPI	SHEET: 102 OF 106