



STA. 3+08 LEFT
 END UNCLASSIFIED CHANNEL EXCAVATION
 END GRANULAR BACKFILL FOR STRUCTURES
 END GRUBBING MATERIAL
 END GEOTEXTILE UNDER STONE FILL

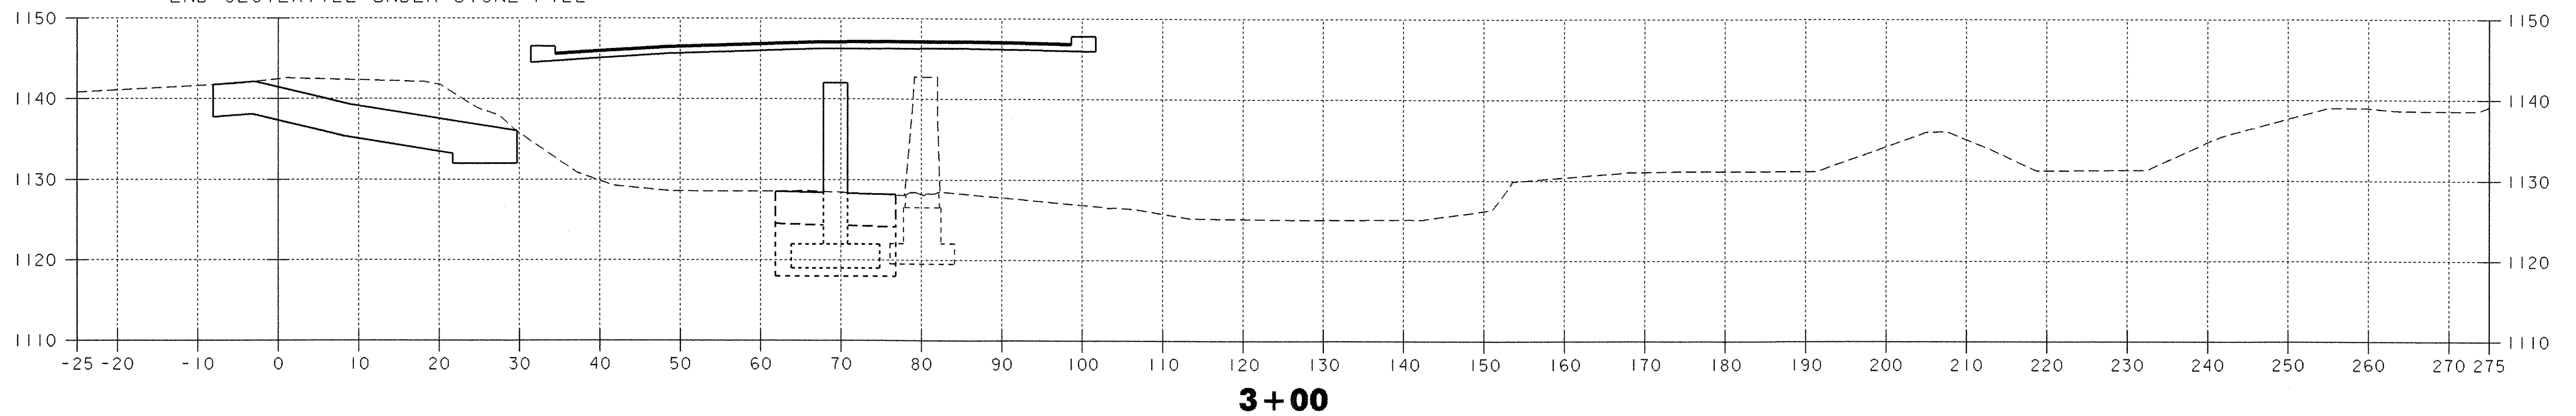

CHANNEL CROSS SECTIONS 3+00 ~ 3+40

DATUM
 VERTICAL NGVD 1929
 HORIZONTAL N/A

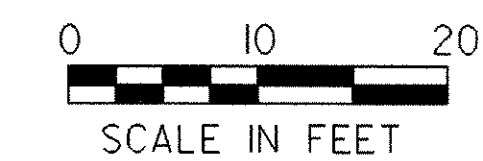

PROJECT: WOODFORD	PROJECT NO.: BHF 010-1(29)
DESIGN FILE NAME: /84e039/se039xs.dgn	PLOT DATE: 03-OCT-2005
IPARM FILE NAME: se039cx5.i	SURVEY DATE: 12-88
SURVEYED BY: MOREAU	DRAWN BY: EVANS-MONGEON
SQUAD LEADER: A. PORTALUPI	SHEET: 103 OF 106