



4+00

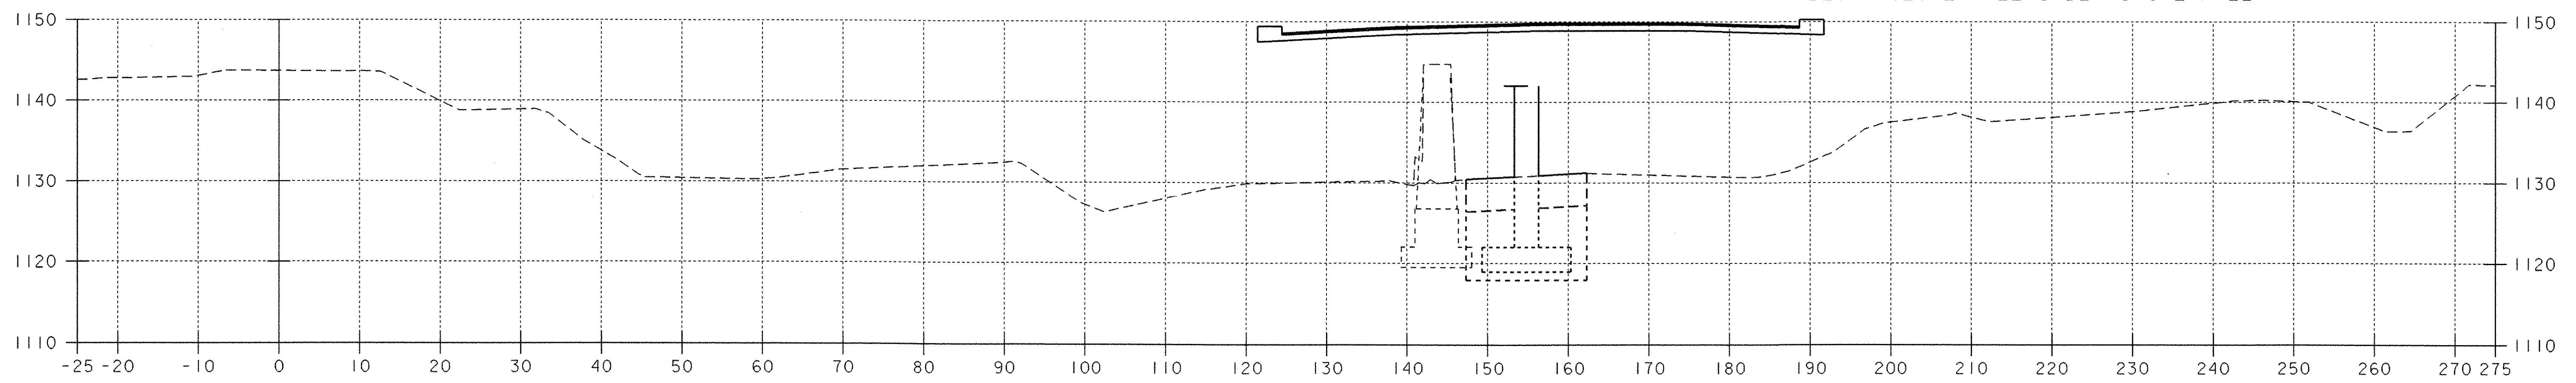


3+80

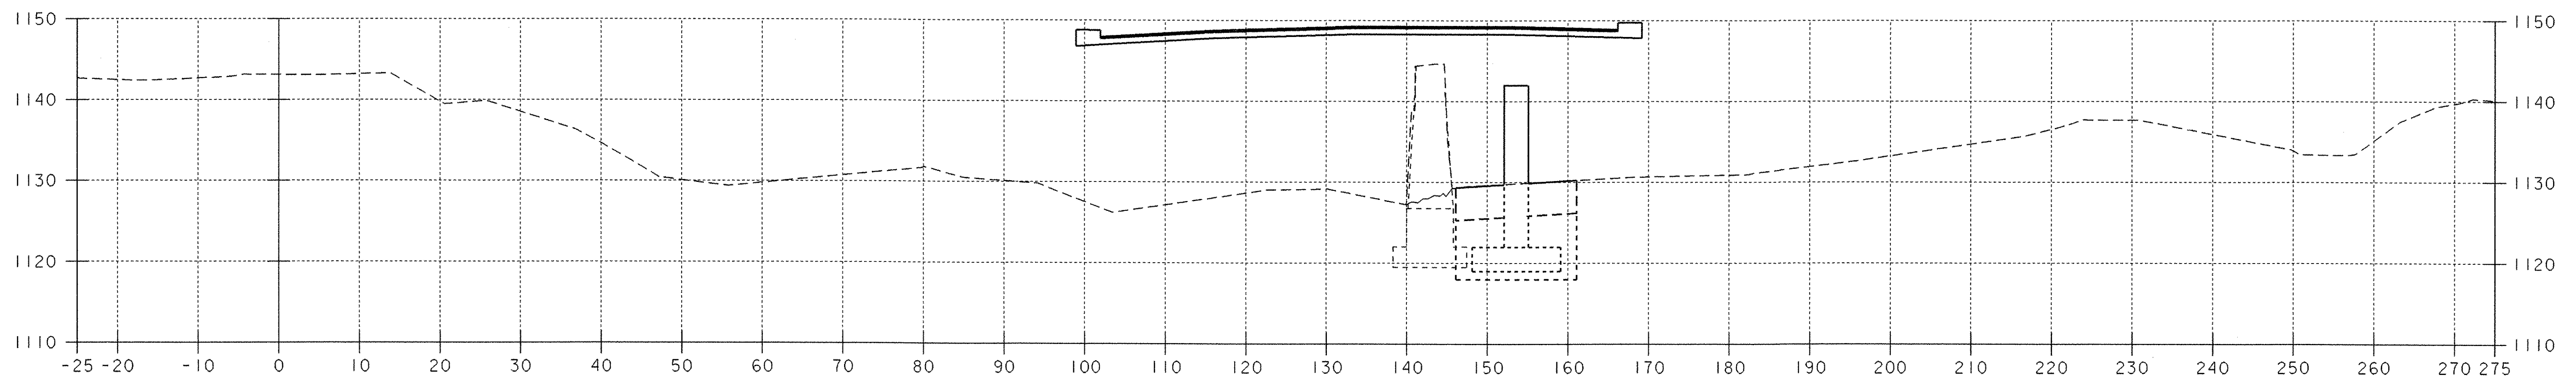

3+60

CHANNEL CROSS SECTIONS 3+60 ~ 4+00

DATUM
 VERTICAL NGVD 1929
 HORIZONTAL N/A

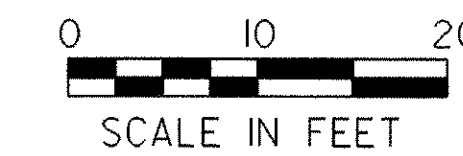

PROJECT: WOODFORD	PROJECT NO.: BHF 010-1(29)
DESIGN FILE NAME: /84e039/se039xs.dgn	PLOT DATE: 03-OCT-2005
IPARM FILE NAME: se039cx6.1	SURVEY DATE: 12-88
SURVEYED BY: MOREAU	DRAWN BY: EVANS-MONGEON
SQUAD LEADER: A. PORTALUPI	SHEET: 104 OF 106