


CHANNEL CROSS SECTIONS 4+20 ~ 4+60

DATUM
 VERTICAL NGVD 1929
 HORIZONTAL N/A

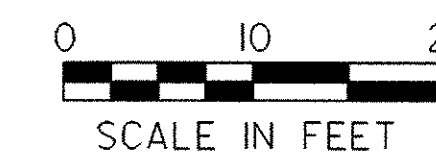

PROJECT: WOODFORD	PROJECT NO.: BHF 010-1(29)
DESIGN FILE NAME: /84e039/ee039xs.dgn	PLOT DATE: 03-OCT-2005
IPARM FILE NAME: ee039cx7.1	SURVEY DATE: 12-88
SURVEYED BY: MOREAU	DRAWN BY: EVANS-MONGEON
SQUAD LEADER: A. PORTALUPI	SHEET: 105 OF 106