


5+00


STA. 4+90 RIGHT
 END UNCLASSIFIED CHANNEL EXCAVATION
 END GRANULAR BACKFILL FOR STRUCTURES
 END GRUBBING MATERIAL
 END GEOTEXTILE UNDER STONE FILL

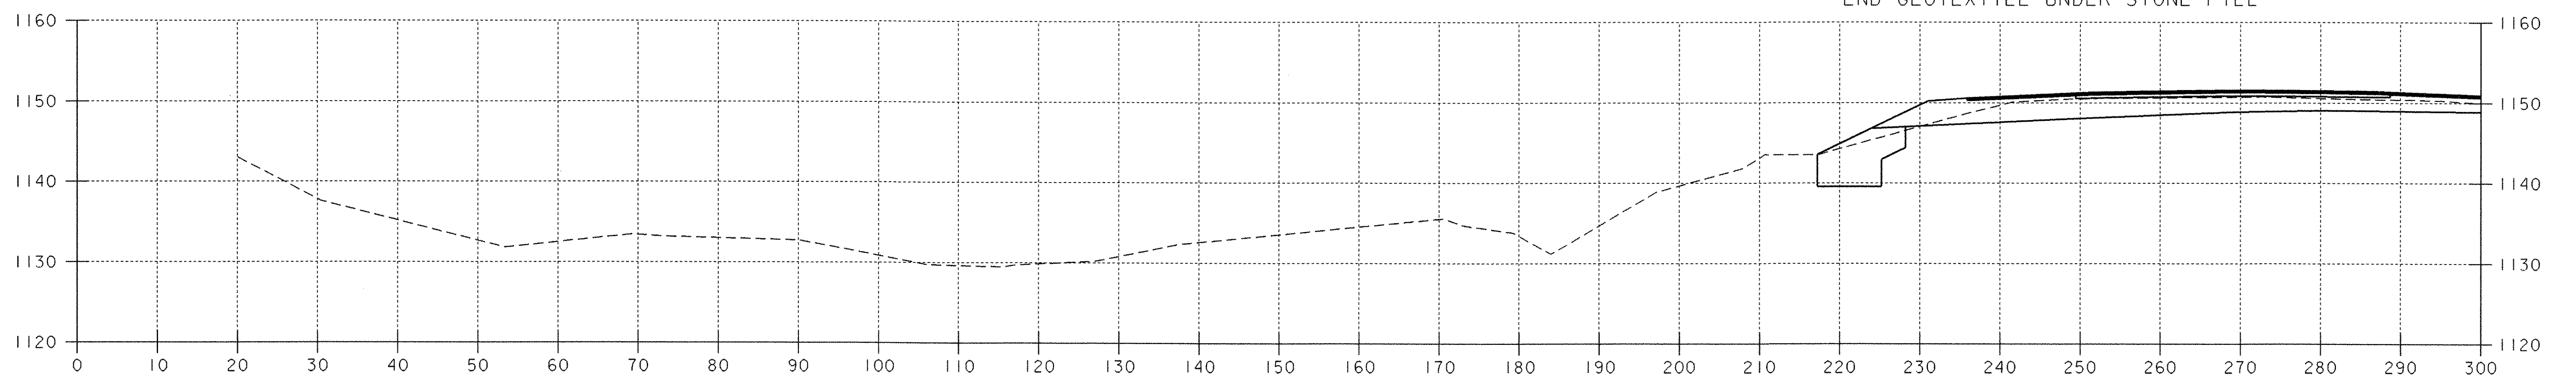

4+80

CHANNEL CROSS SECTIONS 4+80 ~ 5+00

DATUM
 VERTICAL NGVD 1929
 HORIZONTAL N/A

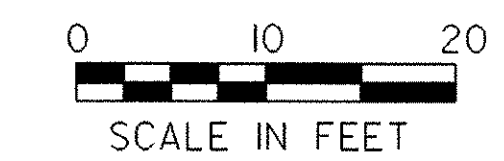

| | |
|---------------------------------------|-------------------------------|
| PROJECT: WOODFORD | PROJECT NO.: BHF 010-1(29) |
| DESIGN FILE NAME: /84e039/se039xs.dgn | PLOT DATE: 03-OCT-2005 |
| IPARM FILE NAME: se039cx8.i | SURVEY DATE: 12-88 |
| SURVEYED BY: MOREAU | DRAWN BY: EVANS-MONGEON |
| SQUAD LEADER: A. PORTALUPI | SHEET: 106 OF 106 |