

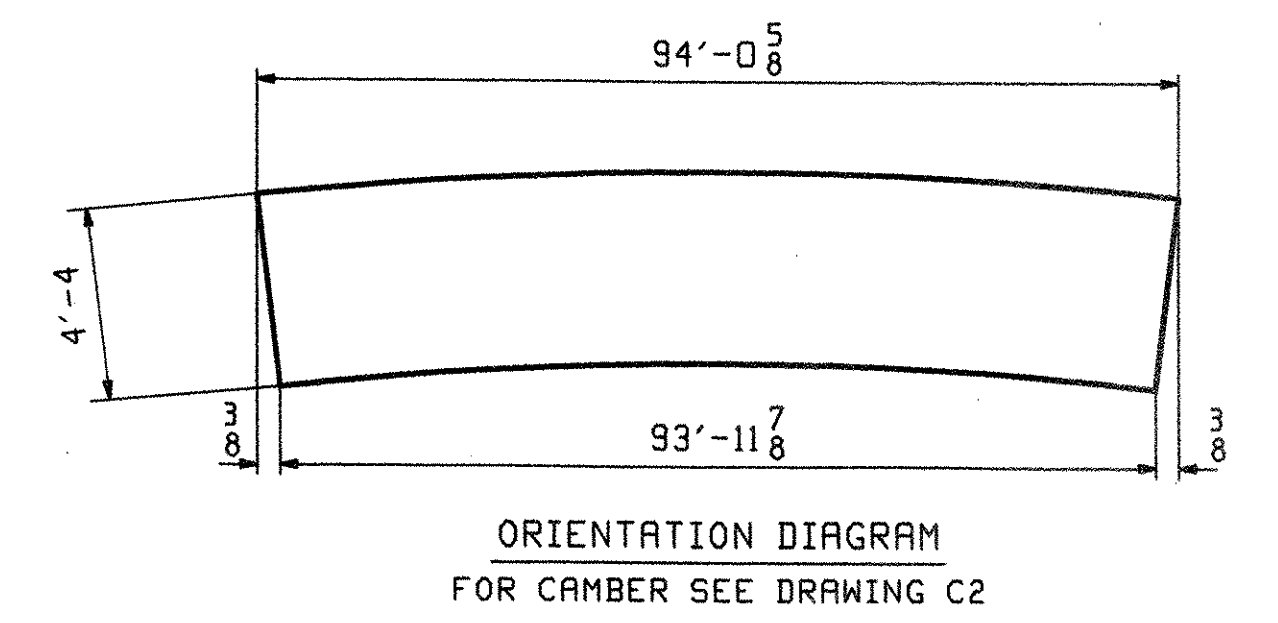


ABM INFO		SHIP	BILL OF MATERIAL				JOB NO.	DRAWING NO.	REV.
PAGE LINE		MARK	QTY	MARK	MATERIAL	LENGTH FT INCHES	REMARKS	WT	PROCUREMENT NOTES
		11G5B	1		GIRDER			17943	
1	L		1	wb	PL 1/2x52	49 6 1/4	(M270-50WT2) (H2-3)		
1	N		1	wb	PL 1/2x52	44 6 3/8	(M270-50WT2) (H2-3)		
1	G		1	ta	PL 7/8x16	42 3 3/4	(M270-50WT2) (H2-3)		
1	E		1	tb	PL 7/8x16	51 8 6/8	(M270-50WT2) (H2-3)		
1	G		1	ba	PL 7/8x16	42 3	(M270-50WT2) (H2-3)		
1	E		1	bb	PL 7/8x16	51 8 6/8	(M270-50WT2) (H2-3)		
2	J		12	x2c	PL 1/2x7 1/2	4 4			

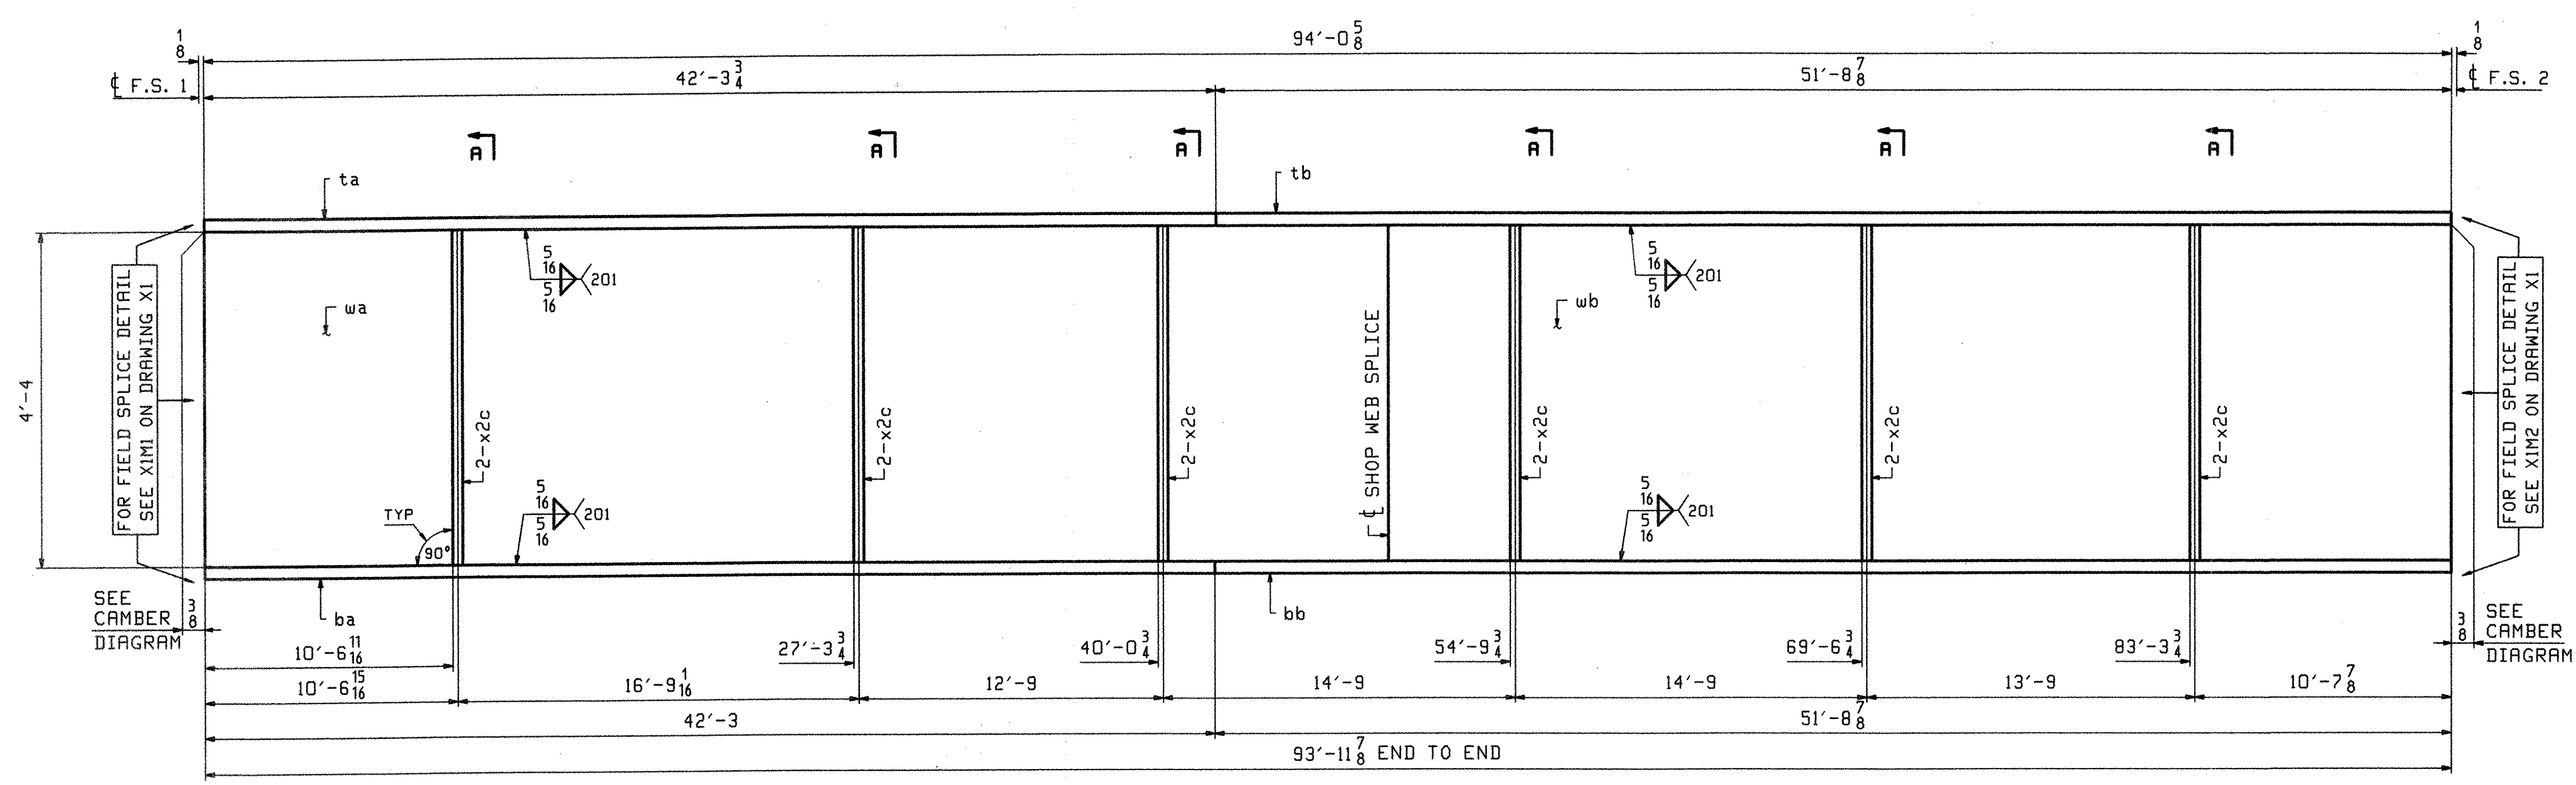

ONE - GIRDER - 11G5B
 FOR FIELD SPLICE DETAILS SEE DRAWING X1.
 FOR GIRDER STANDARD DETAILS SEE DRAWING X2.
 FOR CAMBER & FLANGE DIAGRAMS SEE DRAWING C2.
 FOR GENERAL NOTES SEE DRAWING GNI.
 H2-3 DENOTES MATERIAL SUBJECT TO CHARPY V-NOTCH TESTING.

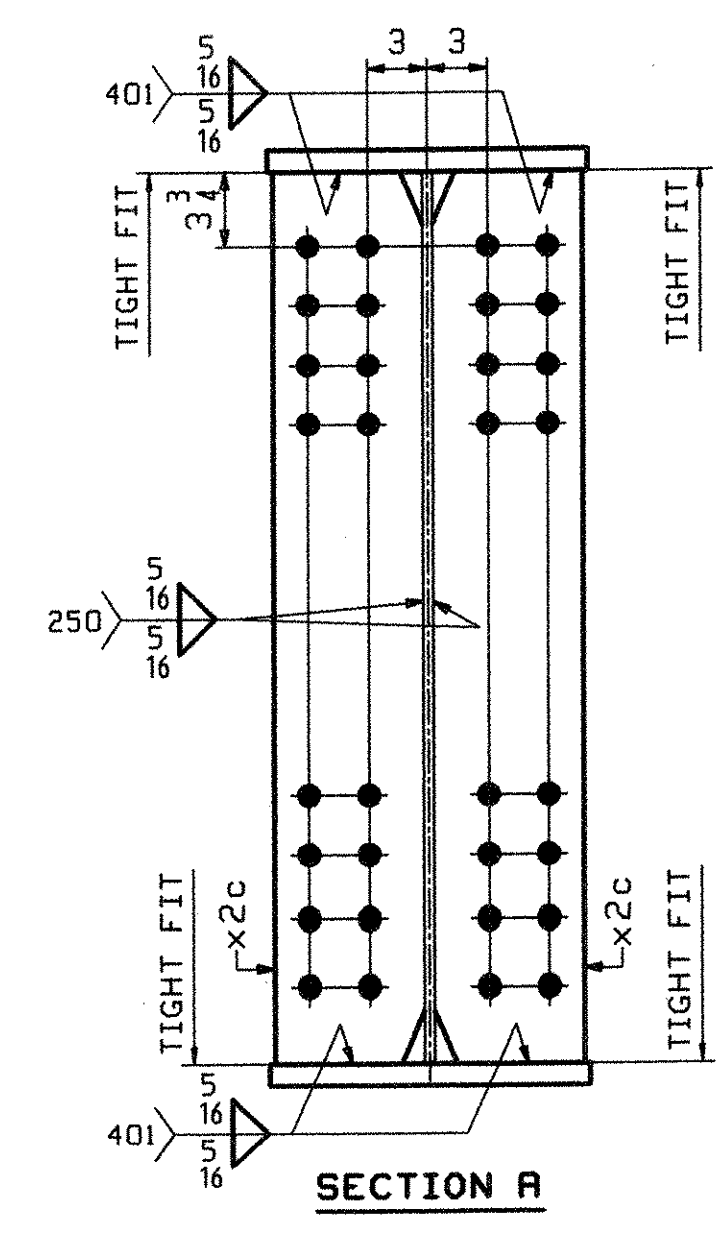

OUT FOR APPROVAL	<i>Final 7-17-06</i>										
OUT FOR APPROVAL											
ISSUED TO SHOP											
FIELD & OFFICE											
REV.	REMARKS	DATE	DWN	CHK	APP	Q.A.	NO.	DIA.	LGT	TYPE	WASHER
	MATERIAL:	ELECTRODES:		HOLES:		SHOP BOLTS:					
	M270-50W (UN)			15/16 Ø		NONE					
SURFACE PREP. & PAINT:											
SEE DRAWING GNI											
DESCRIPTION: GIRDER - 11G5B								DRAWN BY		DATE	
JOB: RTE 9 OVER ROARING BRANCH OF WALLOOMSAC RIVER								JTB		02/22	
BRIDGE No. BR 11								CHKD BY			
WOODFORD, VT. BENNINGTON COUNTY								PCP		03/06	
TENSOR 2608								APPROV BY			
PROJ NO. BHF 010-(129)								SUPERVISOR		W. J. GATTI	
CUSTOMER: RENAUD BROTHERS, INC.								Q.A.			
CASCO BAY STEEL STRUCTURES, INC.								JOB NO.		DRG. NO.	
75 SPRING HILL ROAD SACO, MAINE 04072								290		11	
PHONE (207) 282-7360 FAX. (207) 282-1179								REV.		▲	

RECEIVED
 CK'D BY _____ OK'D BY *MJM*
 JUL 26 2006
 RESUBMIT _____ APPROVED _____
 BY _____ DATE *7/28/06*