


1 ~ BRG CROSSFRAME - 19CF1

SHOP NOTE:
BOLT/WIRE BOTTOM STRUT FOR SHIPPING

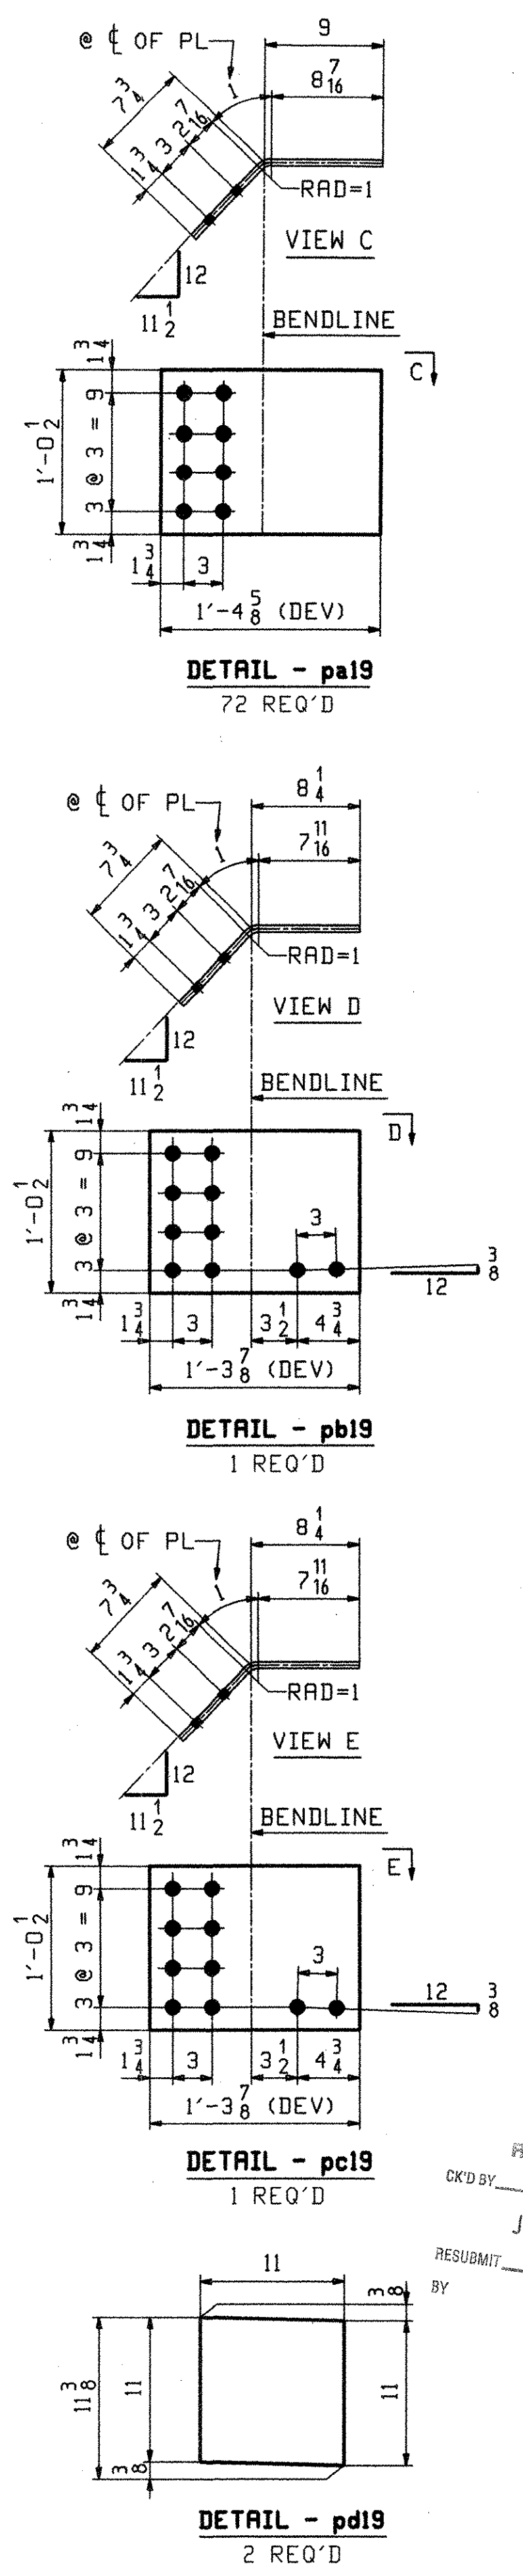

ABM INFO		BILL OF MATERIAL				JOB NO.	DRAWING NO.	REV.	
PAGE	LINE	MARK	QTY	MARK	MATERIAL	LENGTH FT INCHES	REMARKS	WT	PROCUREMENT NOTES
		19CF1	1		END CROSSFRAME			560	
3	G		1	a19	L 6x6x $\frac{5}{8}$	9 4 $\frac{11}{16}$			
3	B		1	b19	L 3x3x $\frac{1}{2}$	9 4 $\frac{3}{16}$			
3	D		1	c19	L 4x4x $\frac{1}{2}$	3 7 $\frac{13}{16}$			
3	D		1	d19	L 4x4x $\frac{1}{2}$	3 9 $\frac{1}{16}$			
3	F		2	pa19	PL 2x12 $\frac{1}{2}$	1 4 $\frac{5}{8}$	BENT		
3	F		1	pb19	PL 2x12 $\frac{1}{2}$	1 3 $\frac{7}{8}$	BENT		
3	F		1	pc19	PL 2x12 $\frac{1}{2}$	1 3 $\frac{7}{8}$	BENT		
3	E		2	pd19	PL 2x11	0 11 $\frac{3}{8}$			

OUT FOR APPROVAL	Final 7-17-06											
OUT FOR APPROVAL												
ISSUED TO SHOP												
FIELD & OFFICE												
REV.	REMARKS	DATE	DWN	CHK	APP	Q.A.	NO.	DIA.	LGT	TYPE	WASHER	
MATERIAL:	M270-S0W (UN)	ELECTRODES:		HOLES:	15, 16	ϕ				SHOP BOLTS:	NONE	
SURFACE PREP. & PAINT:												
PAINTED - SEE DRAWING GNI												
DESCRIPTION:		CROSSFRAMES					DRAWN BY	DATE				
JOB:		RTE 9 OVER ROARING BRANCH OF WALLDOOMSAC RIVER					CHKD BY	DATE				
		BRIDGE No. BR 11					PCP	03/06				
		WOODFORD, VT. BENNINGTON COUNTY					APPROV BY					
		SUPERVISOR W. J. GATTI					Q.A.					
PROJ NO.		BHF 010-1(29)					CUSTOMER:		RENAUD BROTHERS, INC.			
		CASCO BAY STEEL STRUCTURES, INC.					JOB NO.	DRG. NO.				
		75 SPRING HILL ROAD SACO, MAINE 04072					290	19				
		PHONE (207) 282-7360 FAX. (207) 282-1179					REV.	Δ				

RECEIVED
OK'D BY: [Signature]
JUL 26 2006
RESUBMIT: [Signature]
APPROVED: [Signature]
DATE: 7/28/06