


BRANTREE BRS 0187 (6) VT. 12A
BRIDGE 6
1997

INDEX OF SHEETS
SEE SHEET 2

STATE OF VERMONT
AGENCY OF TRANSPORTATION




PROPOSED IMPROVEMENT
TOWN OF BRAINTREE
COUNTY OF ORANGE
VT ROUTE 12A

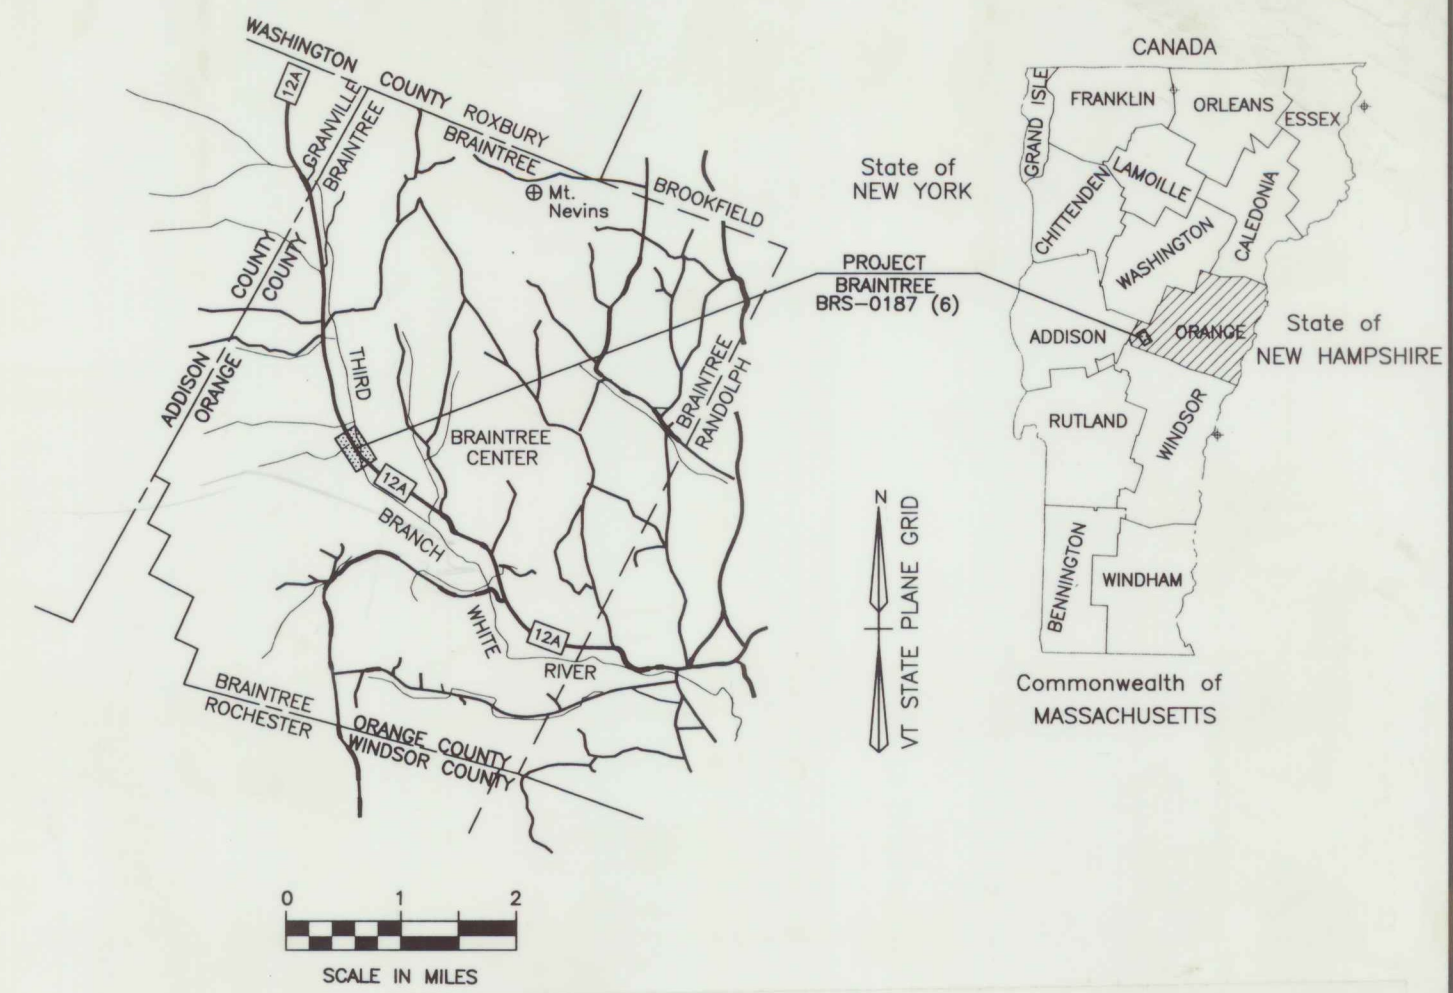

PROJECT LOCATION, LENGTH AND DESCRIPTION - "BEGINNING AT A POINT IN THE TOWN OF BRAINTREE, ON VERMONT ROUTE 12A APPROXIMATELY 3.751 MILES NORTHERLY OF THE RANDOLPH-BRAINTREE TOWN LINE, AND EXTENDING NORTHERLY 0.237 MILES."
 LENGTH OF ROADWAY = 1112.06 FEET = 0.211 MILES
 LENGTH OF BRIDGE = 137.94 FEET = 0.026 MILES
 LENGTH OF PROJECT = 1250.00 FEET = 0.237 MILES

WORK TO BE PERFORMED UNDER THIS PROJECT CONSISTS OF REPLACEMENT OF EXISTING BRIDGE #6 ON VERMONT ROUTE 12A, INCLUDING ALL THE NECESSARY ROADWAY APPROACH WORK.

RECORD PLANS
 CONTRACTOR: MILLER CONST INC WINDSOR, VT
 RESIDENT ENGINEER: CHRIS BARKER
 CONSTRUCTION BEGAN: Oct 1, 1996
 CONSTRUCTION COMPLETED: Oct 24, 1997
 RECORD PLANS BY: F. Donald
 I HEREBY CERTIFY THAT ALL THE CONSTRUCTION REQUIRED BY THIS SET OF DRAWINGS HAS BEEN ACCOMPLISHED AS INDICATED HEREON.
 BY: *Chris Barker* RESIDENT ENGINEER
 DATE: 03/09/98
 NOTE: Any further information concerning final quantities, amounts or other details relative to this project may be found on microfiche in Central Files.

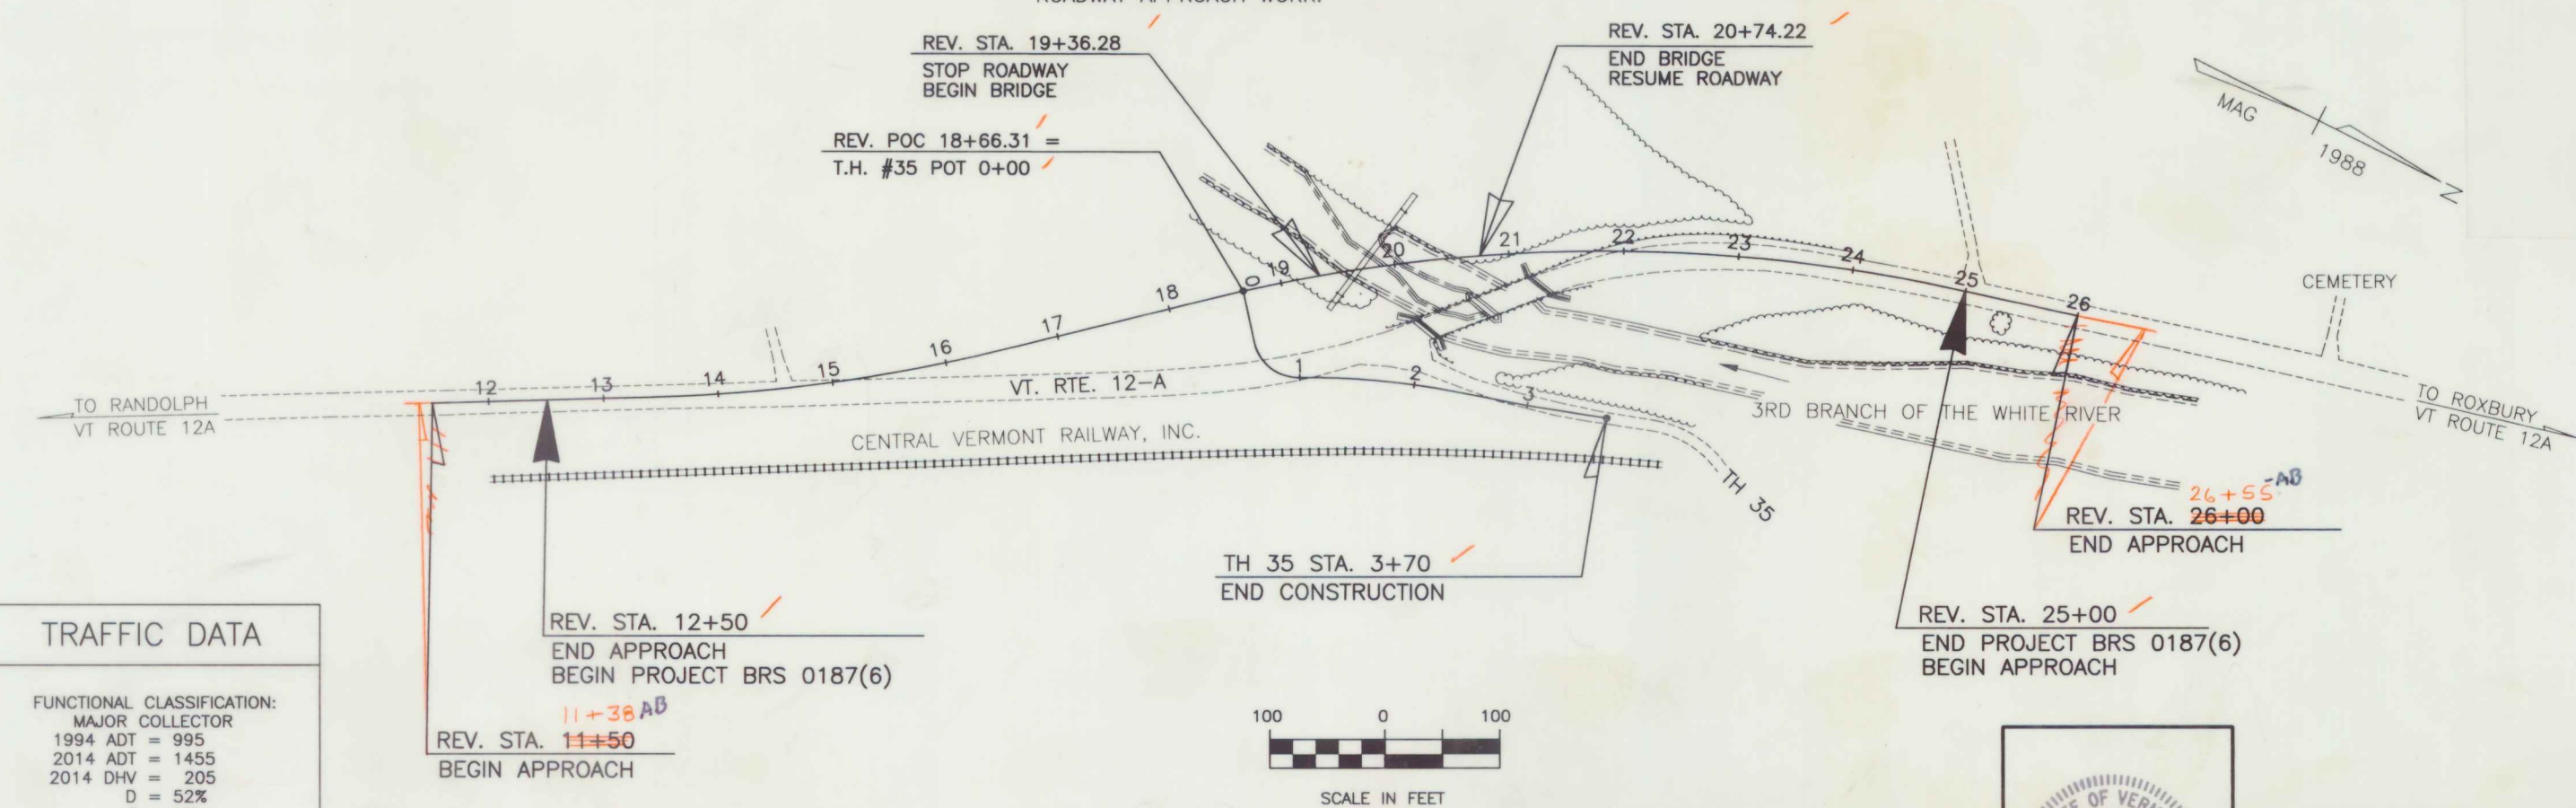

TRAFFIC DATA

FUNCTIONAL CLASSIFICATION:
 MAJOR COLLECTOR
 1994 ADT = 995
 2014 ADT = 1455
 2014 DHV = 205
 D = 52%
 T = 1%
 V = 50 M.P.H.
 1994-2014 18 KIP ESAL = 674,744

DATUM: NGVD 1929
 VERTICAL: N/A
 HORIZONTAL: N/A

CONVENTIONAL SIGNS

- COUNTY LINE
- TOWN LINE
- LIMITS OF ACCESS
- POINT OF ACCESS
- FENCE LINE
- STONE WALL
- TRAVELED WAY
- GUARD RAIL
- RAILROAD
- SURVEY LINE
- CULVERT
- POWER POLE
- TELEPHONE POLE
- TREES
- CONTROL OF ACCESS
- PROPERTY LINE
- R.O.W. TAKING LINE
- SLOPE RIGHTS
- TOP OF CUT
- TOE OF SLOPE

THESE PLANS ARE SUBJECT TO SUCH ENGINEERING CHANGES AS MAY BE REQUIRED BY THE FEDERAL HIGHWAY ADMINISTRATION OR THE CHIEF ENGINEER. CONSTRUCTION IS TO BE CARRIED ON IN ACCORDANCE WITH THESE PLANS AND THE STANDARD SPECIFICATIONS FOR CONSTRUCTION DATED 1990, AS APPROVED BY THE FEDERAL HIGHWAY ADMINISTRATION ON MARCH 15, 1990 FOR USE ON THIS PROJECT, INCLUDING ALL SUBSEQUENT REVISIONS AND SUCH REVISED SPECIFICATIONS AND SPECIAL PROVISIONS AS ARE INCORPORATED IN THESE PLANS.

SUBMITTED BY ORDER OF THE STATE TRANSPORTATION BOARD
 APPROVED: *Chris Barker* DATE: 07/96
 DIRECTOR OF ENGINEERING
 DEPARTMENT OF TRANSPORTATION
 FEDERAL HIGHWAY ADMINISTRATION
 APPROVED: _____ DATE: _____
 DIVISION ADMINISTRATOR
 PROJECT: BRAINTREE BRS 0187(6)
 SHEET 1 OF 79 SHEETS

Prepared By: *Christopher L. Bond*

CLD
 Costello, Laramanney & de Napoli, Inc.
 Consulting Engineers
 540 Commercial Street
 Manchester, NH 03102
 (603)668-8223 FAX(603)668-8802