


TYPICAL SECTION (TH 35)

- 1-1/4" BITUMINOUS CONCRETE PAVEMENT, TYPE III
 - ~~1-3/4" BITUMINOUS CONCRETE PAVEMENT, TYPE II~~ } (STA 0+15 TO 0+46) ✓
 - 2-1/2" BITUMINOUS CONCRETE PAVEMENT, TYPE I
 - 18" SUBBASE
-
- 3" AGGREGATE SURFACE COURSE } (STA 0+46 TO 3+70) ✓
 - 18" SUBBASE

MATERIAL ITEM	THICKNESS TOLERANCE
PAVEMENT (TOTAL DEPTH)	± 1/4"
SUBBASE	± 1/2"

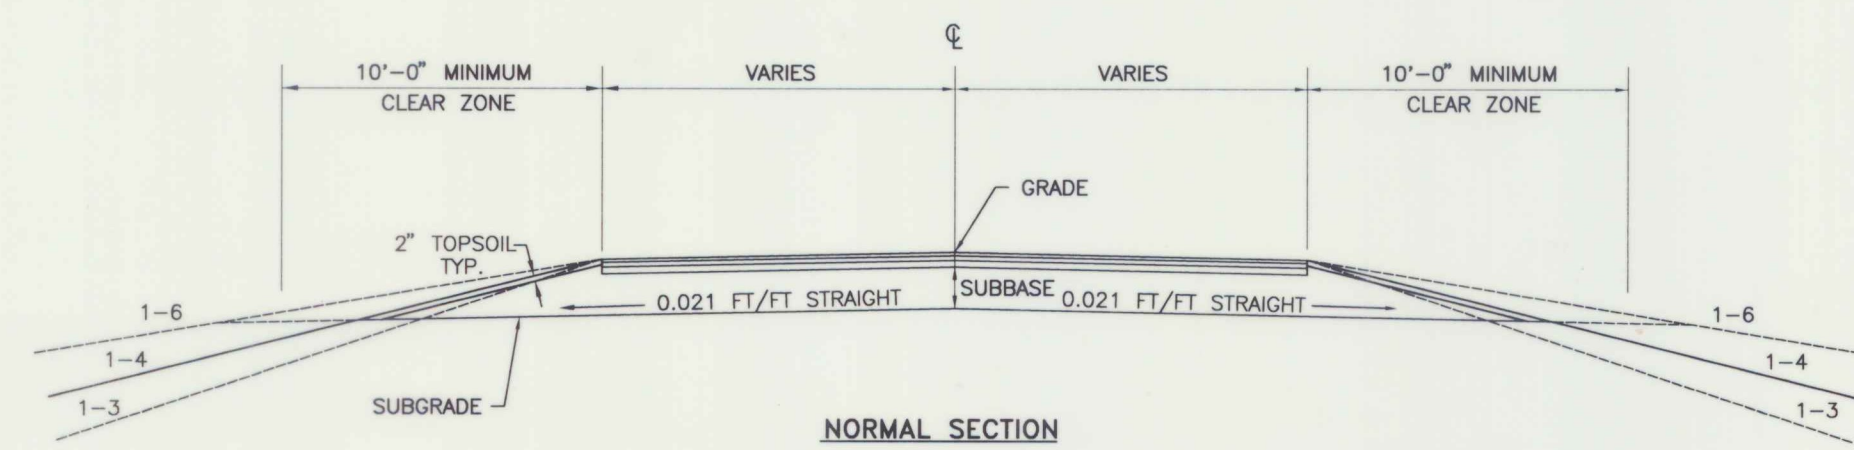

STATE OF VERMONT			
AGENCY OF TRANSPORTATION			
Town Of	BRAINTREE	Bridge No.	6
Highway No.	VT. ROUTE 12A	Log Sta.	
		Surv. Sta.	
VT RTE 12A OVER THE THIRD BRANCH OF THE WHITE RIVER			
TYPICAL SECTION - TH 35			
Designed By	J. Warner	Drawn By:	N. Spaulding
Checked By	Date	Bridge Design Supervisor	Date
J. Warner	9/94		
PROJECT	BRAINTREE	PROJECT NO.	BRS 0187(6)
I.G.C. Info.			
Bridge Sheet No.		Sheet	4 Of 79