
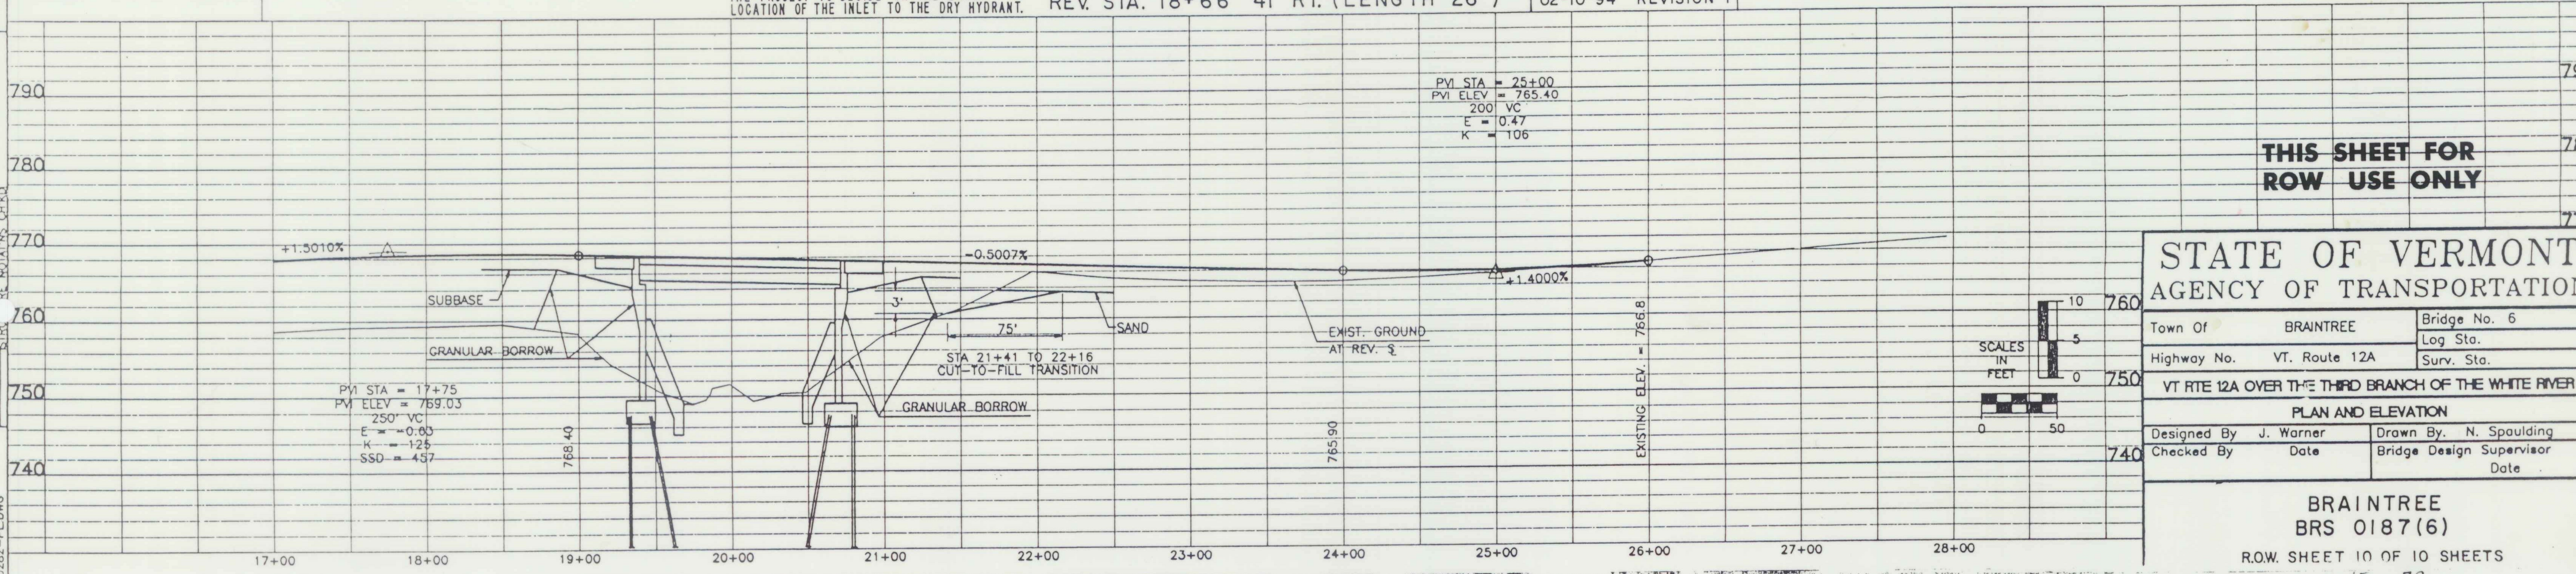


DATE	
BY	
REVISION	
NO. 1	
NO. 2	
NO. 3	
NO. 50	

DATE	
BY	
REVISION	
NO. 1	
NO. 2	
NO. 3	
NO. 50	

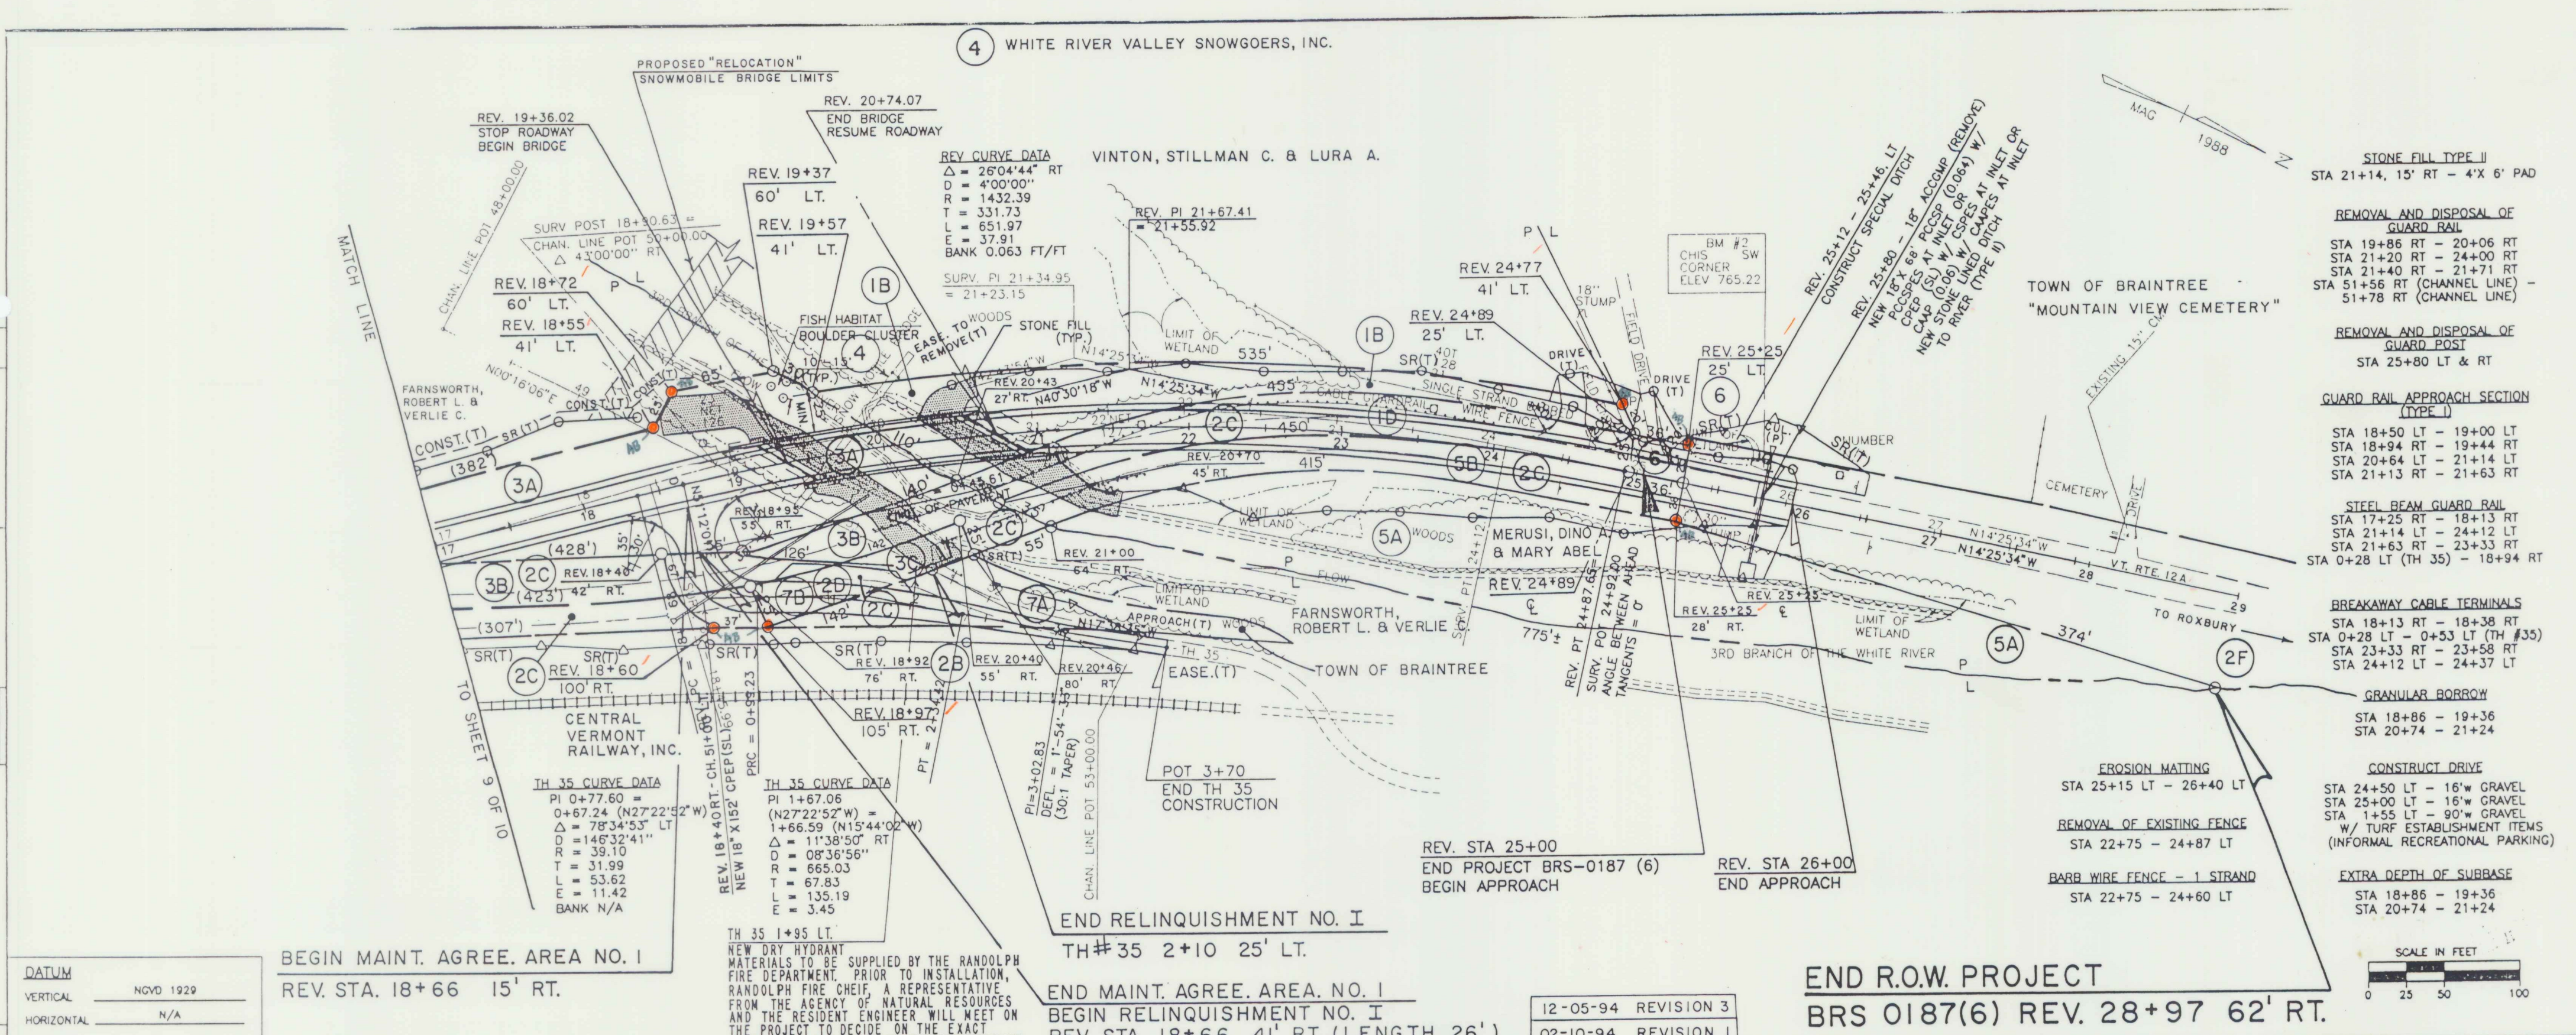

- STONE FILL TYPE II
STA 21+14, 15' RT - 4'X 6' PAD
- REMOVAL AND DISPOSAL OF GUARD RAIL
STA 19+86 RT - 20+06 RT
STA 21+20 RT - 24+00 RT
STA 21+40 RT - 21+71 RT
STA 51+56 RT (CHANNEL LINE)
51+78 RT (CHANNEL LINE)
- REMOVAL AND DISPOSAL OF GUARD EDGE
STA 23+80 LT & RT
- GUARD RAIL APPROACH SECTION (TYPE I)
STA 18+50 LT - 19+00 LT
STA 18+94 RT - 19+44 RT
STA 20+64 LT - 21+14 LT
STA 21+13 RT - 21+63 RT
- STEEL BEAM GUARD RAIL
STA 17+25 RT - 18+13 RT
STA 21+14 LT - 24+12 LT
STA 21+63 RT - 23+33 RT
STA 0+28 LT (TH 35) - 18+94 RT
- BREAKAWAY CABLE TERMINALS
STA 18+13 RT - 18+36 RT
STA 0+28 LT - 0+53 LT (TH 35)
STA 23+33 RT - 23+58 RT
STA 24+12 LT - 24+37 LT
- GRANULAR BORROW
STA 18+86 - 19+36
STA 20+74 - 21+24
- CONSTRUCT DRIVE
STA 24+50 LT - 16' W GRAVEL
STA 25+00 LT - 16' W GRAVEL
STA 1+55 LT - 90' W GRAVEL
W/ TURF ESTABLISHMENT ITEMS (INFORMAL RECREATIONAL PARKING)
- EXTRA DEPTH OF SUBBASE
STA 18+86 - 19+36
STA 20+74 - 21+24

SCALE IN FEET
0 25 50 100

12-05-94 REVISION 3
02-10-94 REVISION 1

THIS SHEET FOR ROW USE ONLY

STATE OF VERMONT
AGENCY OF TRANSPORTATION

Town Of	BRAINTREE	Bridge No. 6	
Highway No.	VT. Route 12A	Log Sta.	
		Surv. Sta.	
VT RTE 12A OVER THE THIRD BRANCH OF THE WHITE RIVER			
PLAN AND ELEVATION			
Designed By	J. Warner	Drawn By	N. Spaulding
Checked By		Date	
		Bridge Design Supervisor	Date

BRAINTREE
BRS 0187(6)
R.O.W. SHEET 10 OF 10 SHEETS
15 79