


PLAN	DATE
BY	
REVISIONS	
NO.	
NOTED	
ALIGNMENT CHECKED	
RT. OF WAY CHECKED	
NO.	

LEGEND

- ☐ PHASE I TYPE III BARRICADES (ACROSS THE ENTIRE ROADWAY)
- ▨ PHASE II TYPE III BARRICADES (ACROSS THE ENTIRE ROADWAY)
- PHASE I PLASTIC DRUM
- PHASE II PLASTIC DRUM
- ▲ PHASE I SIGN (MOUNTED ON THE BARRICADE)
- ▴ PHASE II SIGN (MOUNTED ON THE BARRICADE)

NOTE: BARRELS ARE SHOWN FOR ESTIMATING PURPOSES ONLY. SIGN LOCATIONS ARE APPROXIMATE. FINAL LOCATIONS WILL BE LOCATED IN THE FIELD BY THE ENGINEER OR AS SHOWN ON THE STANDARD DETAILS.


ADDITIONAL CONSTRUCTION SIGNING WILL BE REQUIRED BETWEEN PHASE I AND II AT THE DISCRETION OF THE RESIDENT ENGINEER.

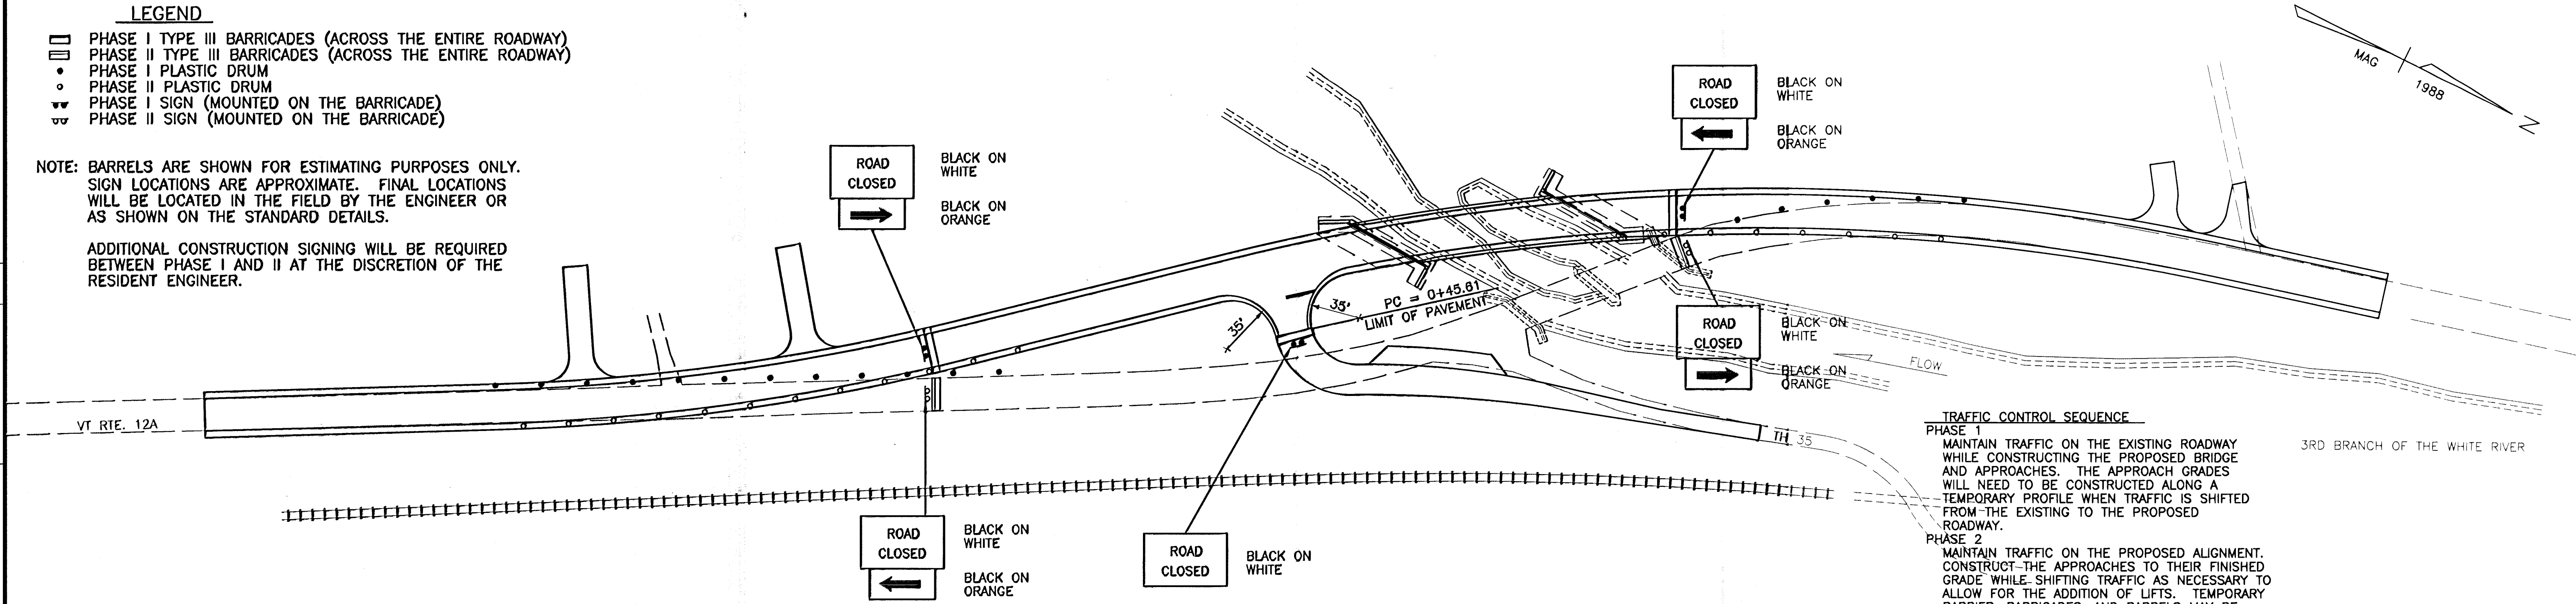


TRAFFIC CONTROL SEQUENCE
PHASE 1
 MAINTAIN TRAFFIC ON THE EXISTING ROADWAY WHILE CONSTRUCTING THE PROPOSED BRIDGE AND APPROACHES. THE APPROACH GRADES WILL NEED TO BE CONSTRUCTED ALONG A TEMPORARY PROFILE WHEN TRAFFIC IS SHIFTED FROM THE EXISTING TO THE PROPOSED ROADWAY.
PHASE 2
 MAINTAIN TRAFFIC ON THE PROPOSED ALIGNMENT. CONSTRUCT THE APPROACHES TO THEIR FINISHED GRADE WHILE SHIFTING TRAFFIC AS NECESSARY TO ALLOW FOR THE ADDITION OF LIFTS. TEMPORARY BARRIER, BARRICADES, AND BARRELS MAY BE NECESSARY TO KEEP TRAFFIC FROM STEEP SLOPES AND OTHER HAZARDS DURING THIS PHASE.

REMOVE THE EXISTING STRUCTURE, ABUTMENTS, AND PIER, AND GRADE THE AREA AS INDICATED ON THE PLANS.

TRAFFIC CONTROL PLAN AND SIGNING

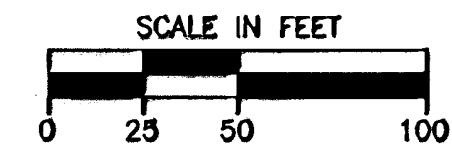

NOTE: SIGN LOCATIONS ARE APPROXIMATE. FINAL LOCATIONS WILL BE LOCATED IN THE FIELD BY THE ENGINEER OR AS SHOWN ON THE STANDARD DETAILS.

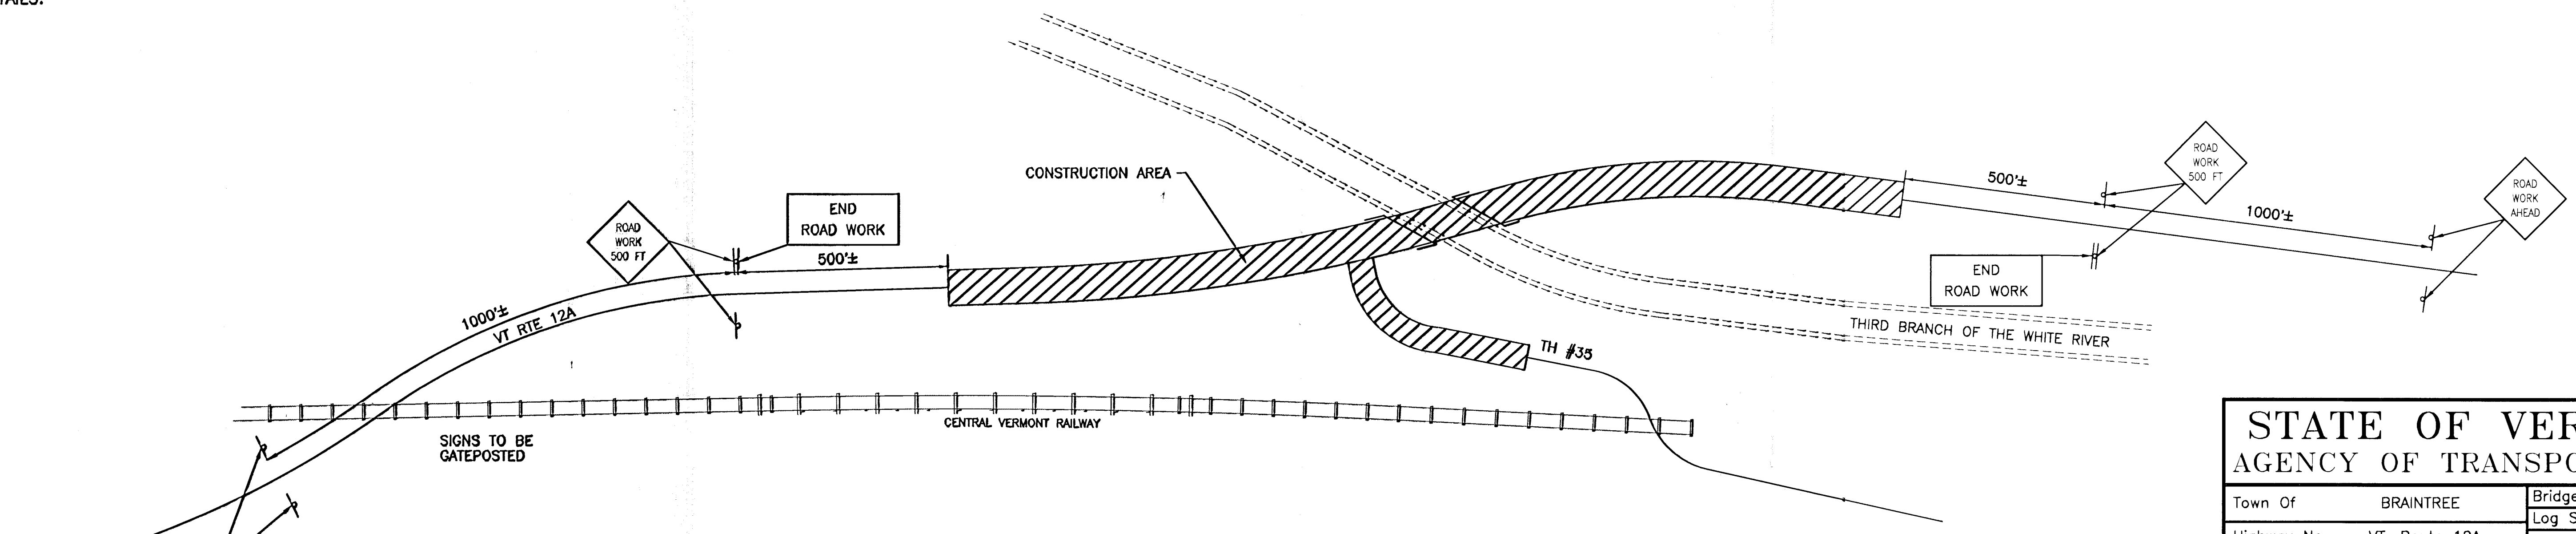

APPROACH SIGNING
NOT TO SCALE

NOT TO SCALE

STATE OF VERMONT
AGENCY OF TRANSPORTATION

Town Of	BRAINTREE	Bridge No.	6
Highway No.	VT. Route 12A	Log Sta.	
		Surv. Sta.	
VT RTE 12A OVER THE THIRD BRANCH OF THE WHITE RIVER			
CONST. APPROACH SIGNING/TRAFFIC CONTROL PLAN			
Designed By	J. Warner	Drawn By	J. Warner
Checked By	Date	Bridge Design Supervisor	Date
R. Larochelle			
PROJECT	BRAINTREE	PROJECT NO.	BRS 0187(6)
I.G.C. Info.			
Bridge Sheet No.		Sheet	23 Of 79