


GENERAL PLAN
SCALE: 1" = 20'



STATE OF VERMONT AGENCY OF TRANSPORTATION	
Town Of BRAINTREE	Bridge No. 6
Highway No. VT RTE 12A	Log Sta.
VT RTE 12A OVER 3RD BRANCH OF THE WHITE RIVER	
SURV. STA.	
DESIGNED BY E.M. Stumph	
DRAWN BY J.L. Fryer	
CHECKED BY E.M. Stumph	DATE 1/95
CLD PROJECT MANAGER	DATE 1/95
PROJECT BRAINTREE	PROJECT NO. BRS 0187 (6)
I.G.C. Info.	
Bridge Sheet No. BR 102	Sheet 26 Of 79

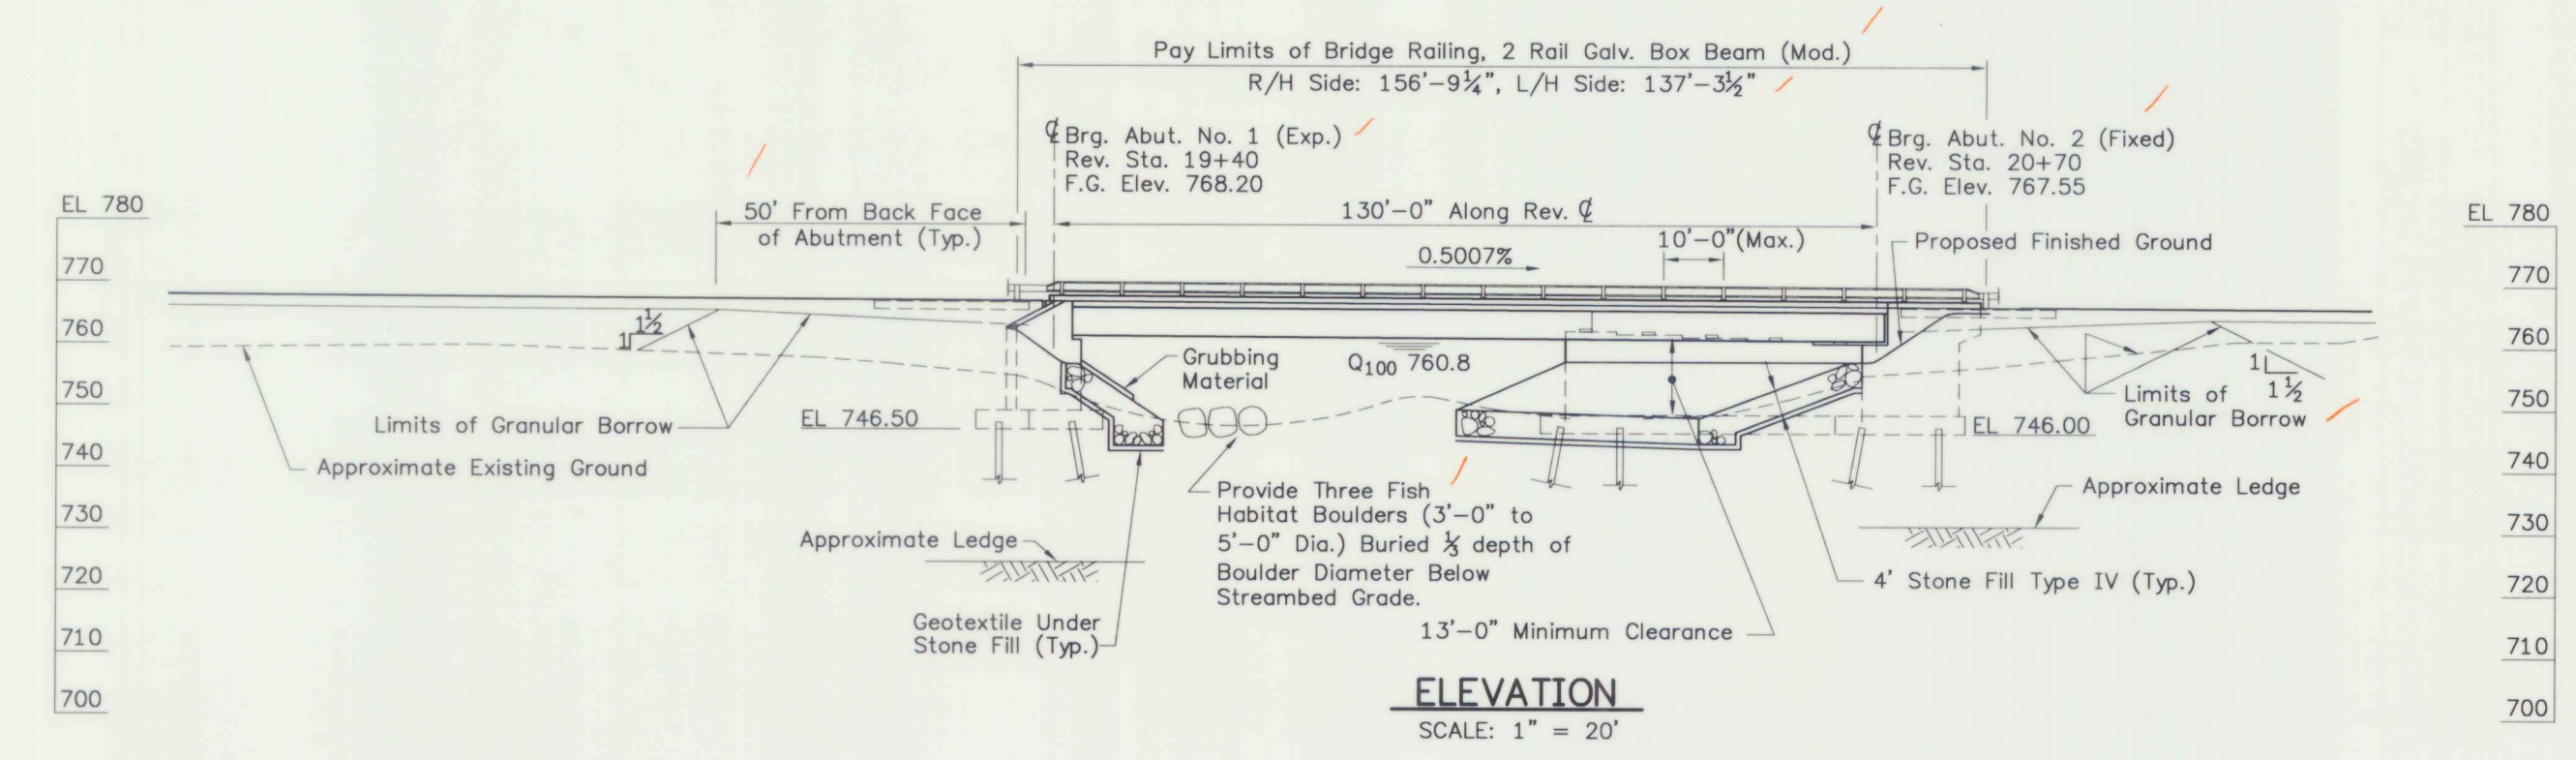