



ABUTMENT NO. 1 PLAN
Scale: 1/4"=1'-0"

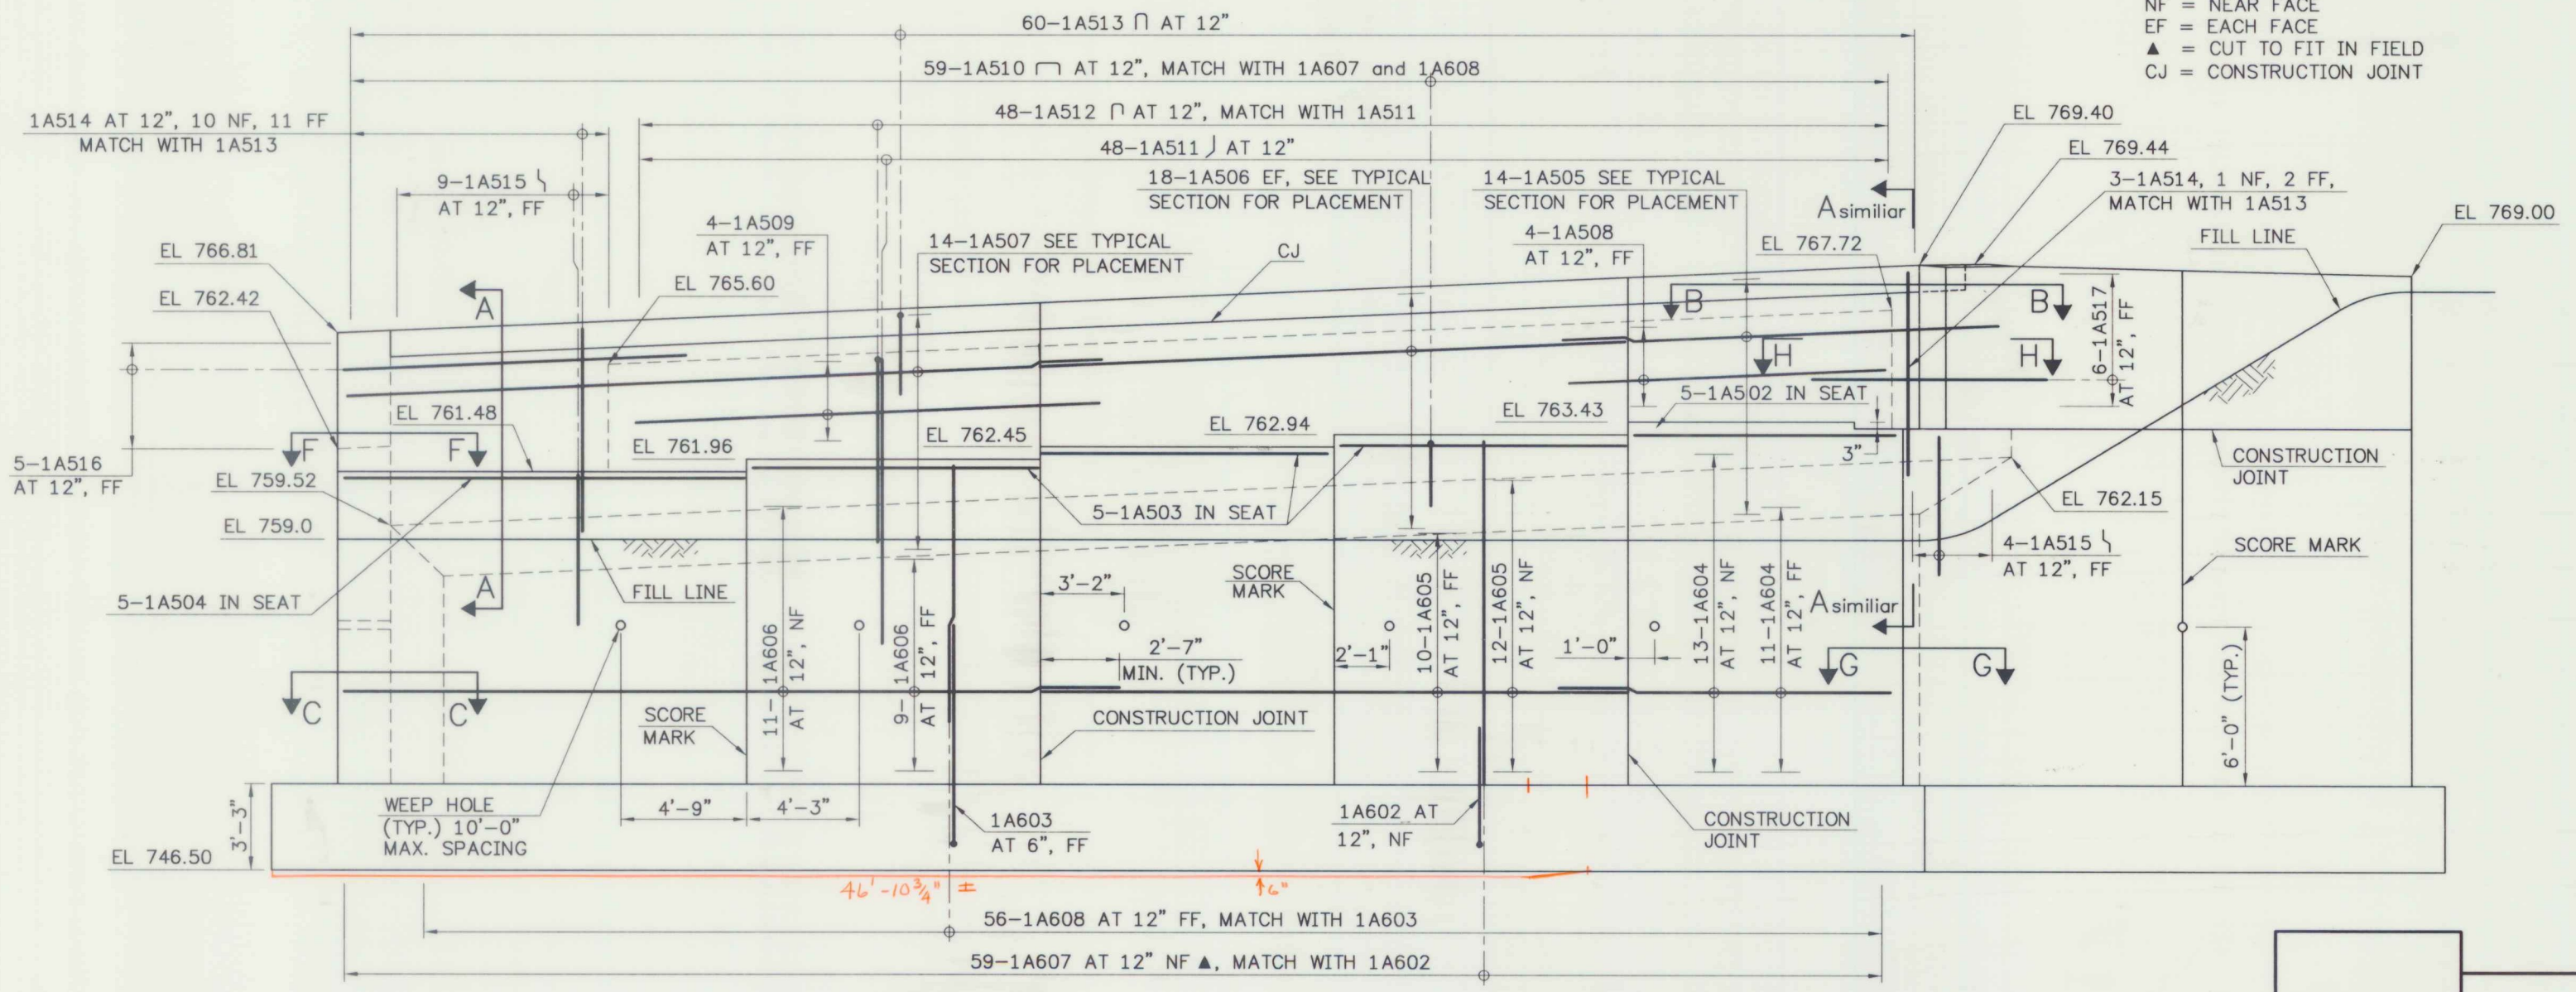

ABUTMENT NO. 1 ELEVATION
Scale: 1/4"=1'-0"

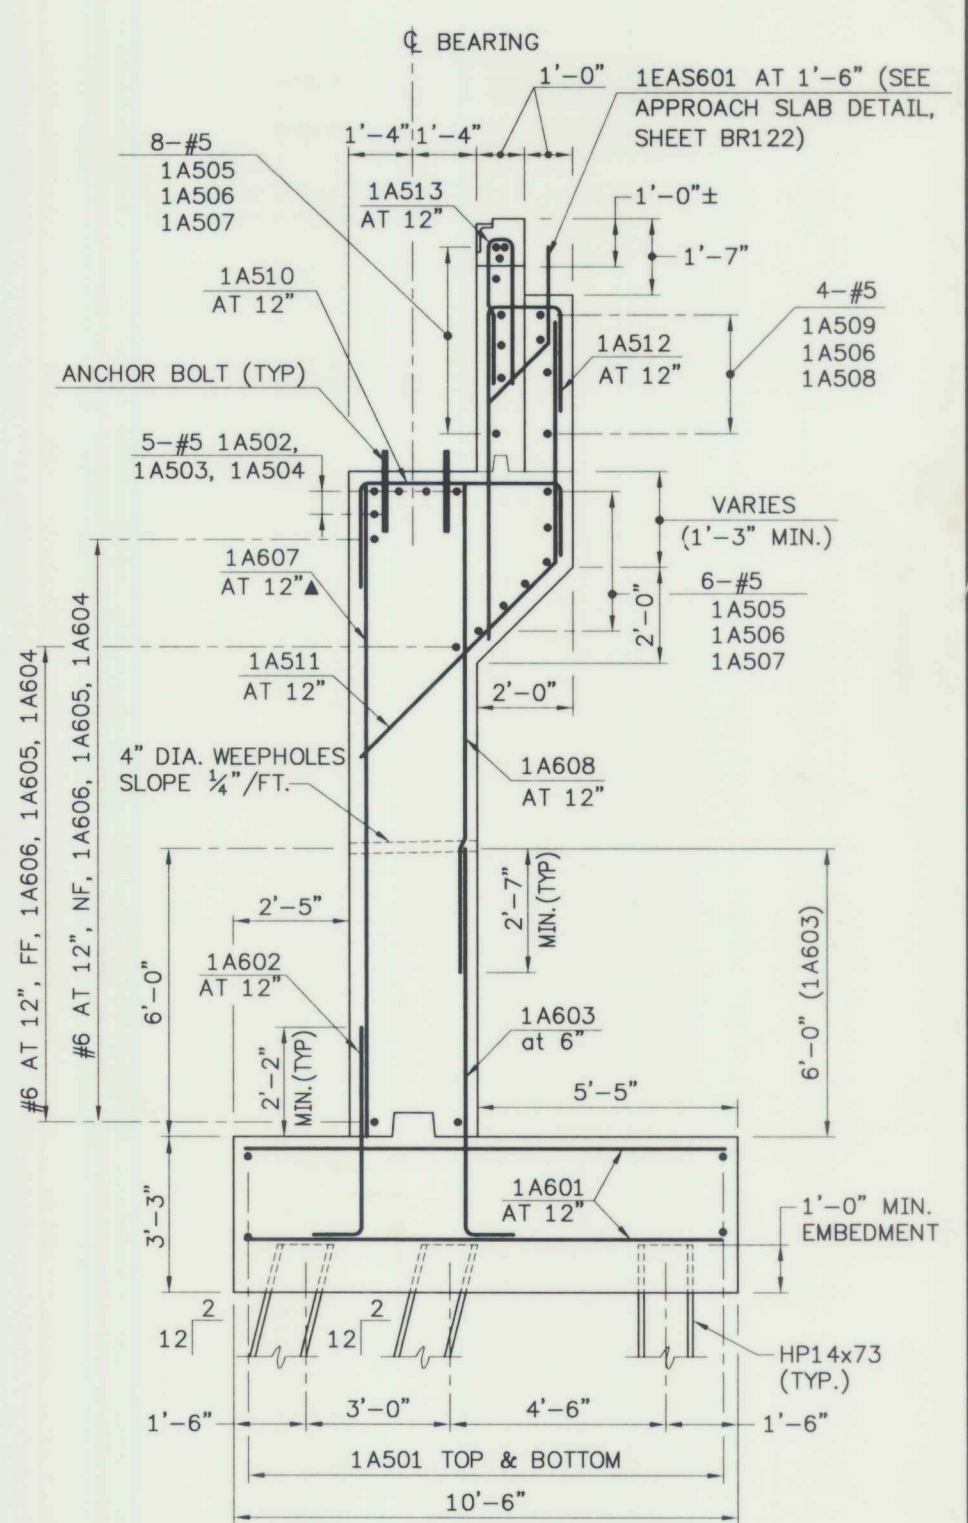

TYPICAL ABUTMENT SECTION
Scale: 3/8"=1'-0"

SEE BRIDGE SHEETS BR 118 & BR 119 FOR ADDITIONAL SECTIONS AND DETAILS.
SEE BRIDGE SHEET BR 121 FOR FOOTING REINFORCING.
SEE BRIDGE SHEET BR 118 FOR WINGWALL REINFORCING AND ADDITIONAL SECTIONS.

**STATE OF VERMONT
AGENCY OF TRANSPORTATION**

Town Of	BRAINTREE	Bridge No.	6
Highway No.	VT RTE 12A	Log Sta.	
		Surv. Sta.	
VT RTE 12A OVER 3RD BRANCH OF THE WHITE RIVER			
ABUTMENT NO. 1 DETAILS			
Designed By	E.M.Stumph	Drawn By	M.J.Lamper
Checked By	E.M.Stumph	Date	1/95
		CLD Project Manager	C.R.Bean
		Date	1/95
PROJECT		PROJECT NO.	
BRAINTREE		BRS 0187(6)	
I.G.C. Info.			
Bridge Sheet No.	BR 116	Sheet	40 Of 79

