


**ABUTMENT NO. 1
FOOTING REINFORCING PLAN**
SCALE: 1/4"=1'-0"

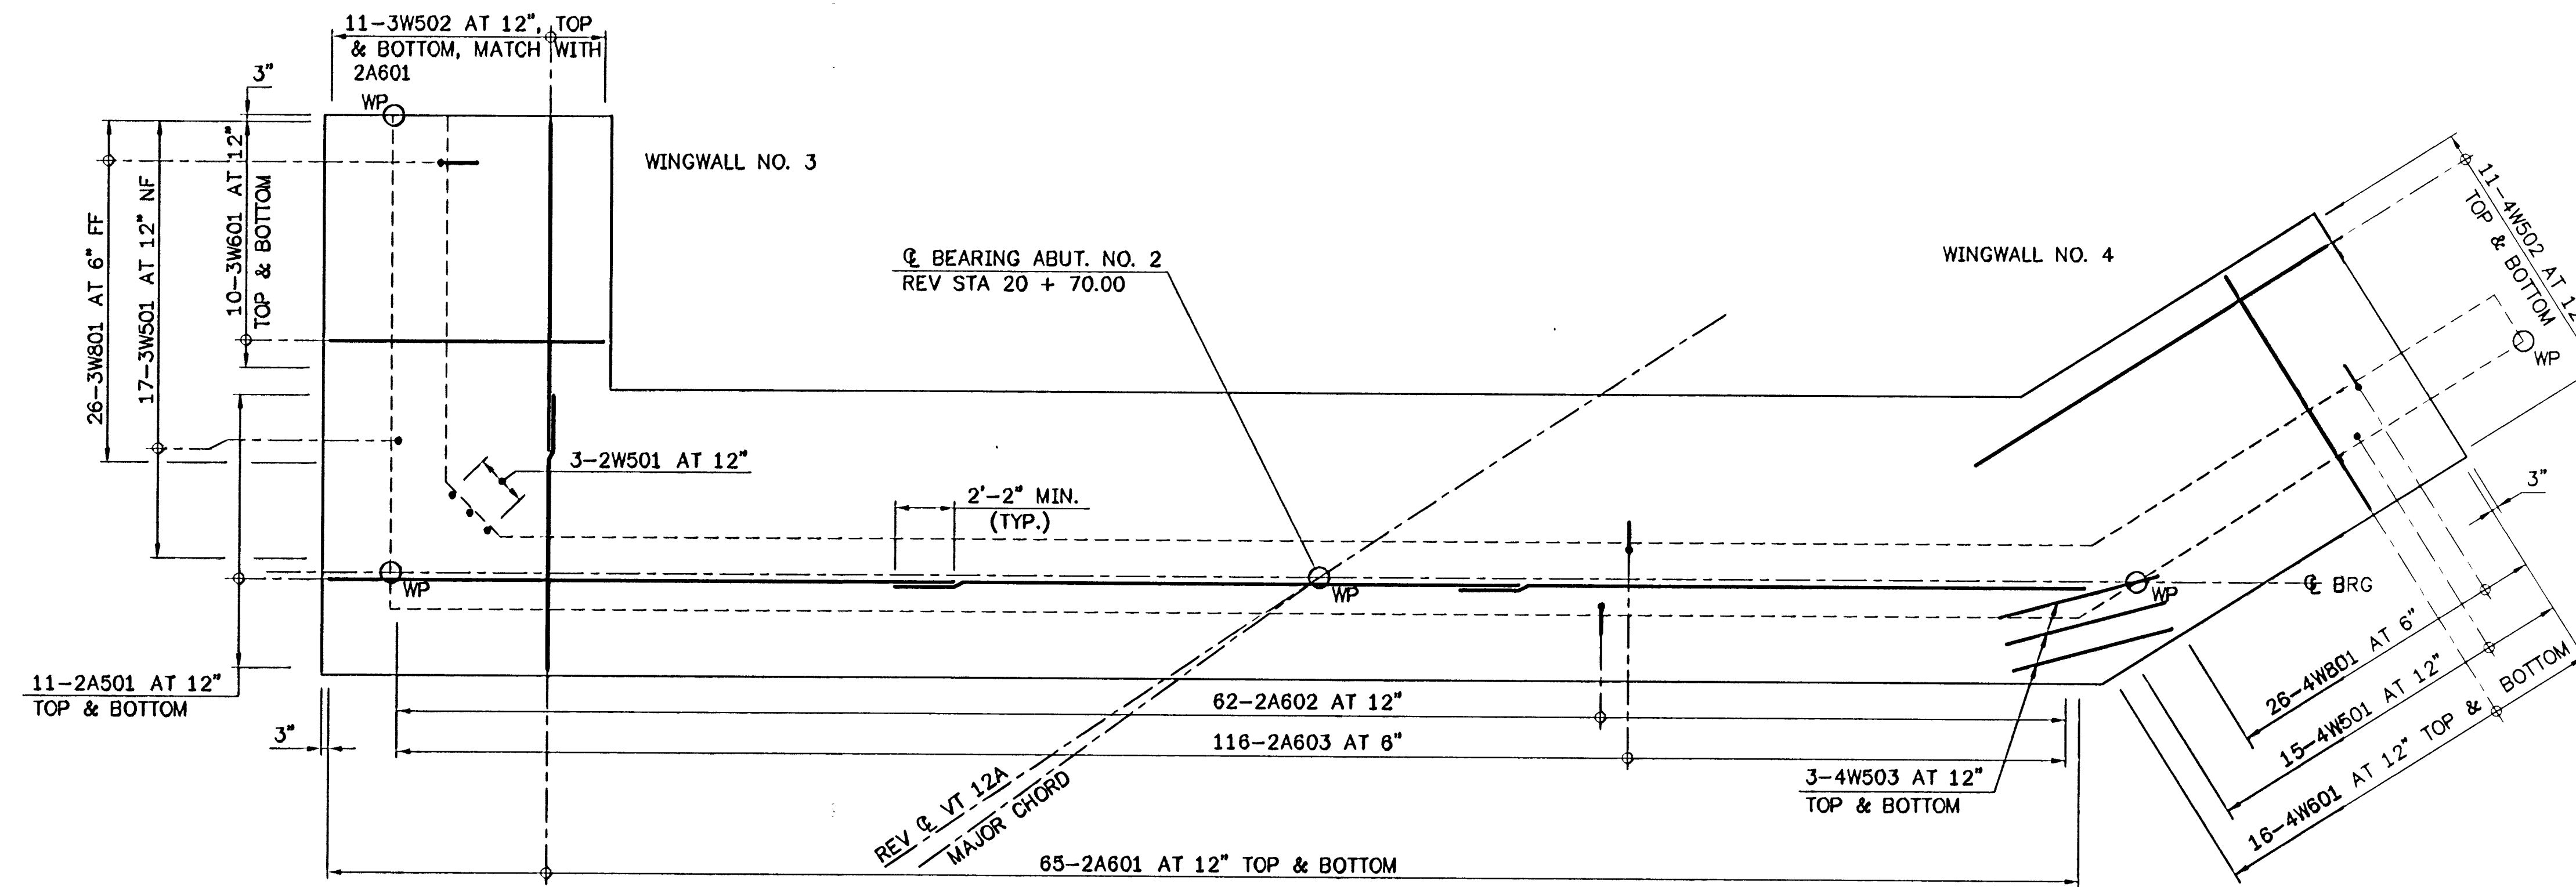

**ABUTMENT NO. 2
FOOTING REINFORCING PLAN**
SCALE: 1/4"=1'-0"

STATE OF VERMONT AGENCY OF TRANSPORTATION		
Town Of	BRAINTREE	Bridge No. 6
Highway No.	VT RTE 12A	Log Sta.
		Surv. Sta.
VT RTE 12A OVER 3RD BRANCH OF THE WHITE RIVER		
FOOTING REINFORCING PLAN		
Designed By	K.G.Marshall	Drawn By. A.Setas
Checked By	Date	CLD Project Manager
E.M.Stumph	1/95	C.R.Bean Date 1/95
PROJECT	BRAINTREE	PROJECT NO. BRS 0187(6)
I.G.C. Info.		
Bridge Sheet No. BR 121	Sheet 45	Of 79



30282FTG.dwg (1=48)