



760  
760  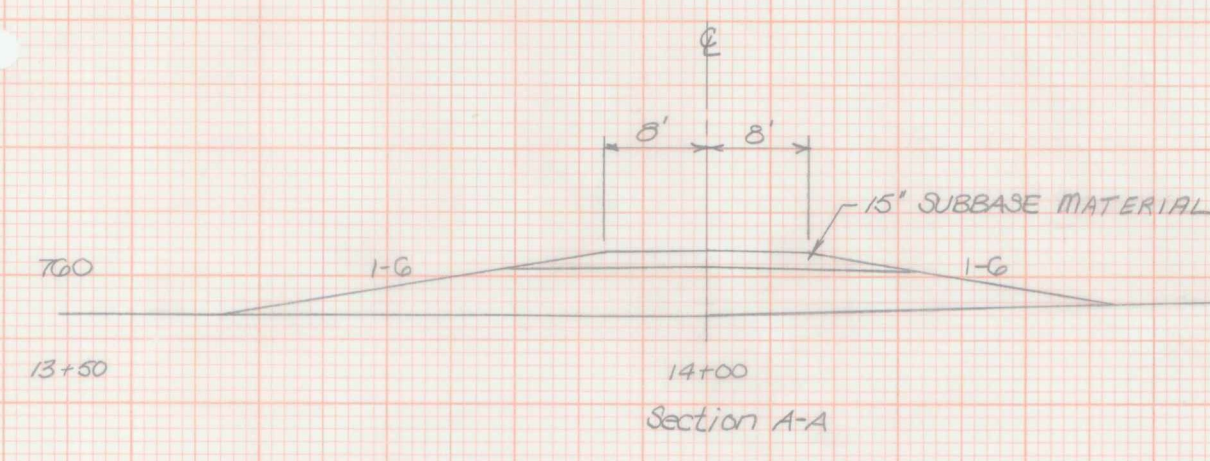
Section A-A

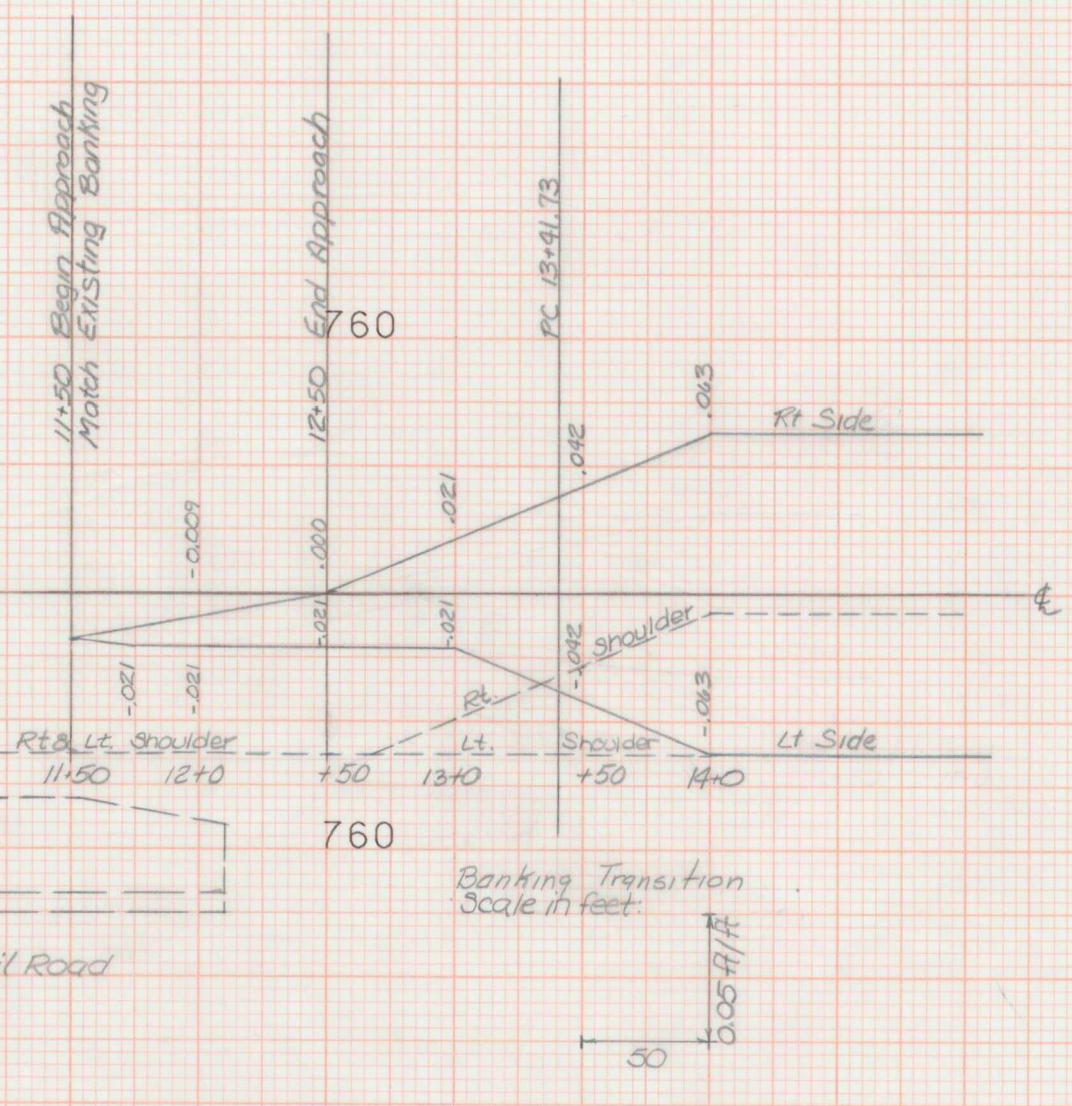

Stone Fill Type II  
12+83  
NEW 12' x 15' RCP (CLASS III) W/ RCP'S @ INLET OR OPEN (SL) W/ OPEN'S @ INLET  
NEW STONE FILL TYPE II @ INLET & OUTLET  
A-24 M NLTD  
B-24 M NLTD  
Sep 12+80  
EXISTING 15' RCP @ 15' x 15' Stone Box Culvert

FROM STA.	12+50	TO STA.	14+00
PROJECT NAME	BRAINTREE		
NO.	BRS0187 (6)		
SURVEYED BY	J. SHERIDAN	DATE	07/88 0141
SHEET	OF	SHEETS	79

SCALE 10 FEET