


DATE	BY	REVISION

DATE	BY	REVISION

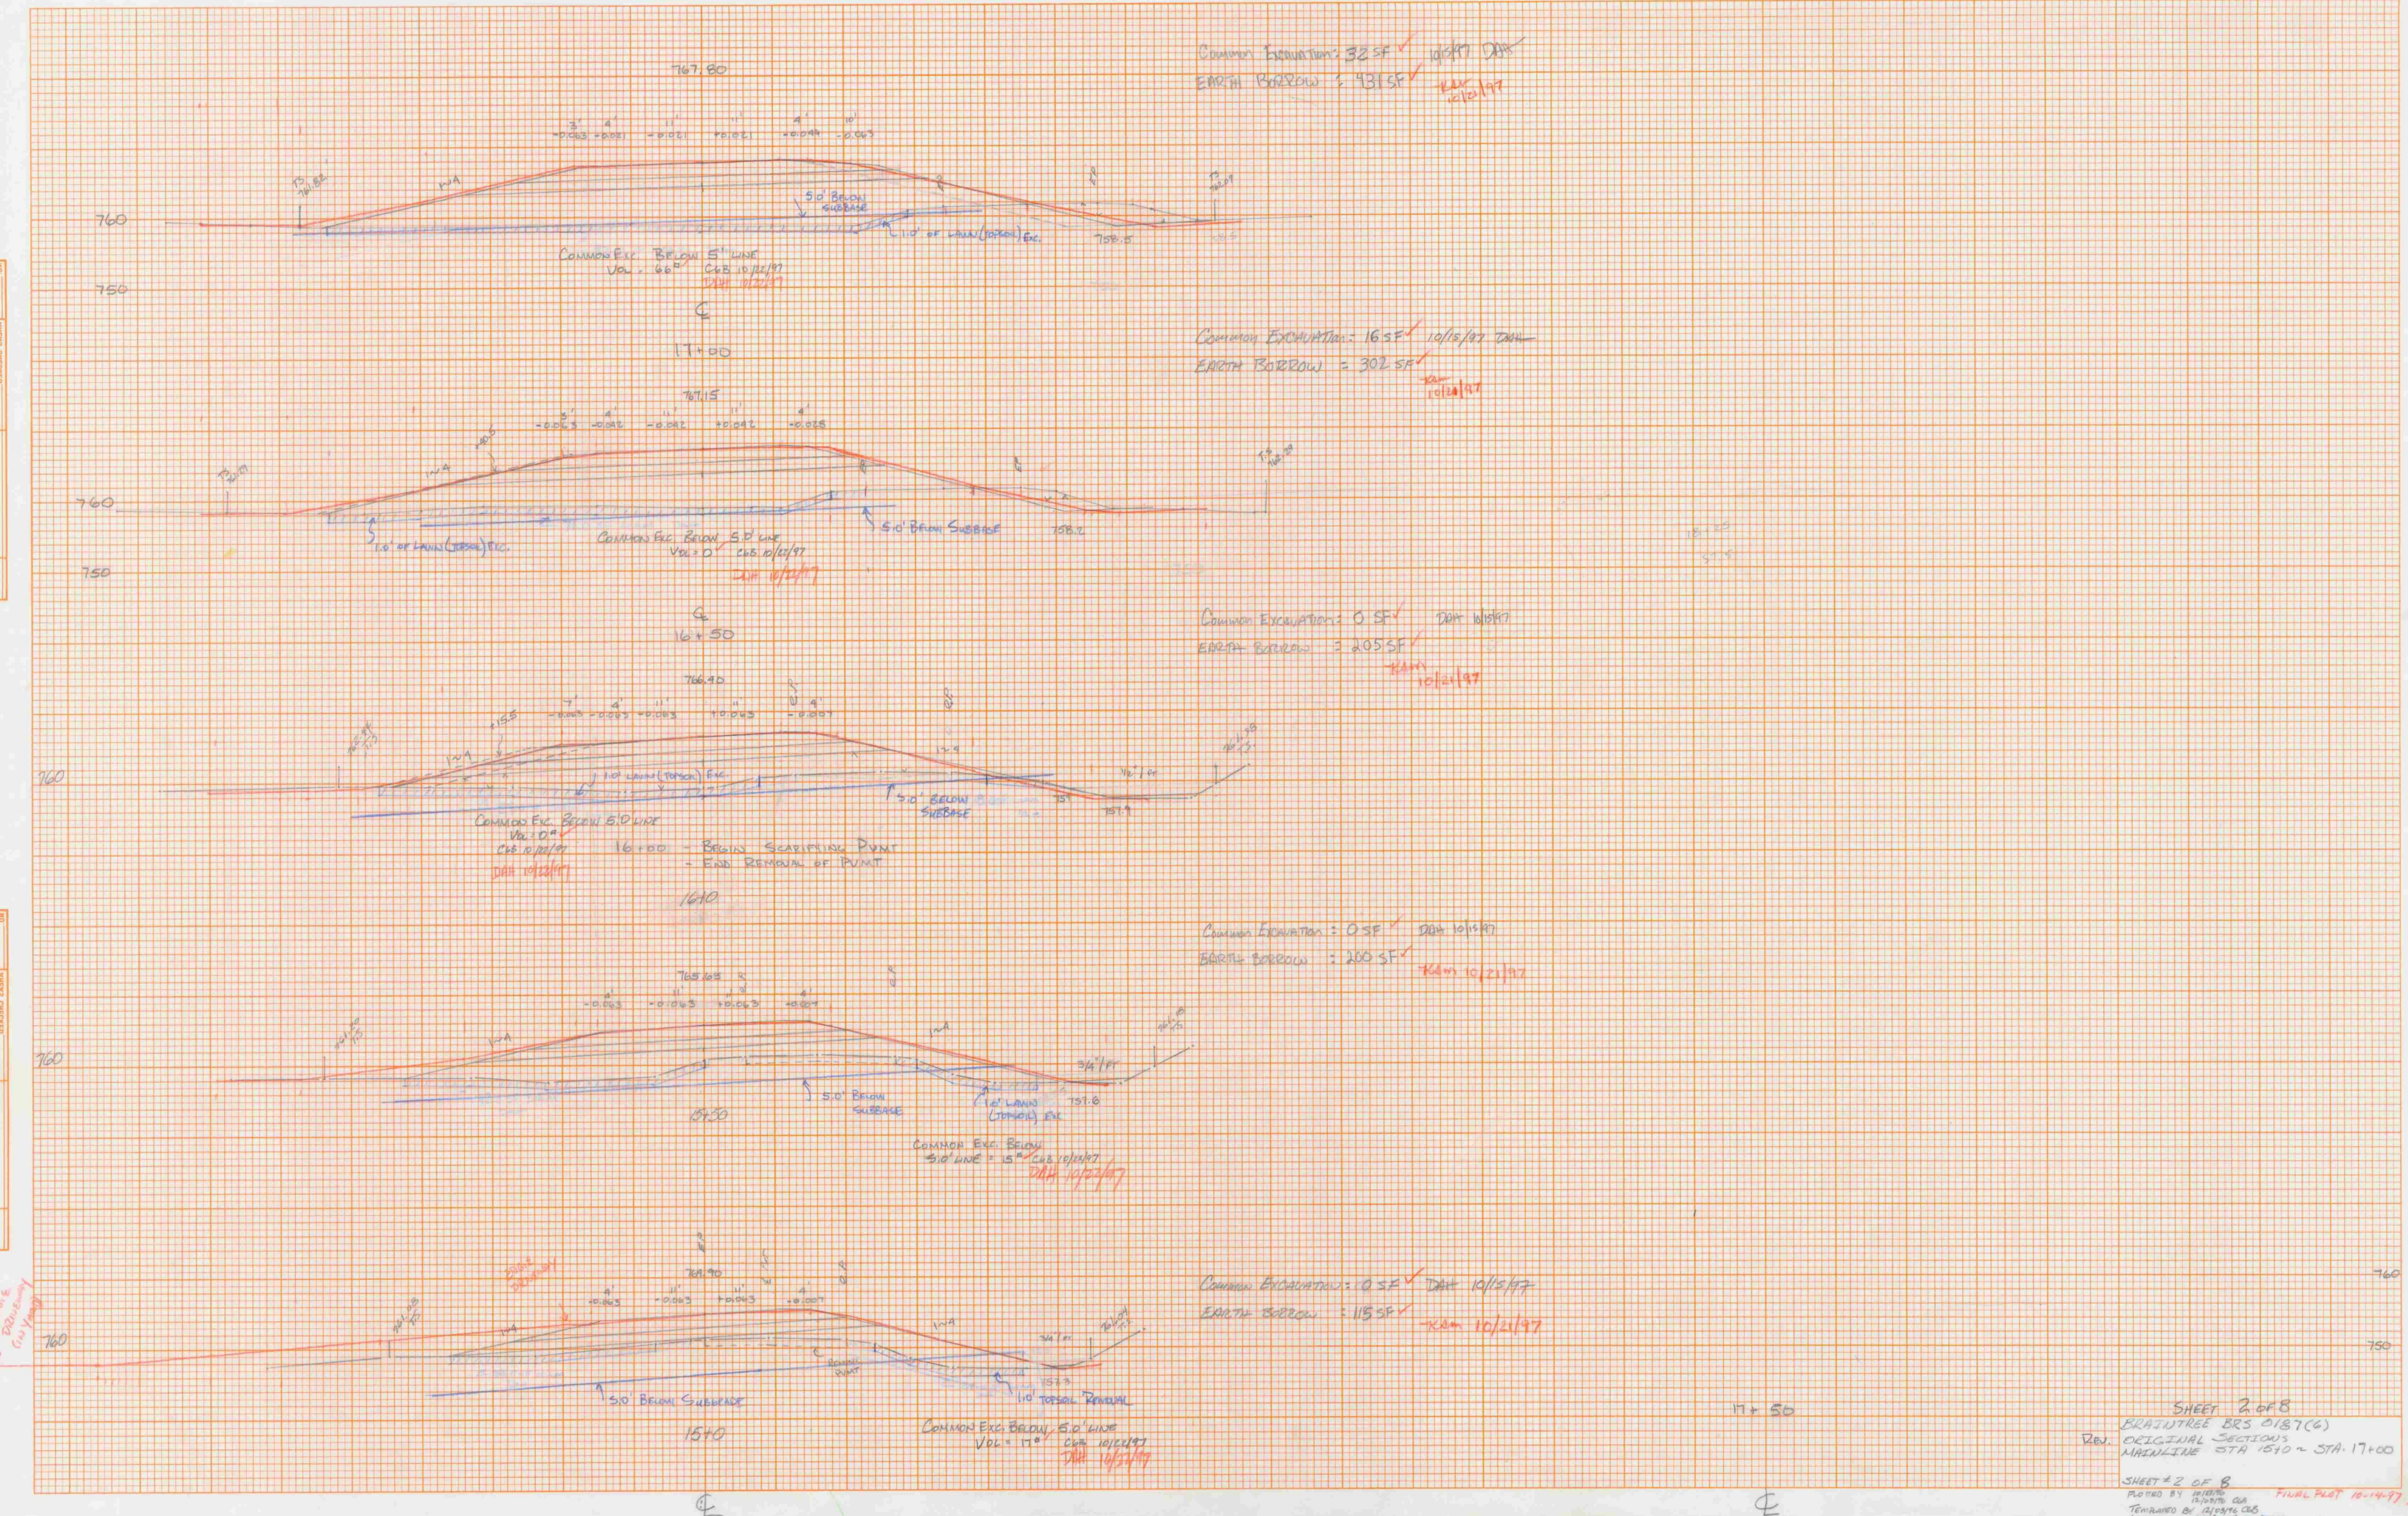

SHEET 2 OF 8
 LOCAL TREE ERS (187) (6)
 ORIGINAL SECTION'S
 MAXIMUM STA 1510 - STA 17+00
 SHEET 2 OF 8
 PLOTTED BY [Name]
 CHECKED BY [Name]
 DATE 10/14/97
 MAX 10/14/97