
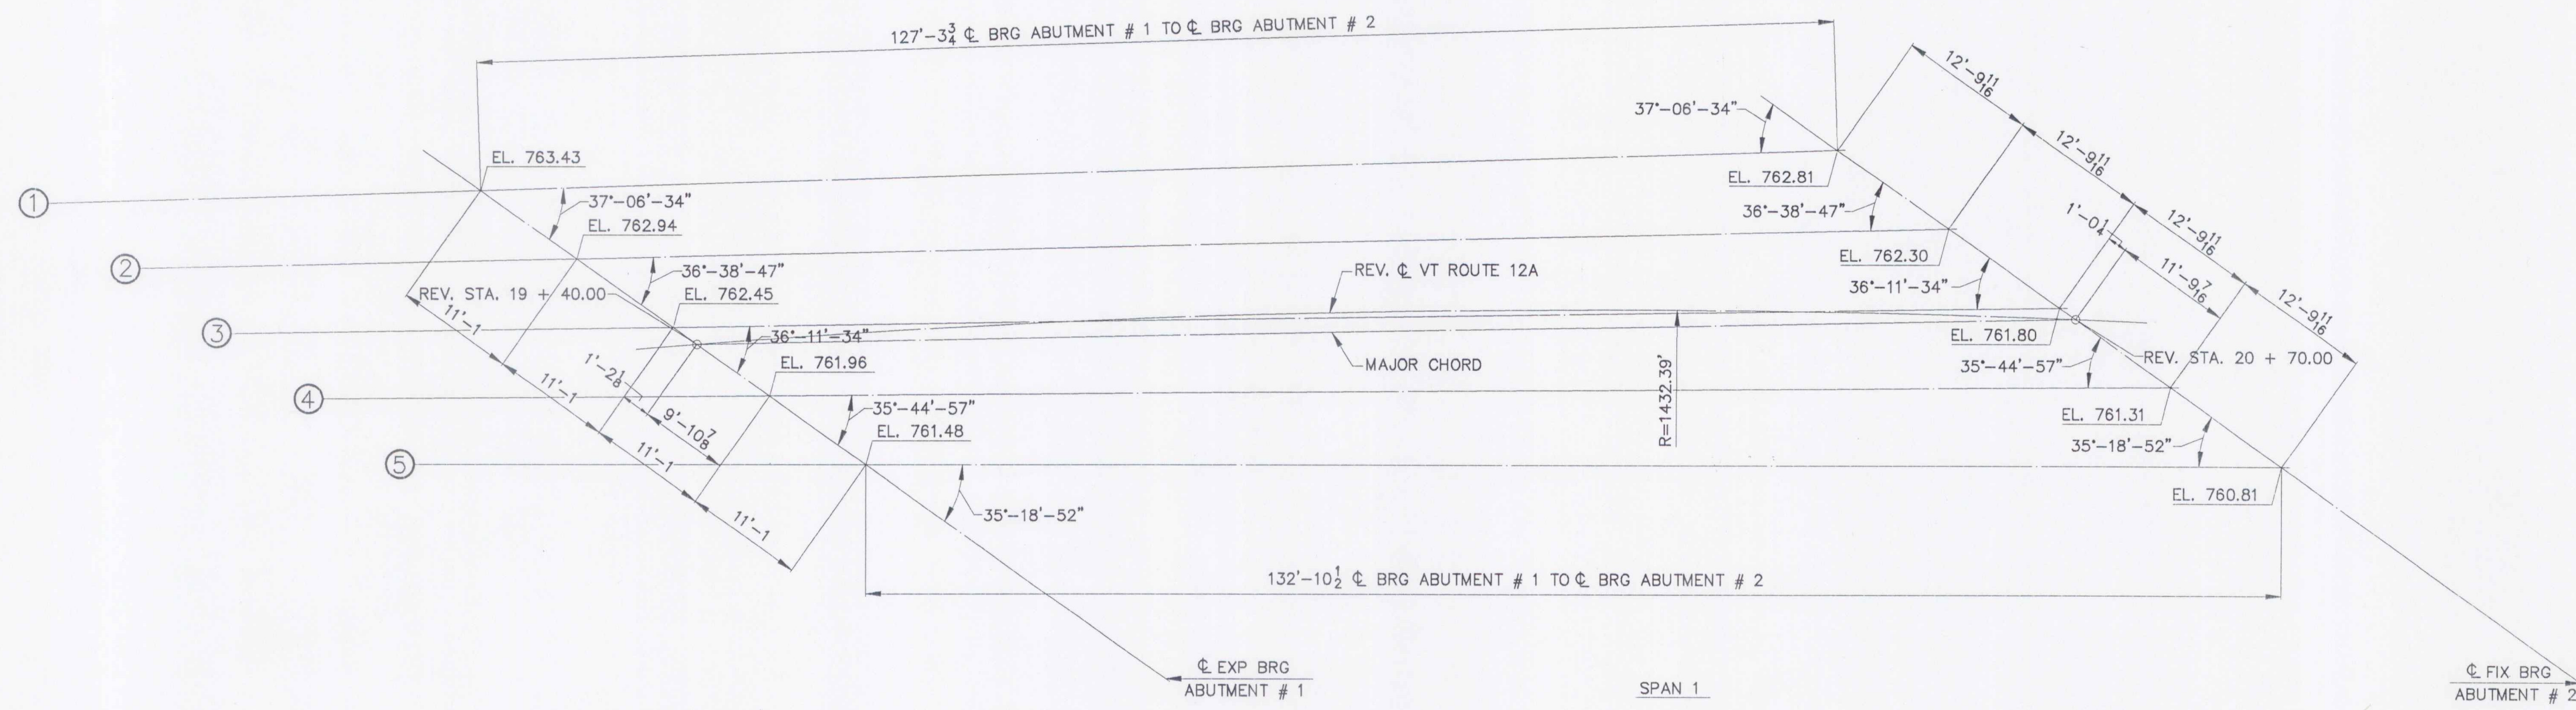


WORK ORDER NO.	DRAWING NO.	REV.
15717	E1	

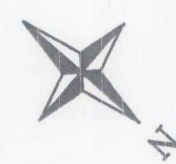

BRIDGE GEOMETRY

(FOR REFERENCE ONLY)

1- SHAP PROFILE
 1- P&D PROFILE
 1- PLAN - CA
 1- PLAN - S&P
 4- 11' H&B - SHAP
 1- 11' H&B - DEPT
 2- F&B
 DWG: 201
 2/1/96 201
 10"

NOTES
 1. DIMENSIONS SHOWN ARE HORIZONTAL AND DO NOT REFLECT ANY CHANGE DUE TO GRADE.
 2. ELEVATIONS ARE TO TOP OF CONCRETE PADS.

ITEM NO. 506.55	BRIDGE NO. 6	PROJ. NO. BRS 0187(6)
TITLE: BRIDGE GEOMETRY		
APPROVED: 11-25-96	National Eastern Corporation Plainville, Connecticut	
PRINT DIST: 7	APPR: 10/20/96	FAB: 12-2-96
ORIG: 10/16	6-2-97	V.H.T.
JOB: VT ROUTE 12A OVER 3RD BRANCH OF THE WHITE RIVER BRAINTREE, VERMONT		
CUSTOMER: MILLER CONSTRUCTION, INC.		
DESIGNER: VERMONT AGENCY OF TRANSPORTATION		
CHECKED: 10/96	(CSD)	
DRAWN: 10/96	CSD	
15717	E1	