


CAMBER DIAGRAM ~ G1A



NOTES
 1. ALL MATERIAL SHALL CONFORM TO A709 GR 50W T2.

ITEM NO.	508.55	BR. NO.	6	PROJ. NO.	BRS 0187(6)
TITLE:	CAMBER DIAGRAM ~ G1A				
APPROVED:	11-25-96	PRINT DIST.			
ORIG	7/20/96	APPR			
DRWG	6-2-96	FAB.			
JOB:			VT ROUTE 12A OVER 3RD BRANCH OF THE WHITE RIVER BRAINTREE, VERMONT		
CUSTOMER:			MILLER CONSTRUCTION, INC.		
DESIGNER:			VERMONT AGENCY OF TRANSPORTATION		
WORK ORDER NO.			DRAWING NO.		
15717			10-2		
CHECKED	10/96	CSD			
DRAWN	10/96	CSD			

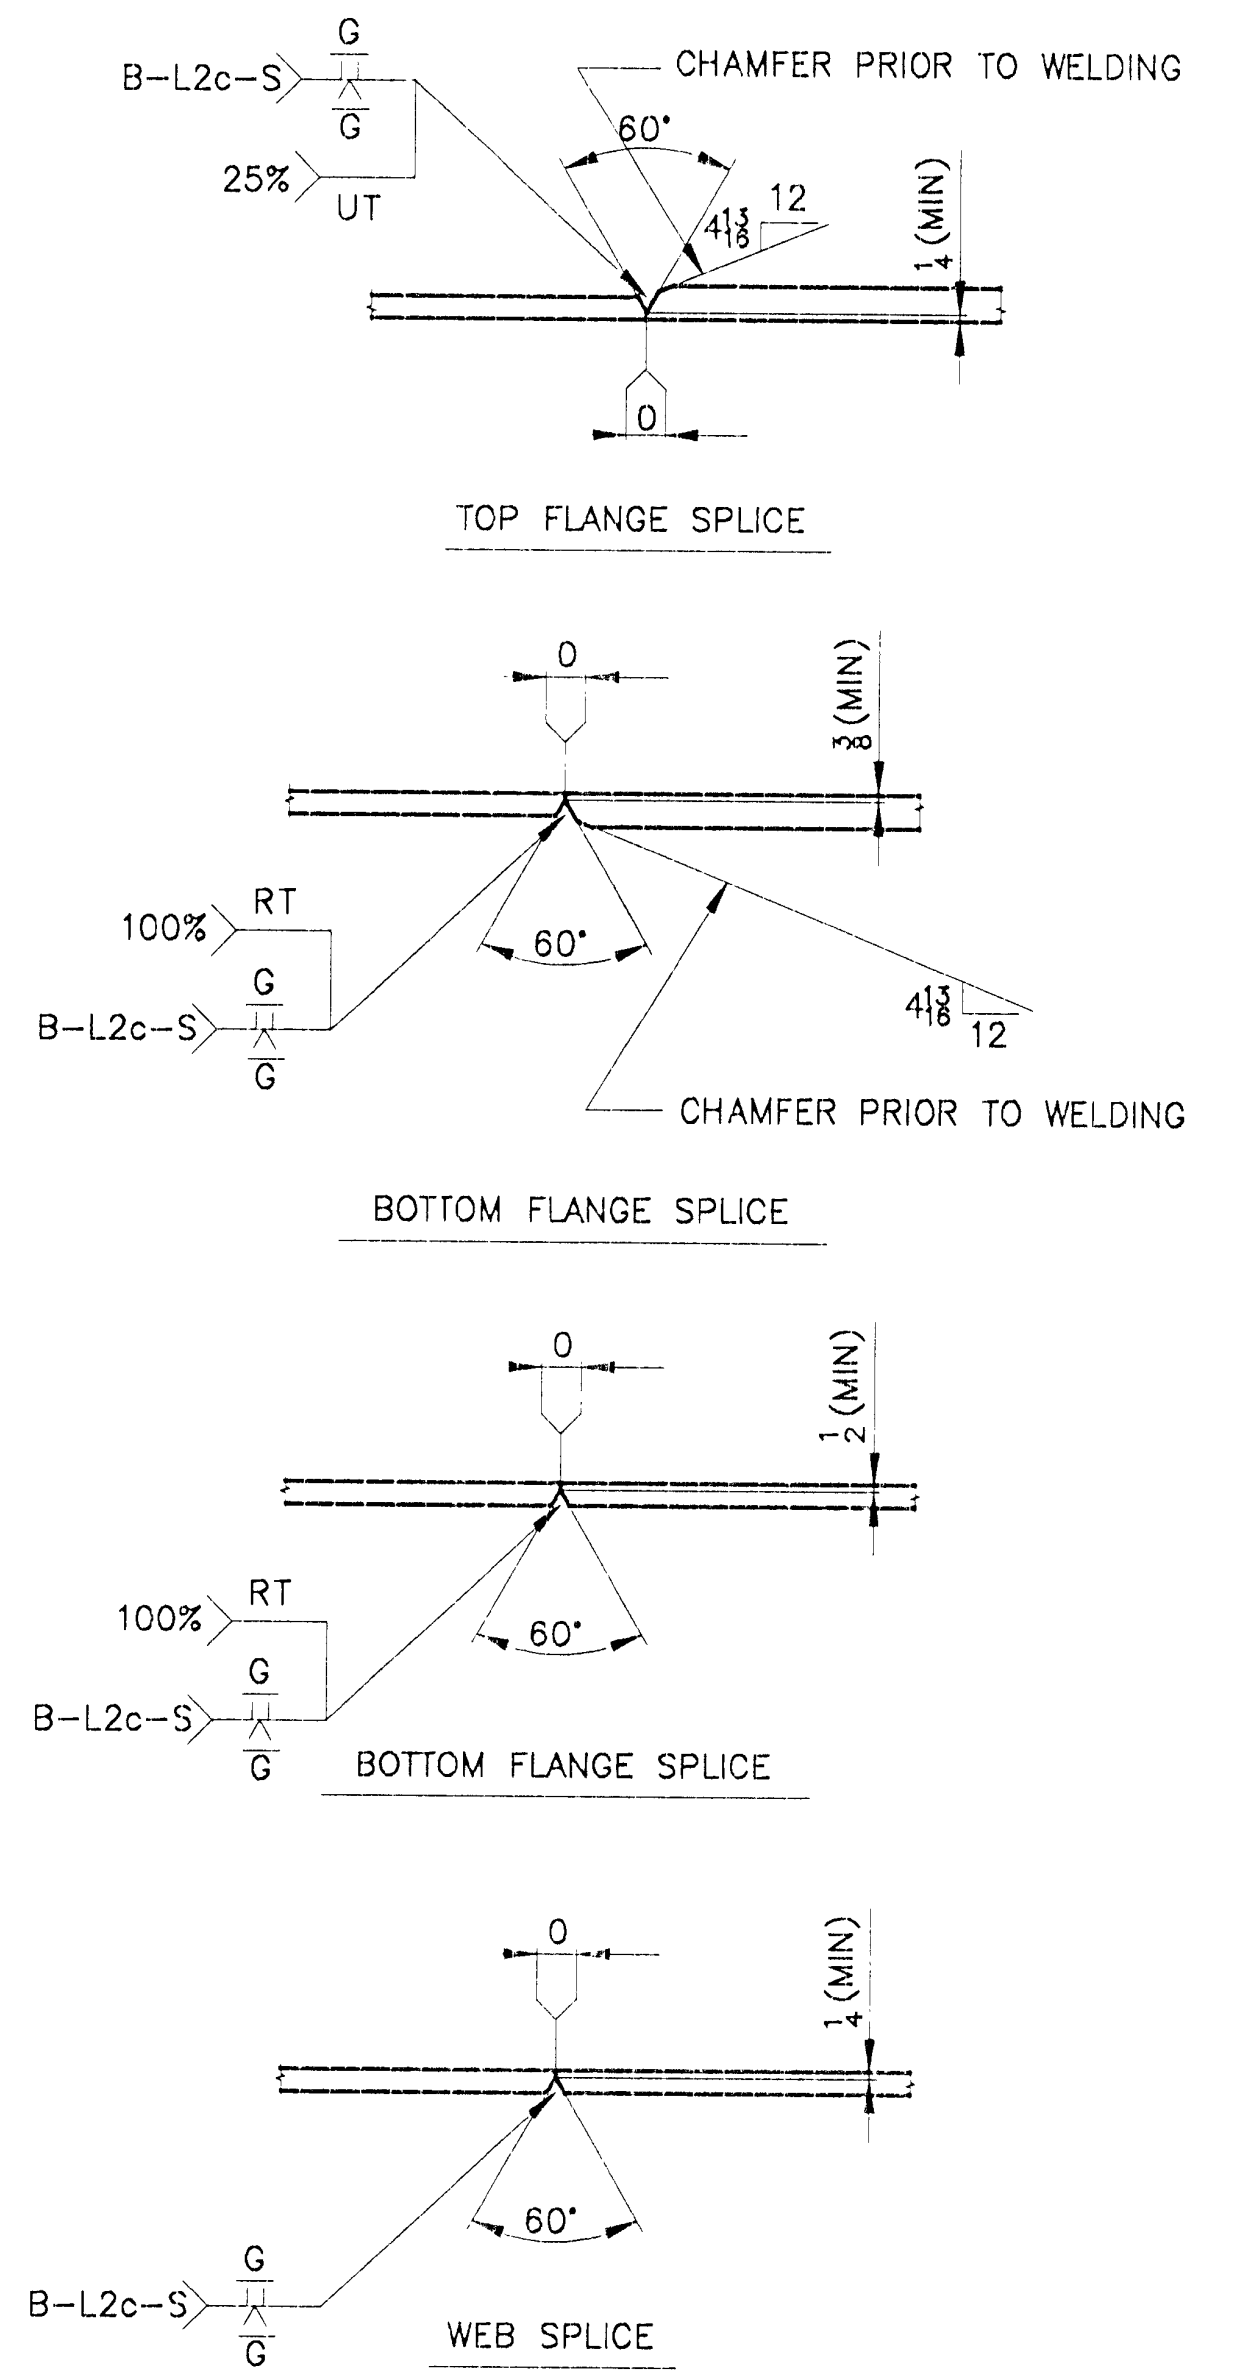