
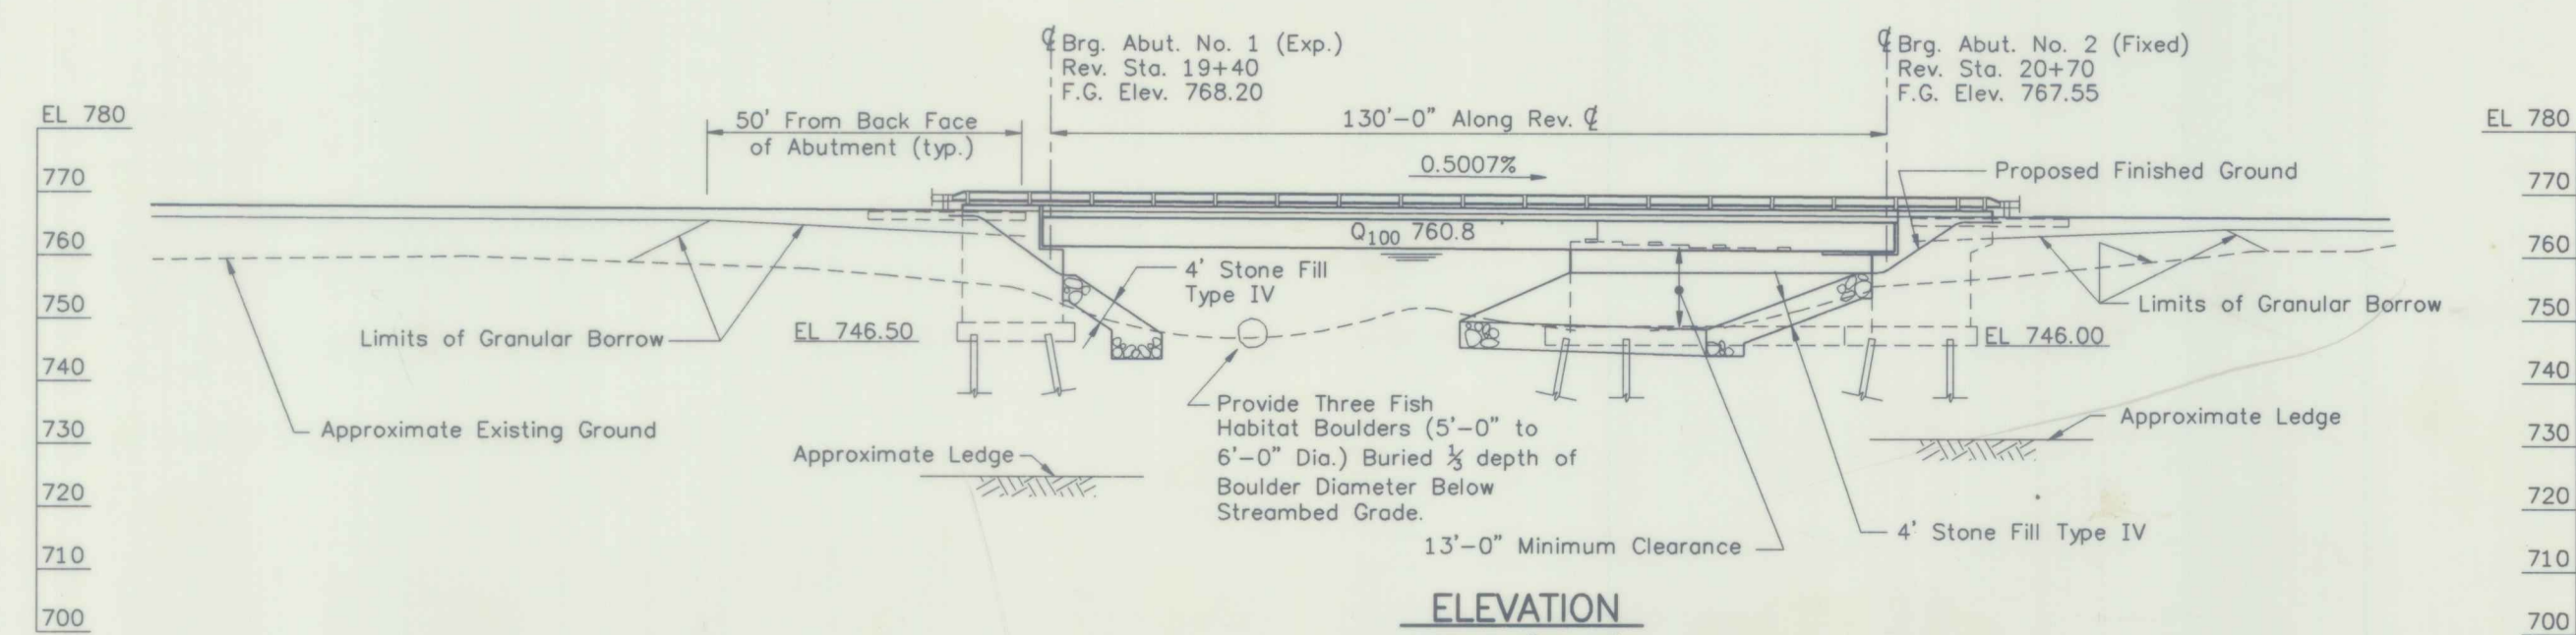


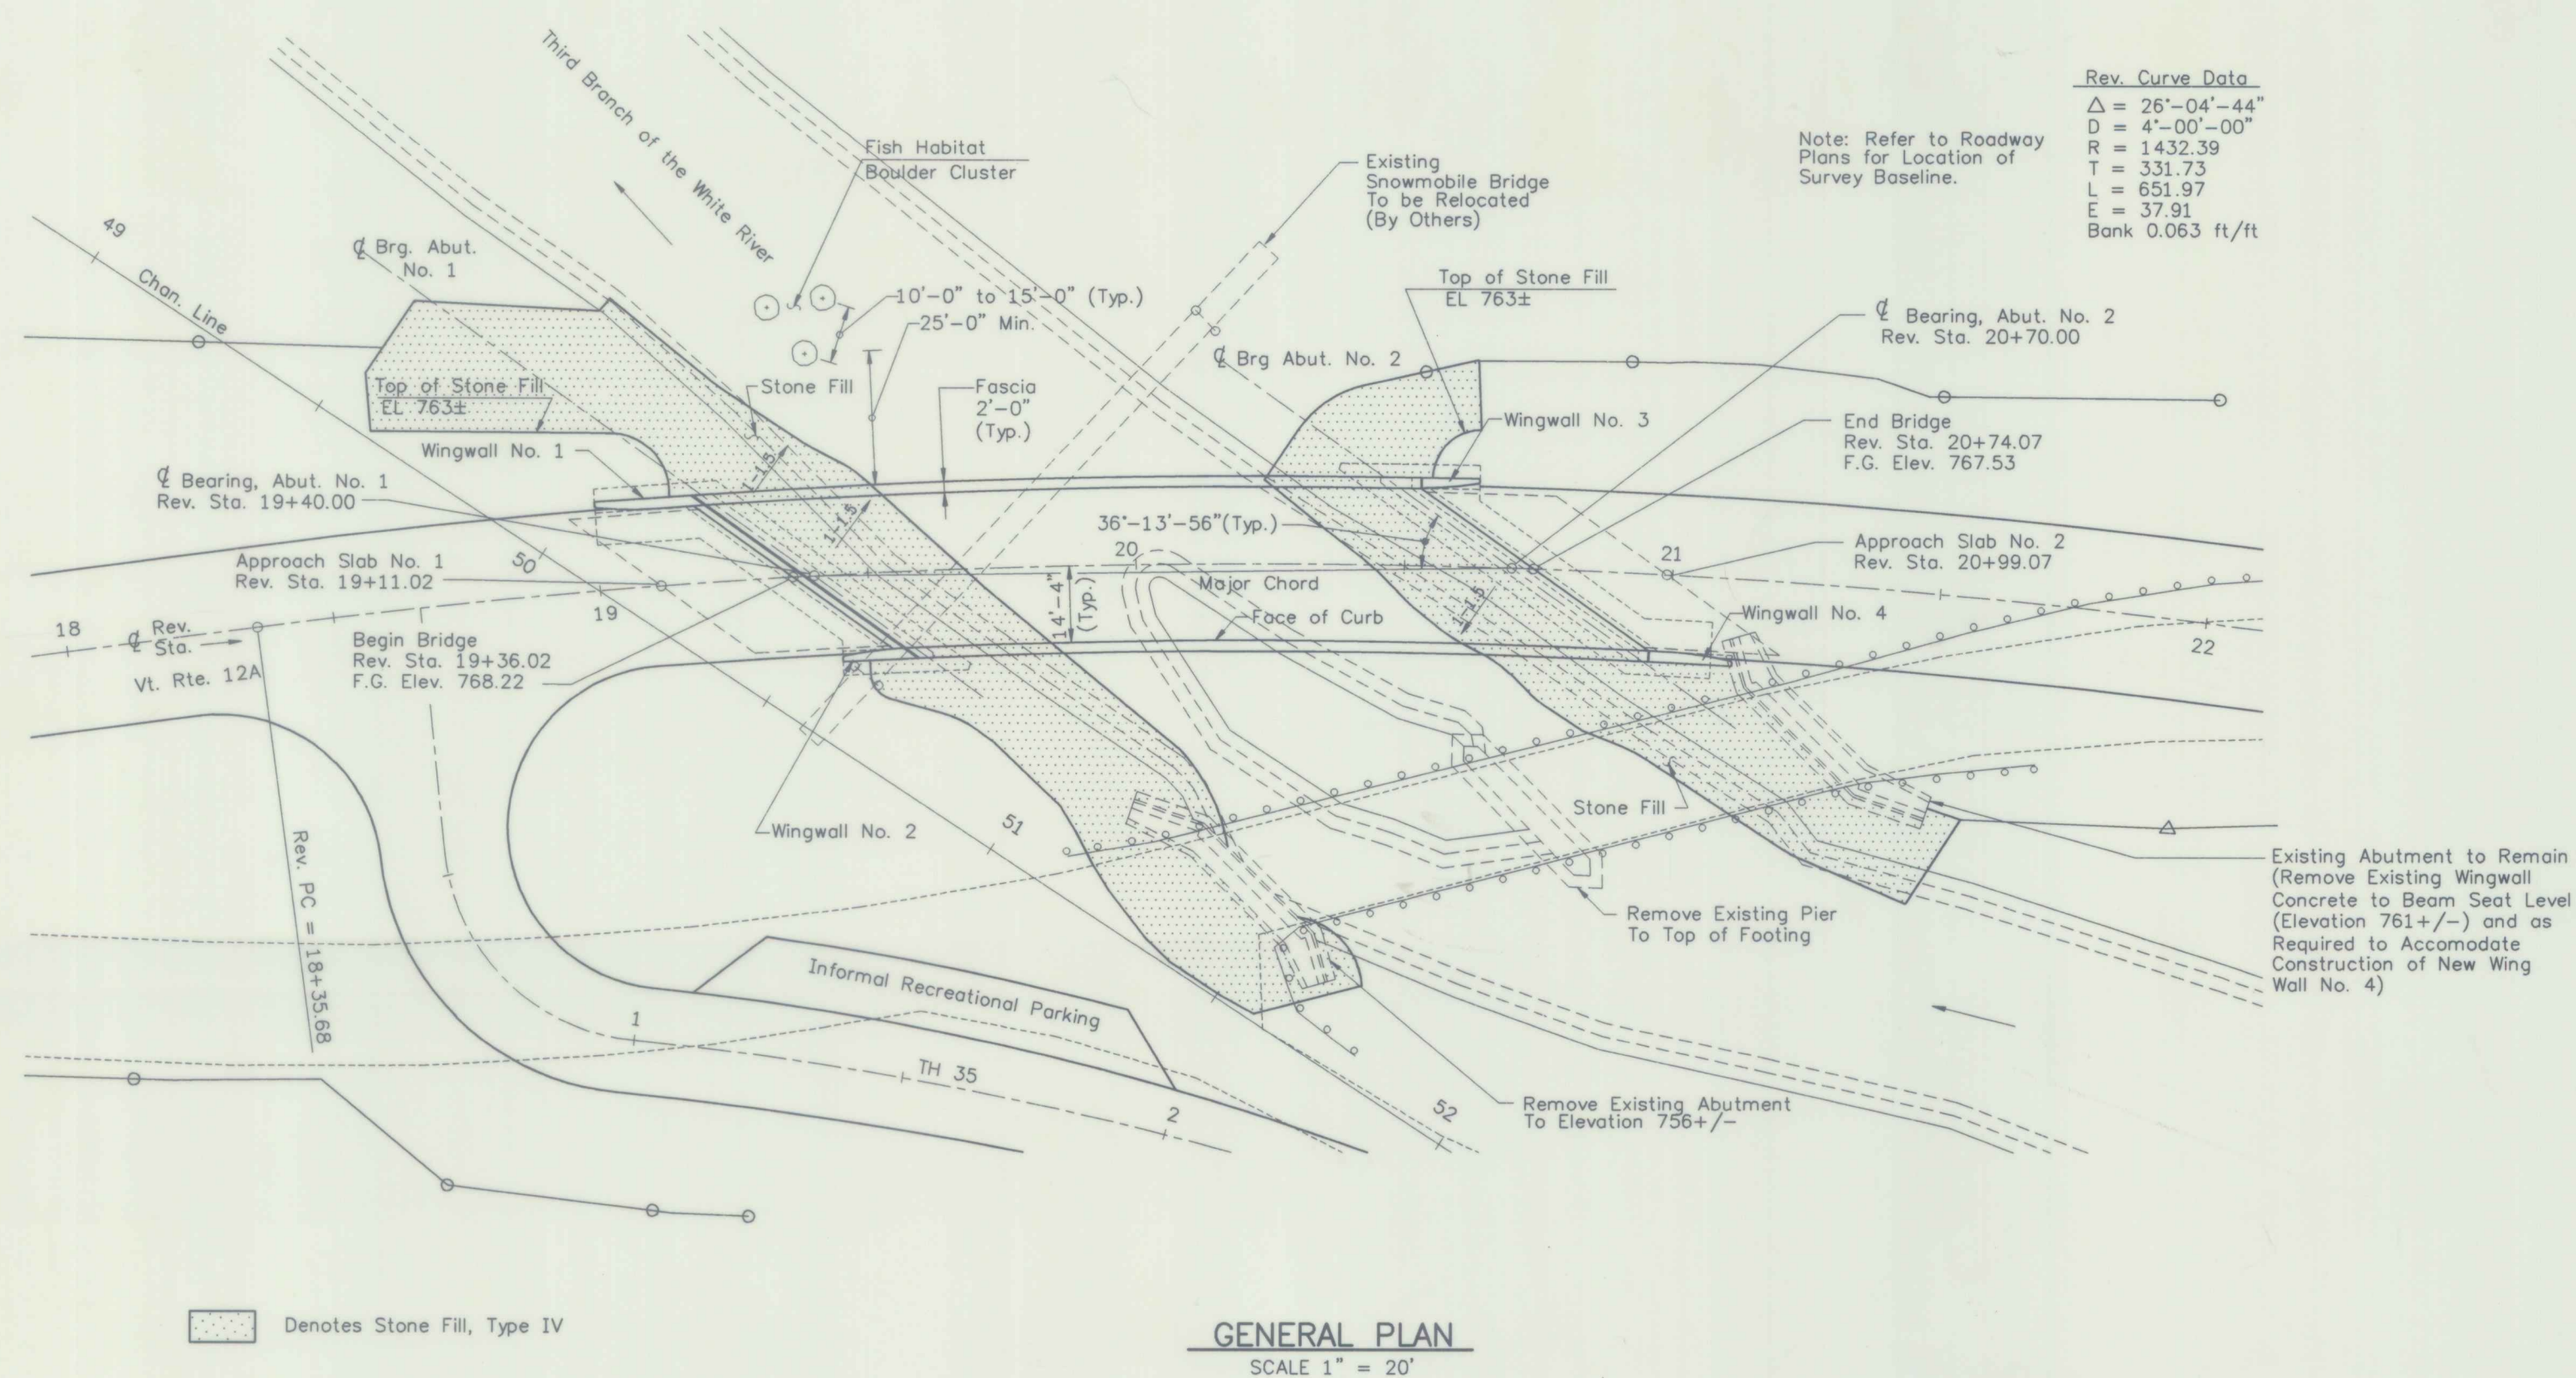

STATE OF VERMONT AGENCY OF TRANSPORTATION			
Town Of	BRAINTREE	Bridge No.	6
Highway No.	VT RTE 12A	Log Sta.	
VT RTE 12A OVER 3RD BRANCH OF THE WHITE RIVER			
PLAN AND ELEVATION			
Designed By	LNI	Drawn By	JLF
Checked By	Date	Bridge Design Supervisor	Date
BRAINTREE BRS 0187(6) R.O.W. SHEET 6 OF 10 SHEETS			

CLD
 CONSULTING ENGINEERS
 545 SUMMIT STREET
 MONTPELIER, VT 05602
 (802) 848-8222 FAX (802) 848-8802