



PLAN	SURVEYED	DATE
	PLOTTED	
	ALIGNED	
	CHECKED	
	BY	
	NO.	
	NO.	

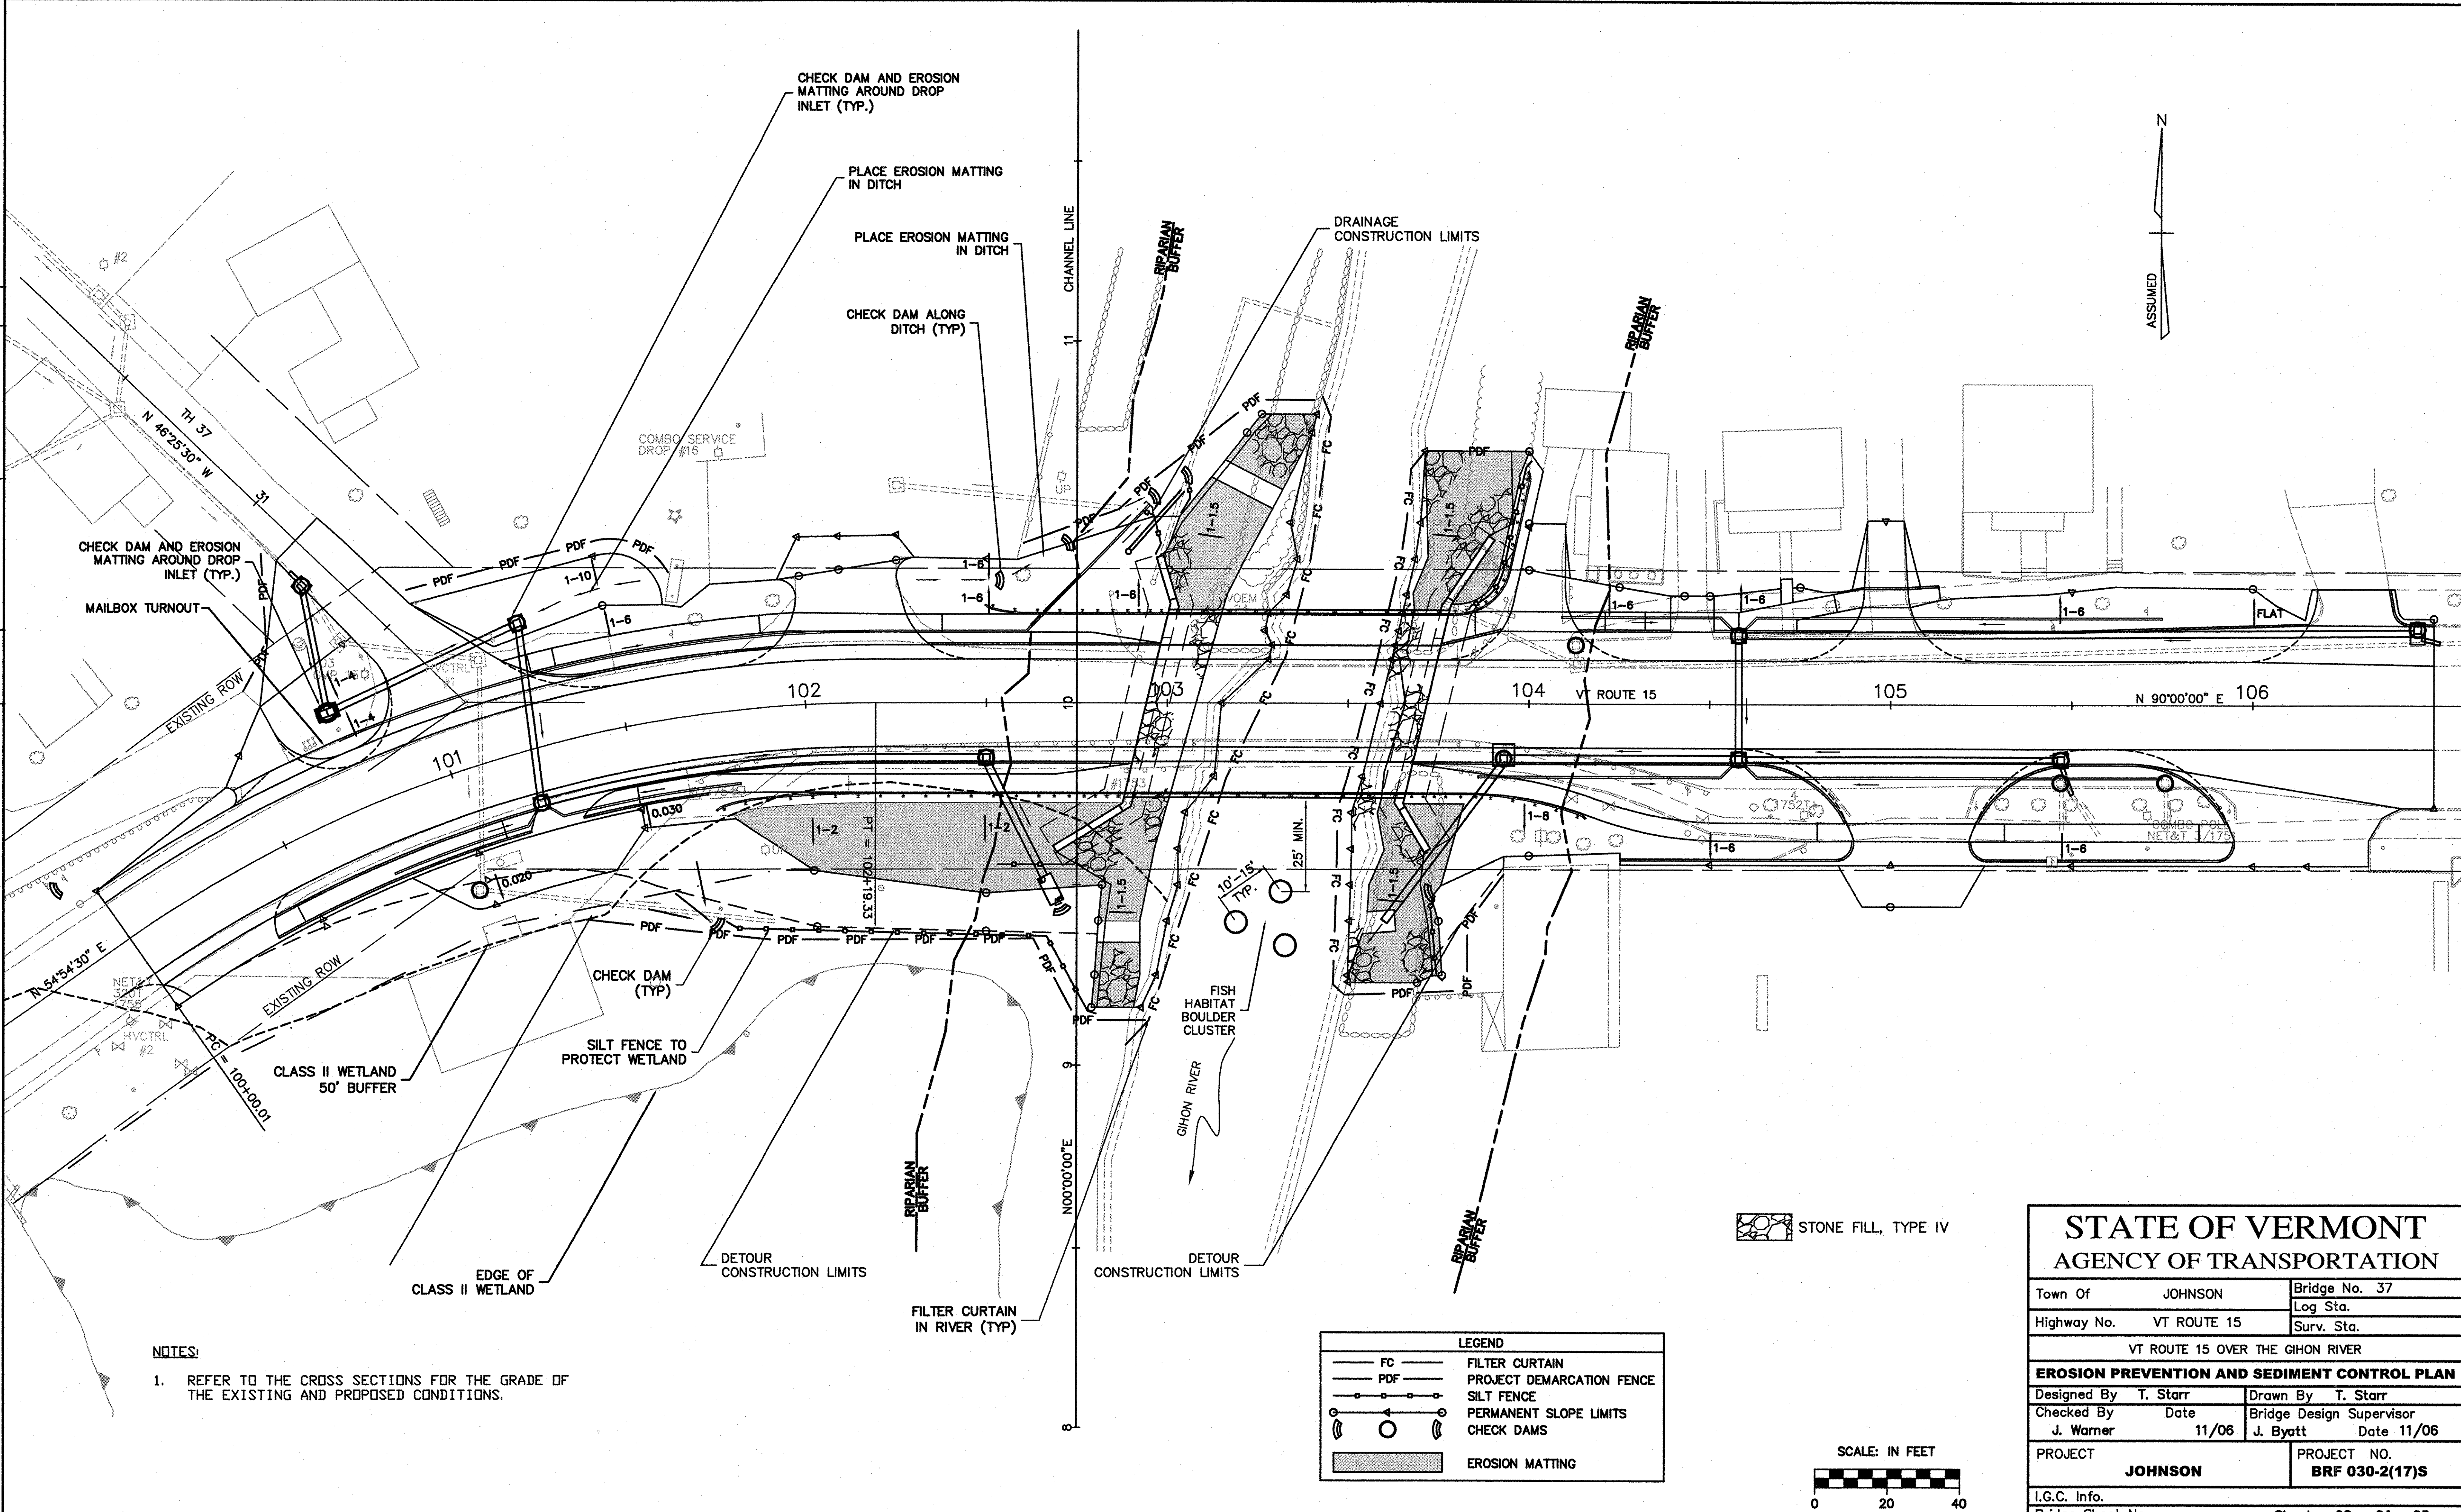

NOTES:
 1. REFER TO THE CROSS SECTIONS FOR THE GRADE OF THE EXISTING AND PROPOSED CONDITIONS.

LEGEND	
	FILTER CURTAIN
	PROJECT DEMARCATON FENCE
	SILT FENCE
	PERMANENT SLOPE LIMITS
	CHECK DAMS
	EROSION MATTING

STONE FILL, TYPE IV

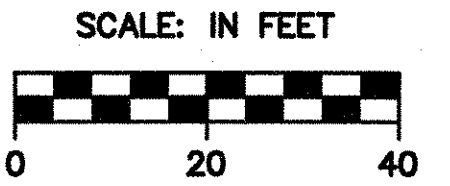

STATE OF VERMONT			
AGENCY OF TRANSPORTATION			
Town Of	JOHNSON	Bridge No.	37
		Log Sta.	
Highway No.	VT ROUTE 15	Surv. Sta.	
VT ROUTE 15 OVER THE GIHON RIVER			
EROSION PREVENTION AND SEDIMENT CONTROL PLAN			
Designed By	T. Starr	Drawn By	T. Starr
Checked By	Date	Bridge Design Supervisor	
J. Warner	11/06	J. Byatt	Date 11/06
PROJECT	JOHNSON	PROJECT NO.	BRF 030-2(17)S
I.G.C. Info.			
Bridge Sheet No.	Sheet 28	Of	85