




**GUARD RAIL TERMINAL DETAILS**

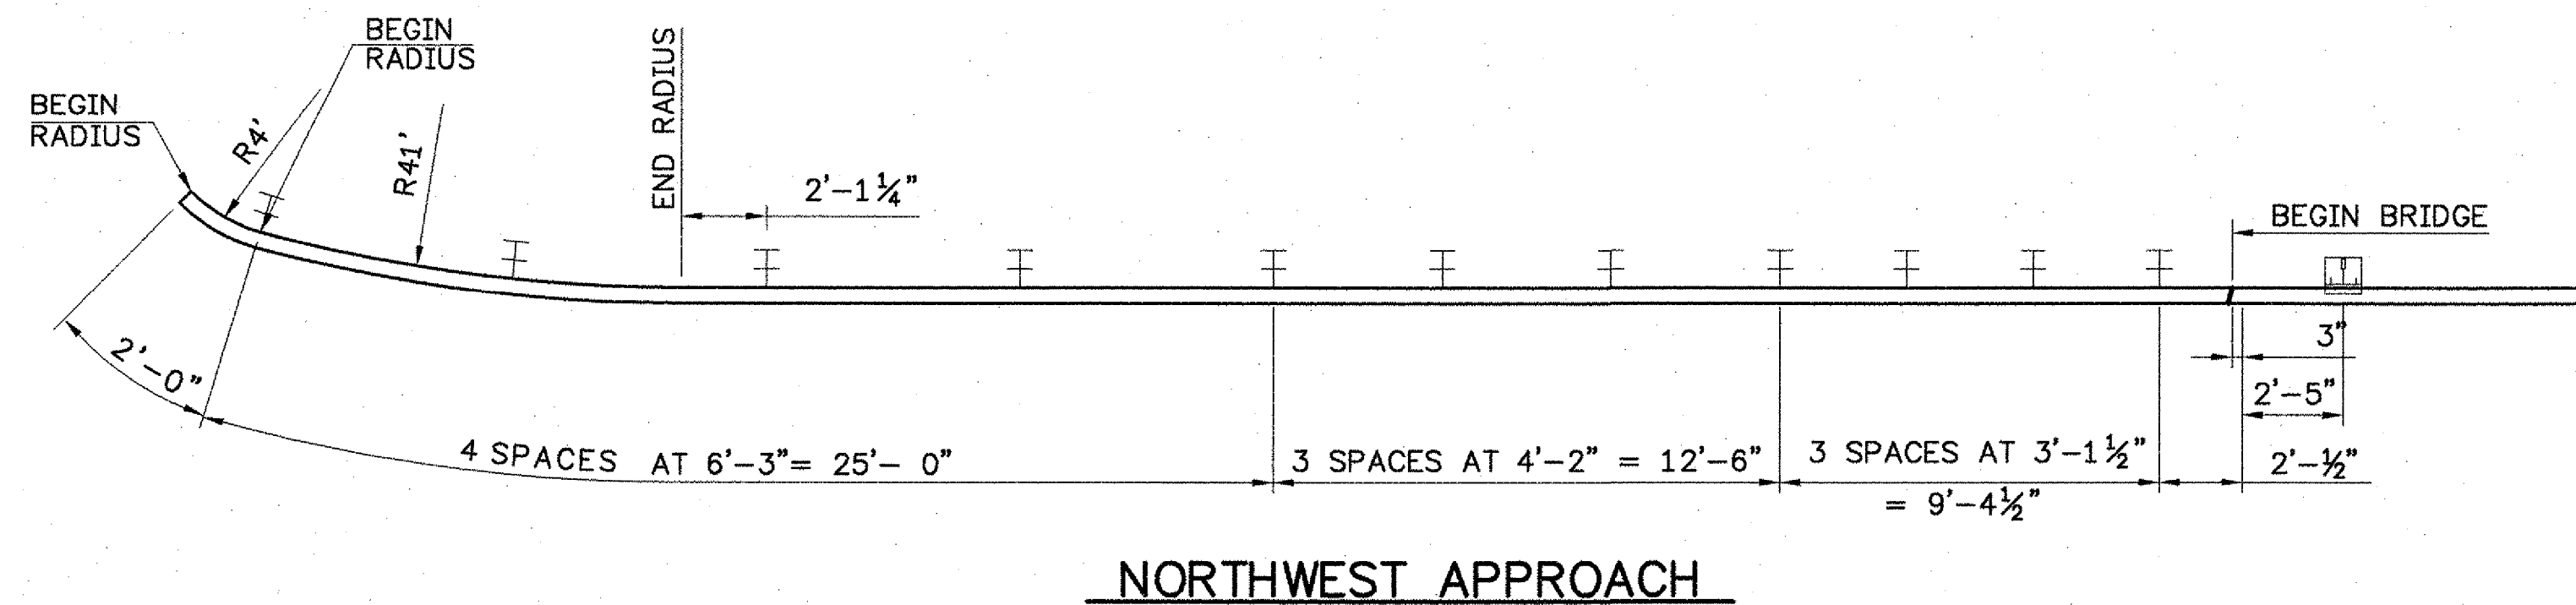


**NORTHWEST APPROACH**

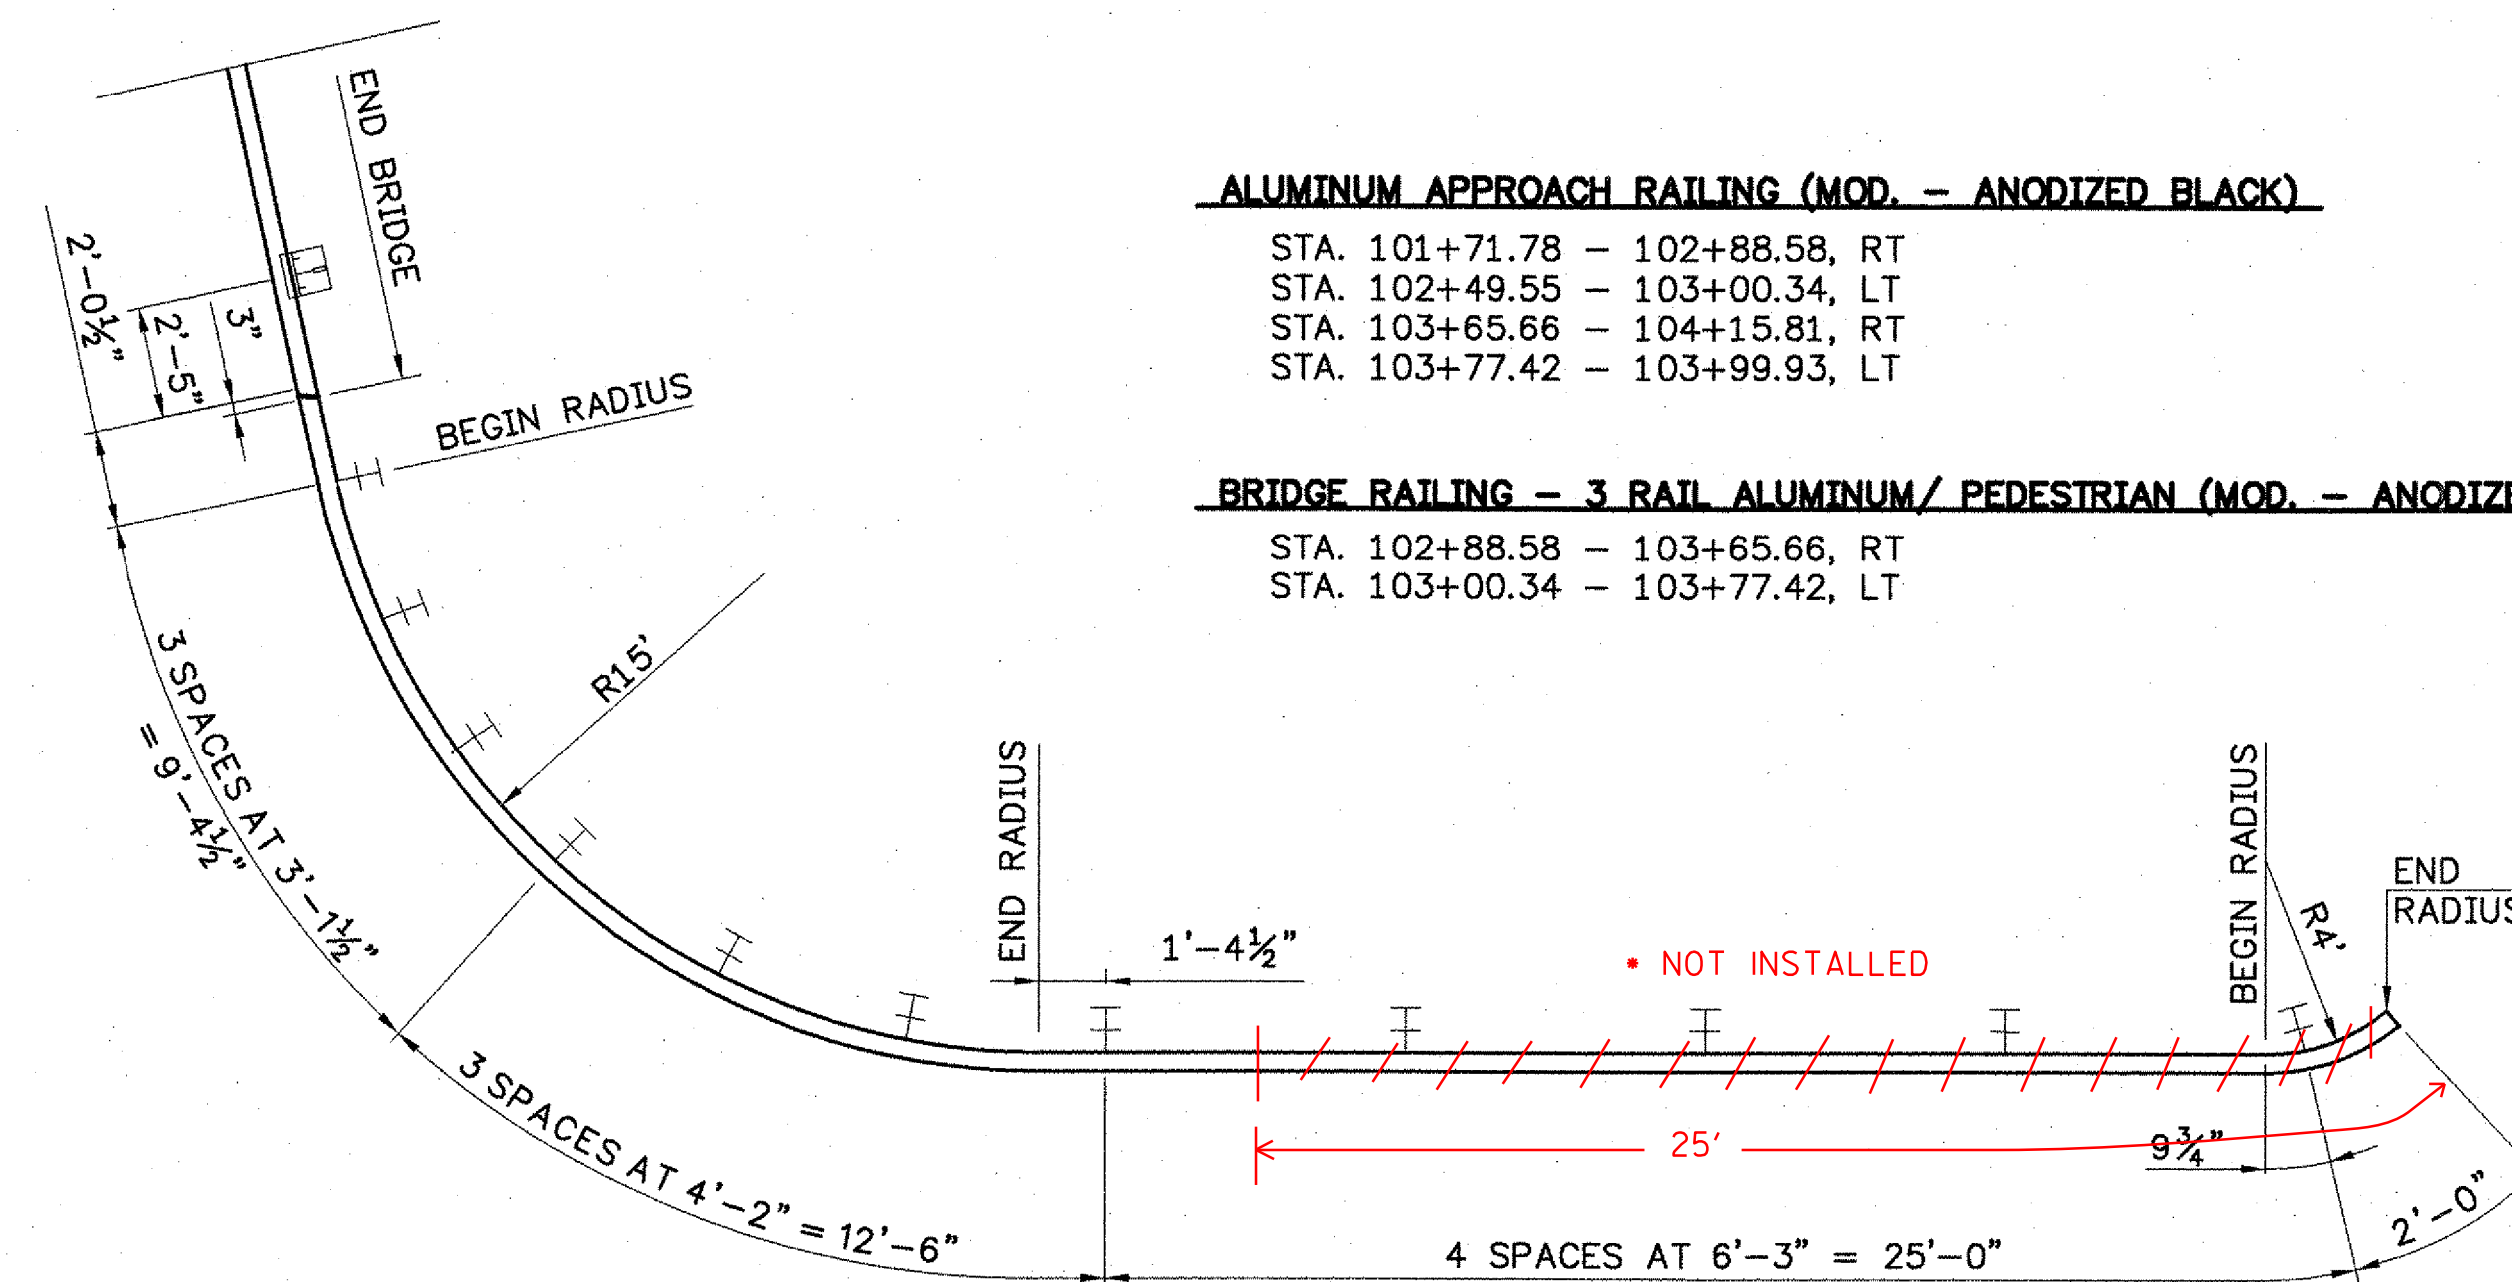

**NORTHEAST APPROACH**

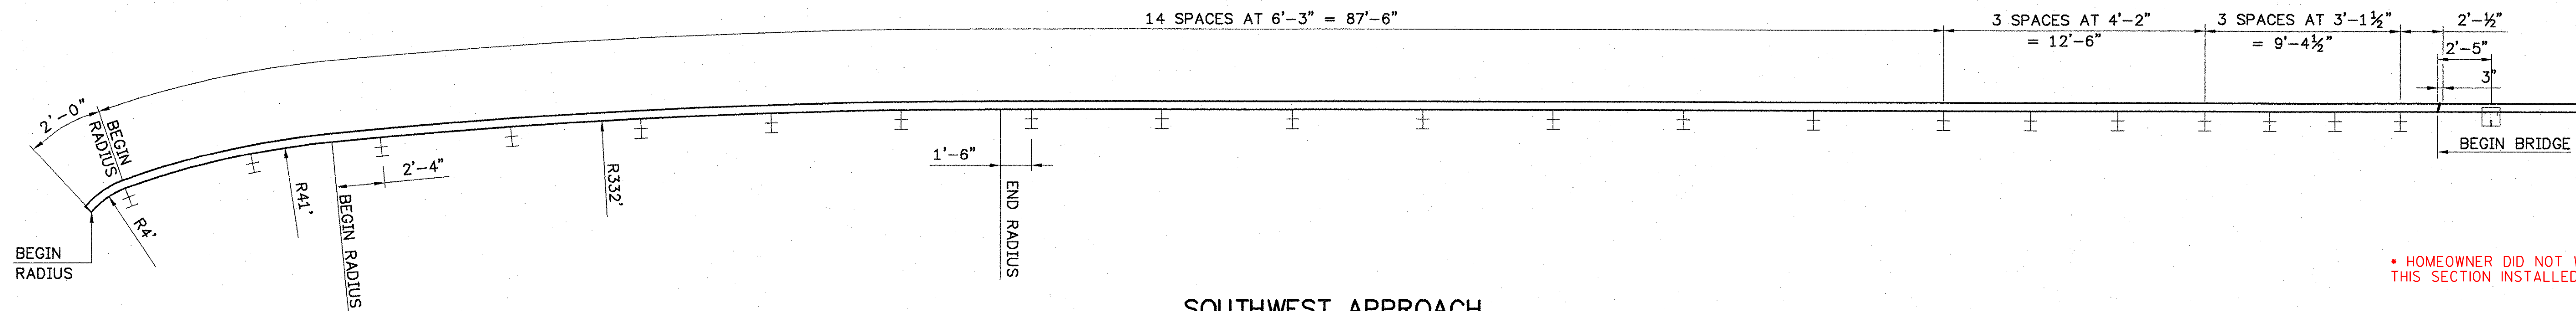

**SOUTHWEST APPROACH**

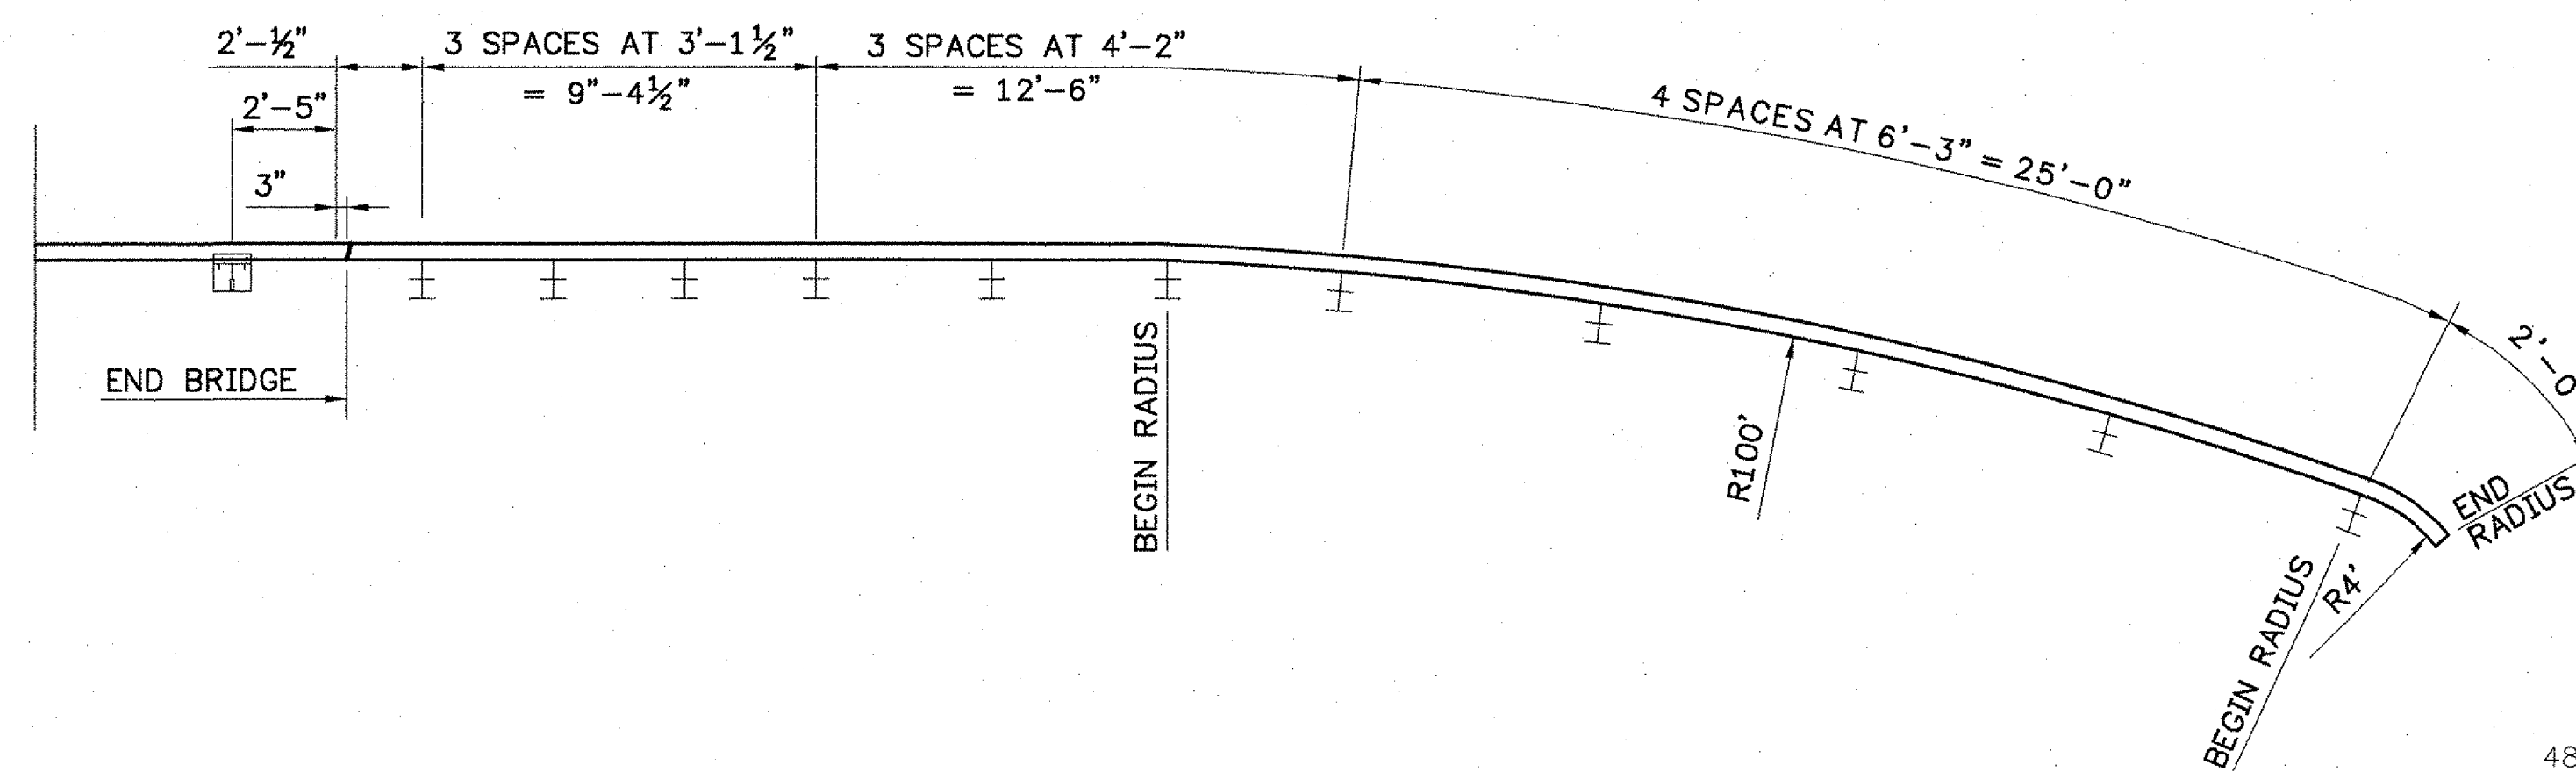

**SOUTHEAST APPROACH**


**ALUMINUM APPROACH RAILING (MOD. - ANODIZED BLACK)**

STA. 101+71.78 - 102+88.58, RT  
 STA. 102+49.55 - 103+00.34, LT  
 STA. 103+65.66 - 104+15.81, RT  
 STA. 103+77.42 - 103+99.93, LT


**BRIDGE RAILING - 3 RAIL ALUMINUM/ PEDESTRIAN (MOD. - ANODIZED BLACK)**

STA. 102+88.58 - 103+65.66, RT  
 STA. 103+00.34 - 103+77.42, LT

• HOMEOWNER DID NOT WANT THIS SECTION INSTALLED

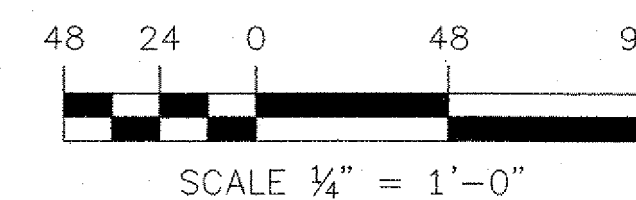

<b>STATE OF VERMONT AGENCY OF TRANSPORTATION</b>		
Town Of	JOHNSON	Bridge No. 37
Highway No.	VT. ROUTE 15	Log Sta.
		Surv. Sta.
VT. ROUTE 15 OVER GIHON RIVER		
<b>APPROACH RAIL DETAILS</b>		
Designed By	R.RICARD	Drawn By D.DUGAL
Checked By	Date	Bridge Design Supervisor
R.ROONEY	11/02	J. BYATT Date 11/06
<b>PROJECT</b>	JOHNSON	<b>PROJECT NO.</b> BRF 030-2(17)S
I.G.C. Info.		Bridge Sheet No.
		Sheet 60 Of 85

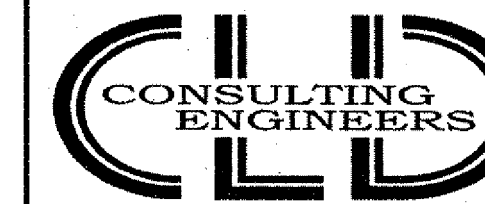

540 Commercial Street • Manchester, NH 03101  
 (603) 668-8223 • Fax: (603) 668-8802  
 cld@cldengineers.com • www.cldengineers.com  
 Maine • New Hampshire • Vermont

91296CFE.DWG