
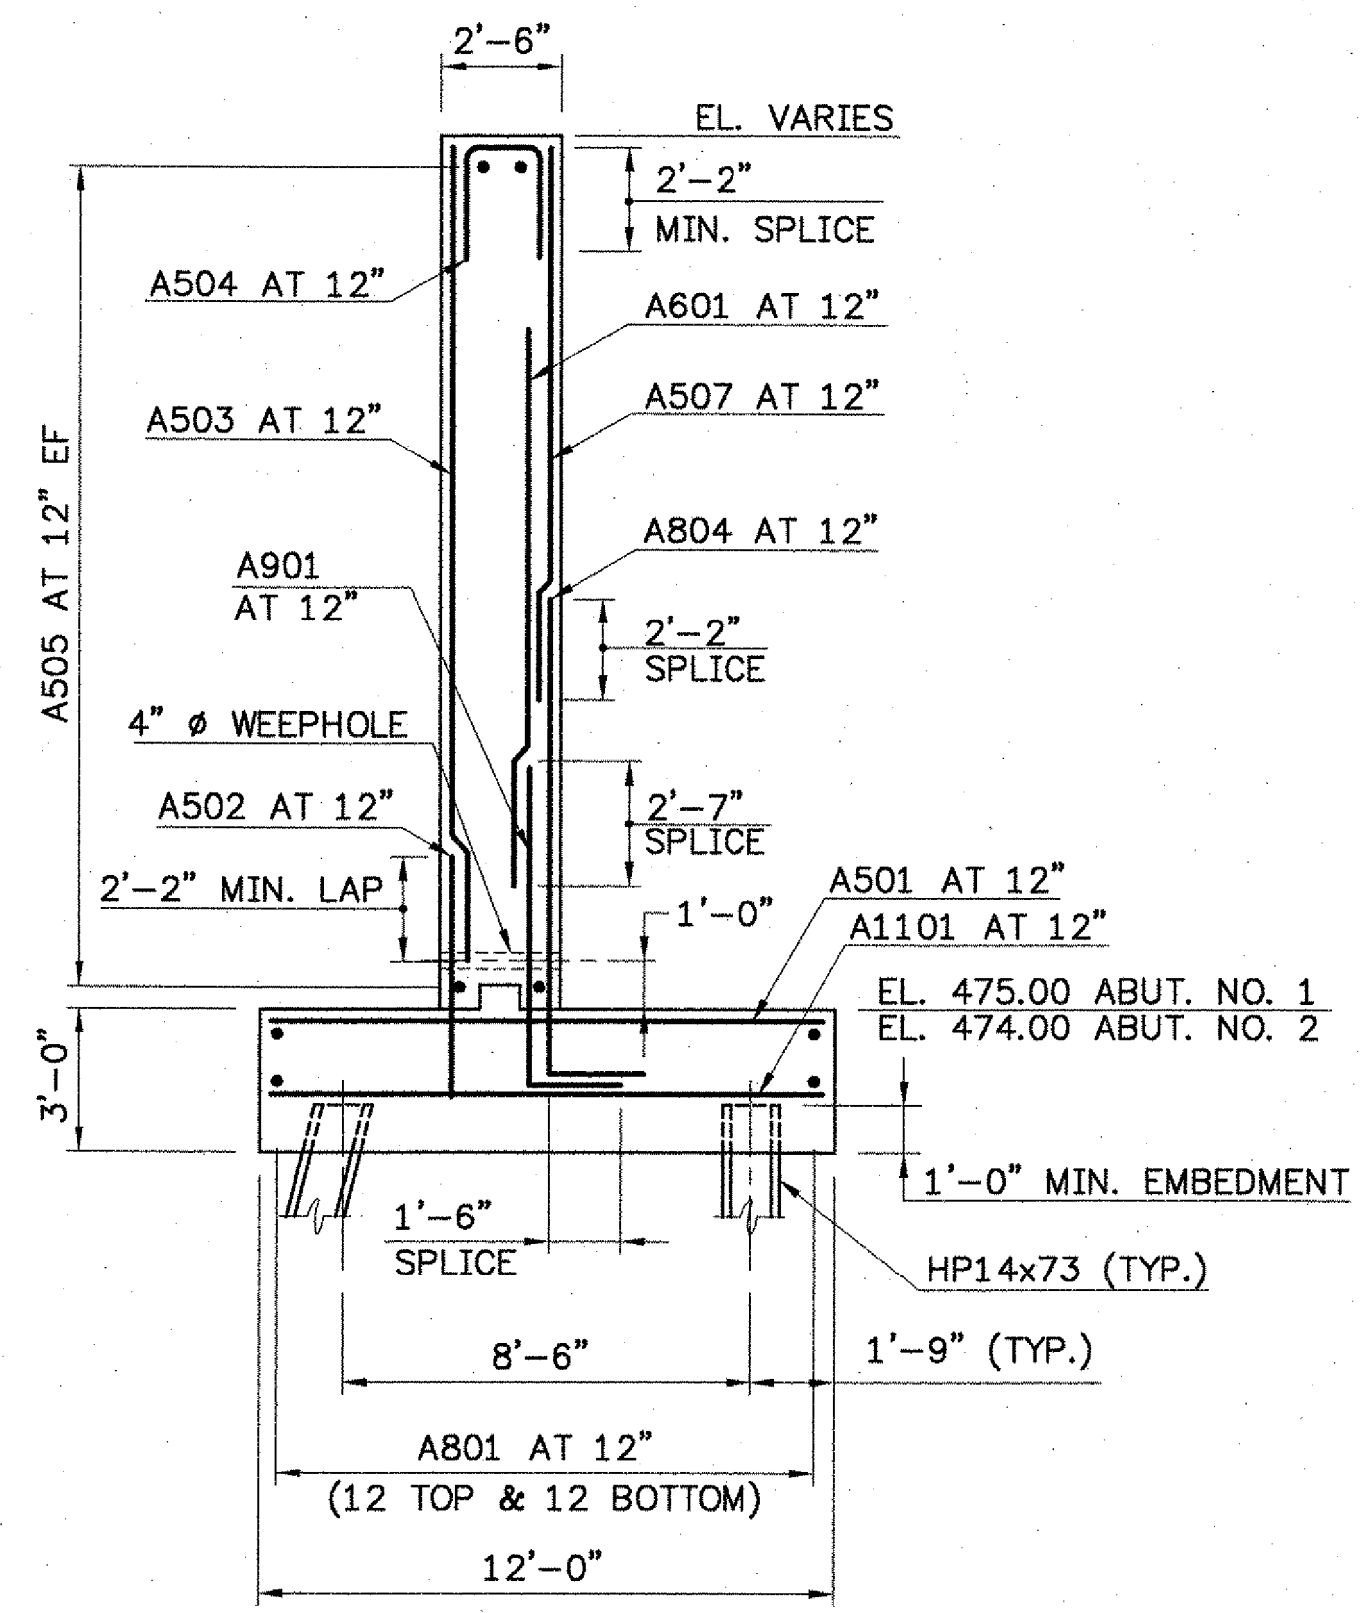


NOTES:
 NF = NEAR FACE
 FF = FAR FACE
 EF = EACH FACE
 ▲ = CUT TO FIT IN FIELD

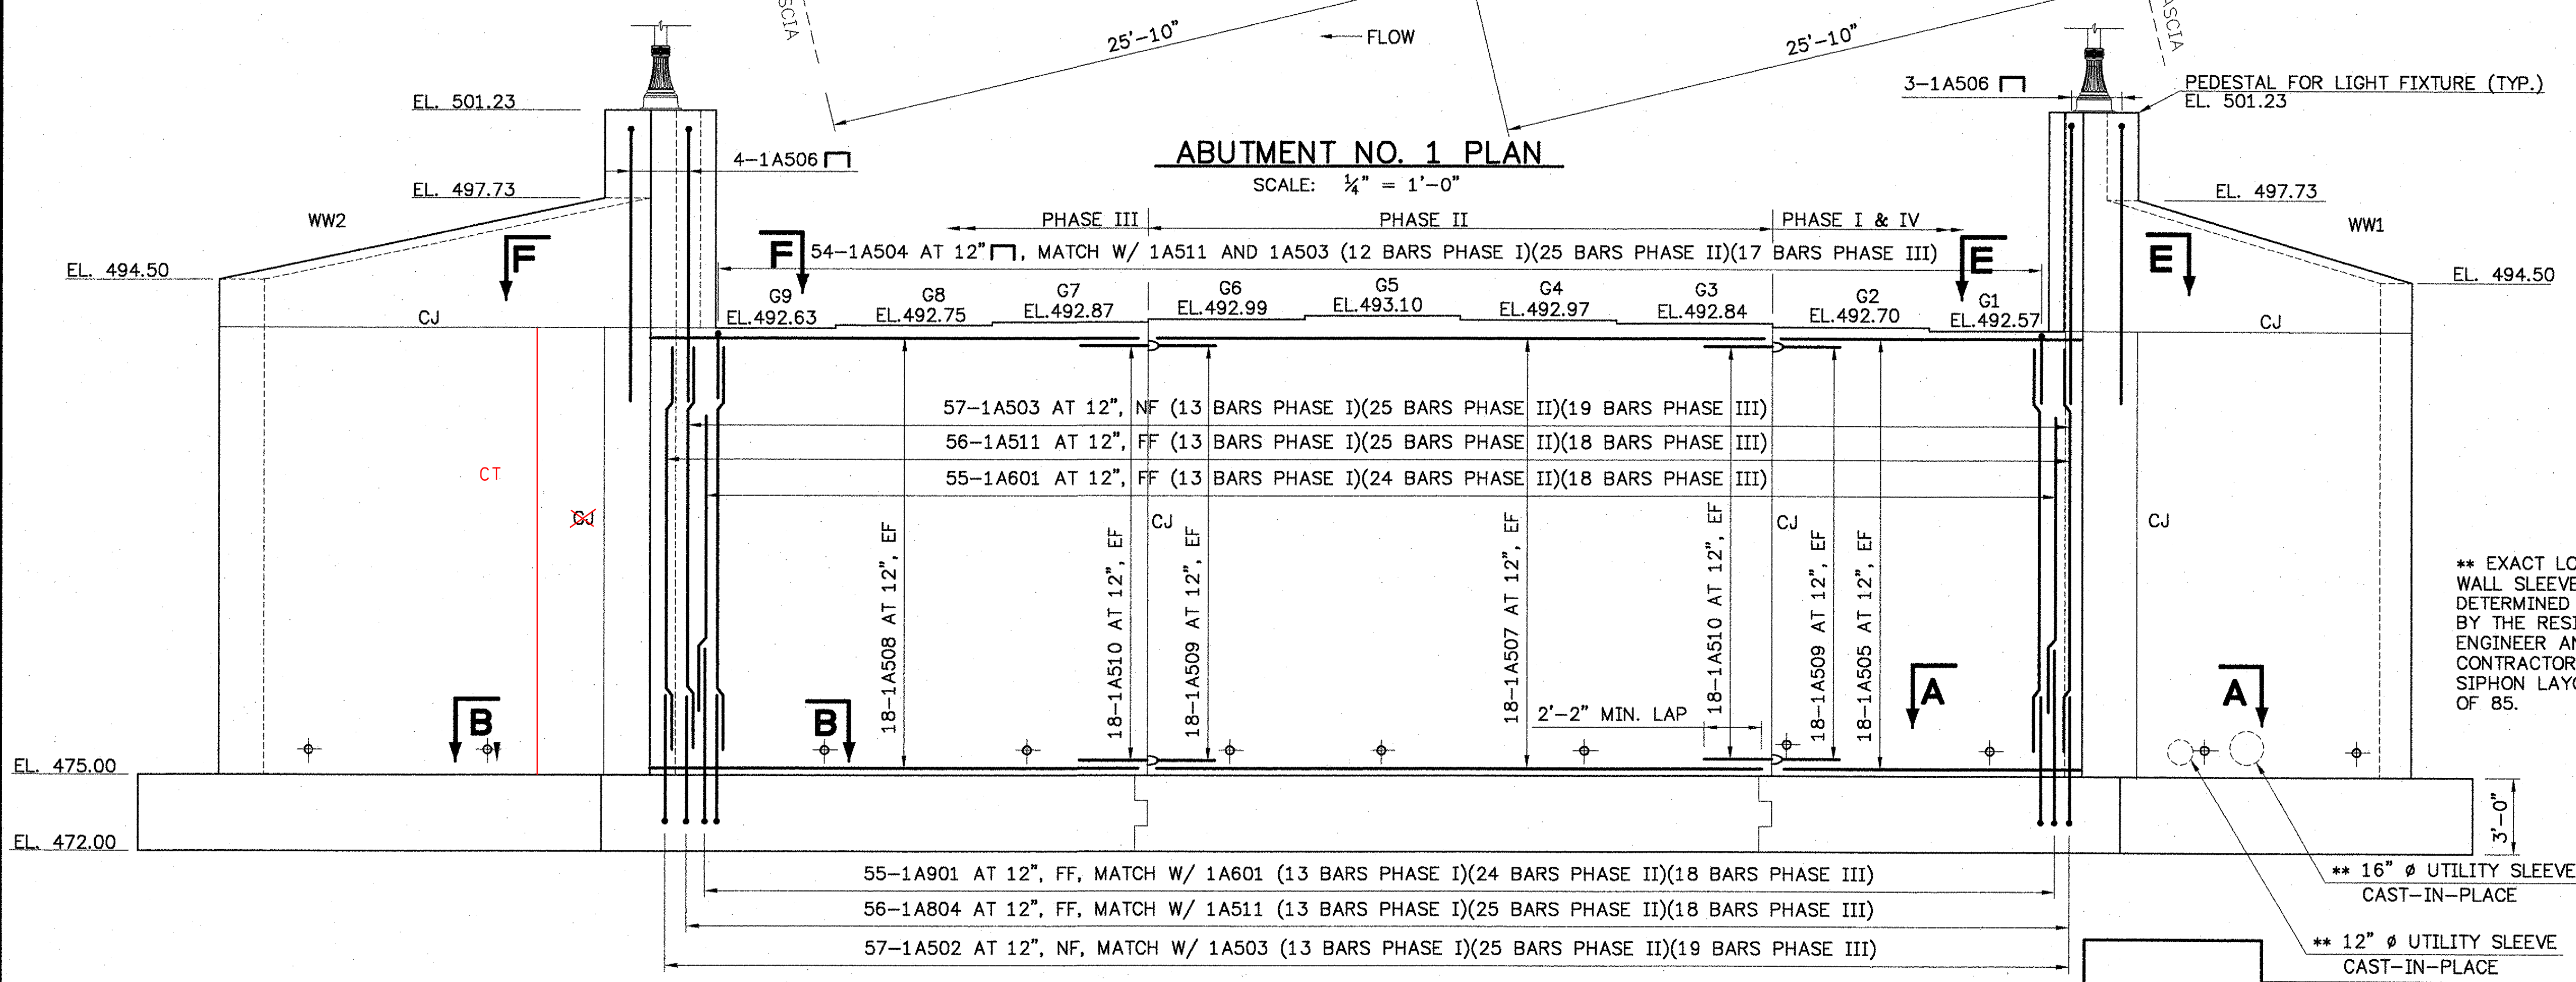

** EXACT LOCATION OF WALL SLEEVES TO BE DETERMINED IN THE FIELD BY THE RESIDENT ENGINEER AND THE CONTRACTOR. SEE SEWER SIPHON LAYOUT, SHEET 21 OF 85.

NOTE: SEE SHEET 65 OF 85 FOR DETAILS: A-A, B-B, E-E, F-F

ABUTMENT NO. 1 ELEVATION
 SCALE: 1/4" = 1'-0"

ABUTMENT TYPICAL SECTION
 SCALE: 1/4" = 1'-0"

STATE OF VERMONT	
AGENCY OF TRANSPORTATION	
Town Of	JOHNSON
Highway No.	VT. ROUTE 15
VT. ROUTE 15 OVER GIHON RIVER	
ABUTMENT NO. 1 DETAILS	
Designed By	R. RICARD
Checked By	B. WELCH/R. ROONEY 11/02
PROJECT	JOHNSON
I.G.C. Info.	Bridge Sheet No.
Bridge No.	37
Log Sta.	
Surv. Sta.	
Drawn By	D. DUGAL
Bridge Design Supervisor	J. BYATT Date 11/06
PROJECT NO.	BRF 030-2(17)S
Sheet 62 Of 85	

CONSULTING ENGINEERS

540 Commercial Street - Manchester, NH 03101
 (603) 668-8223 - Fax: (603) 668-8802
 cld@cldeengineers.com - www.cldeengineers.com
 Maine - New Hampshire - Vermont

31296ABUT.DWG