


PLAN VIEW

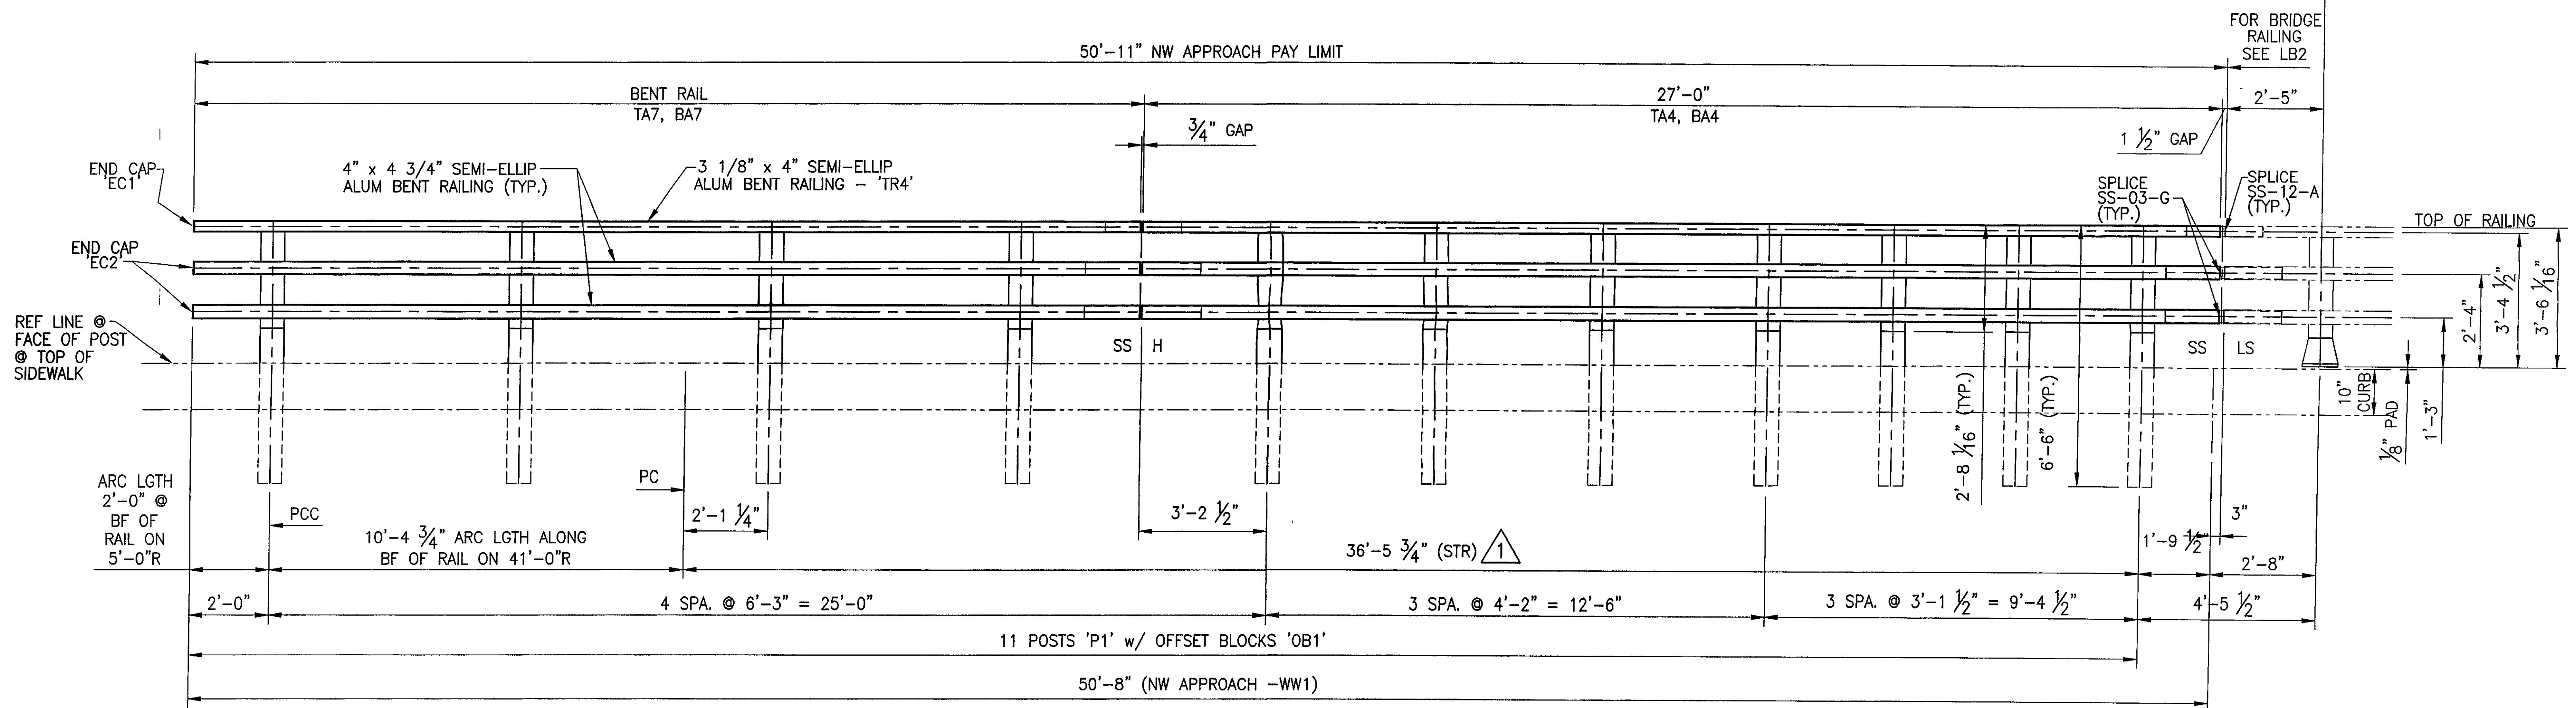

INSIDE ELEVATION OF NW APPROACH RAIL

- NOTE:
- RAIL LENGTHS DO NOT INCLUDE END CAPS AND/OR GAPS.
 - LENGTH OF APPROACH RAILING ON THIS SHEET IS 50.91 LF PAY LENGTH.
 - FOR KEY PLAN SEE LB6A

H = HOLE SIDE
 SS = SHORT SLOTTED SIDE
 LS = LONG SLOTTED SIDE

RECEIVED
 CND BY CLD OK'D BY GAS
 AUG 03 2007
 RESUBMIT APPROVED
 BY KMH DATE 8/13/07

BRIDGE No. 37
 PROJECT No. BRF 030-2(17)S
 ITEM No: 621.74

APPROVED: _____
 REC'D APPROVAL _____
 DRAWING _____

L.B. FOSTER COMPANY
 1016 GREENTREE ROAD
 PITTSBURGH, PENNSYLVANIA 15220

FOR: E. R. LAFAYETTE, INCORPORATED
 VERMONT AGENCY OF TRANSPORTATION
 TOWN OF JOHNSON, COUNTY OF LAMOILLE
 BRIDGE RAILING FOR VT15 (MINOR ARTERIAL) OVER GHON RIVER
 3L ALUM BRIDGE APPROACH RAILING ~ ELEVATION VIEWS

MADE CMS DATE 05/23/07 JOB No. ARO395 CUST No. _____
 CHECK. BLJ DATE 05/31/07 DRAWING LB6 REV. No. ONE

| REV | DESCRIPTION | BY | DATE |
|-----|-----------------------------|-----|----------|
| 1 | REVISED PER APPROVAL MARKUP | CMS | 07 05 07 |

ANODIZED
 (SEE NOTES ON LB1)