



INSIDE ELEVATION OF NE APPROACH RAIL

NOTE:
 • RAIL LENGTHS DO NOT INCLUDE END CAPS AND/OR GAPS.
 • LENGTH OF APPROACH RAILING ON THIS SHEET IS 50.91 LF PAY LENGTH.

H = HOLE SIDE
 SS = SHORT SLOTTED SIDE
 LS = LONG SLOTTED SIDE

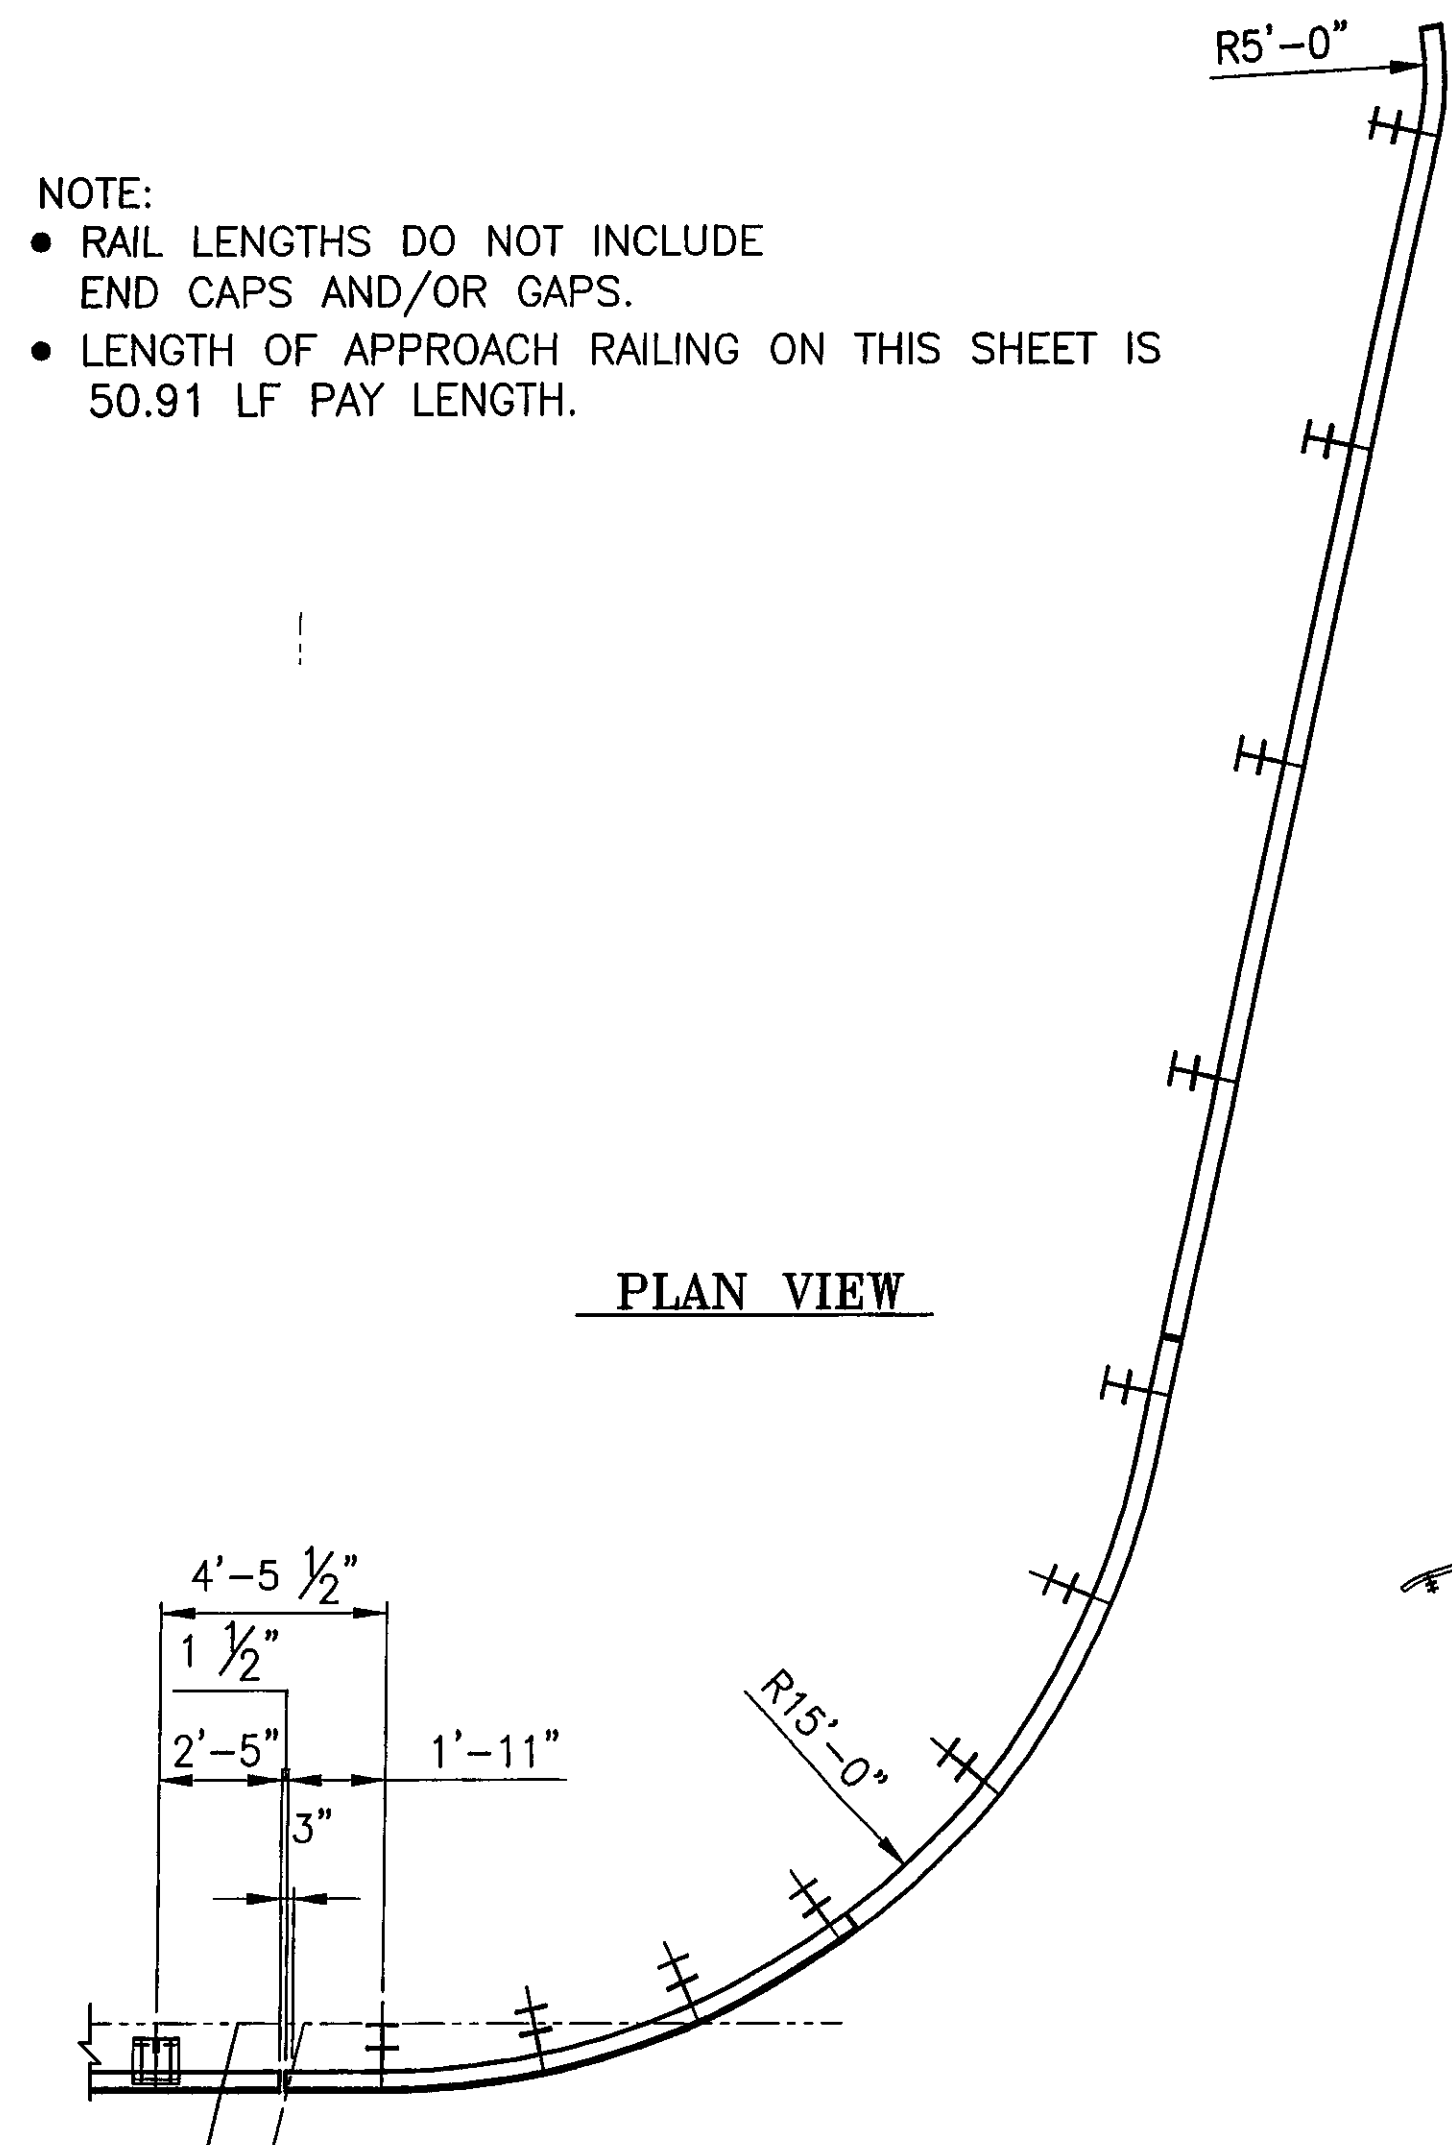

PLAN VIEW

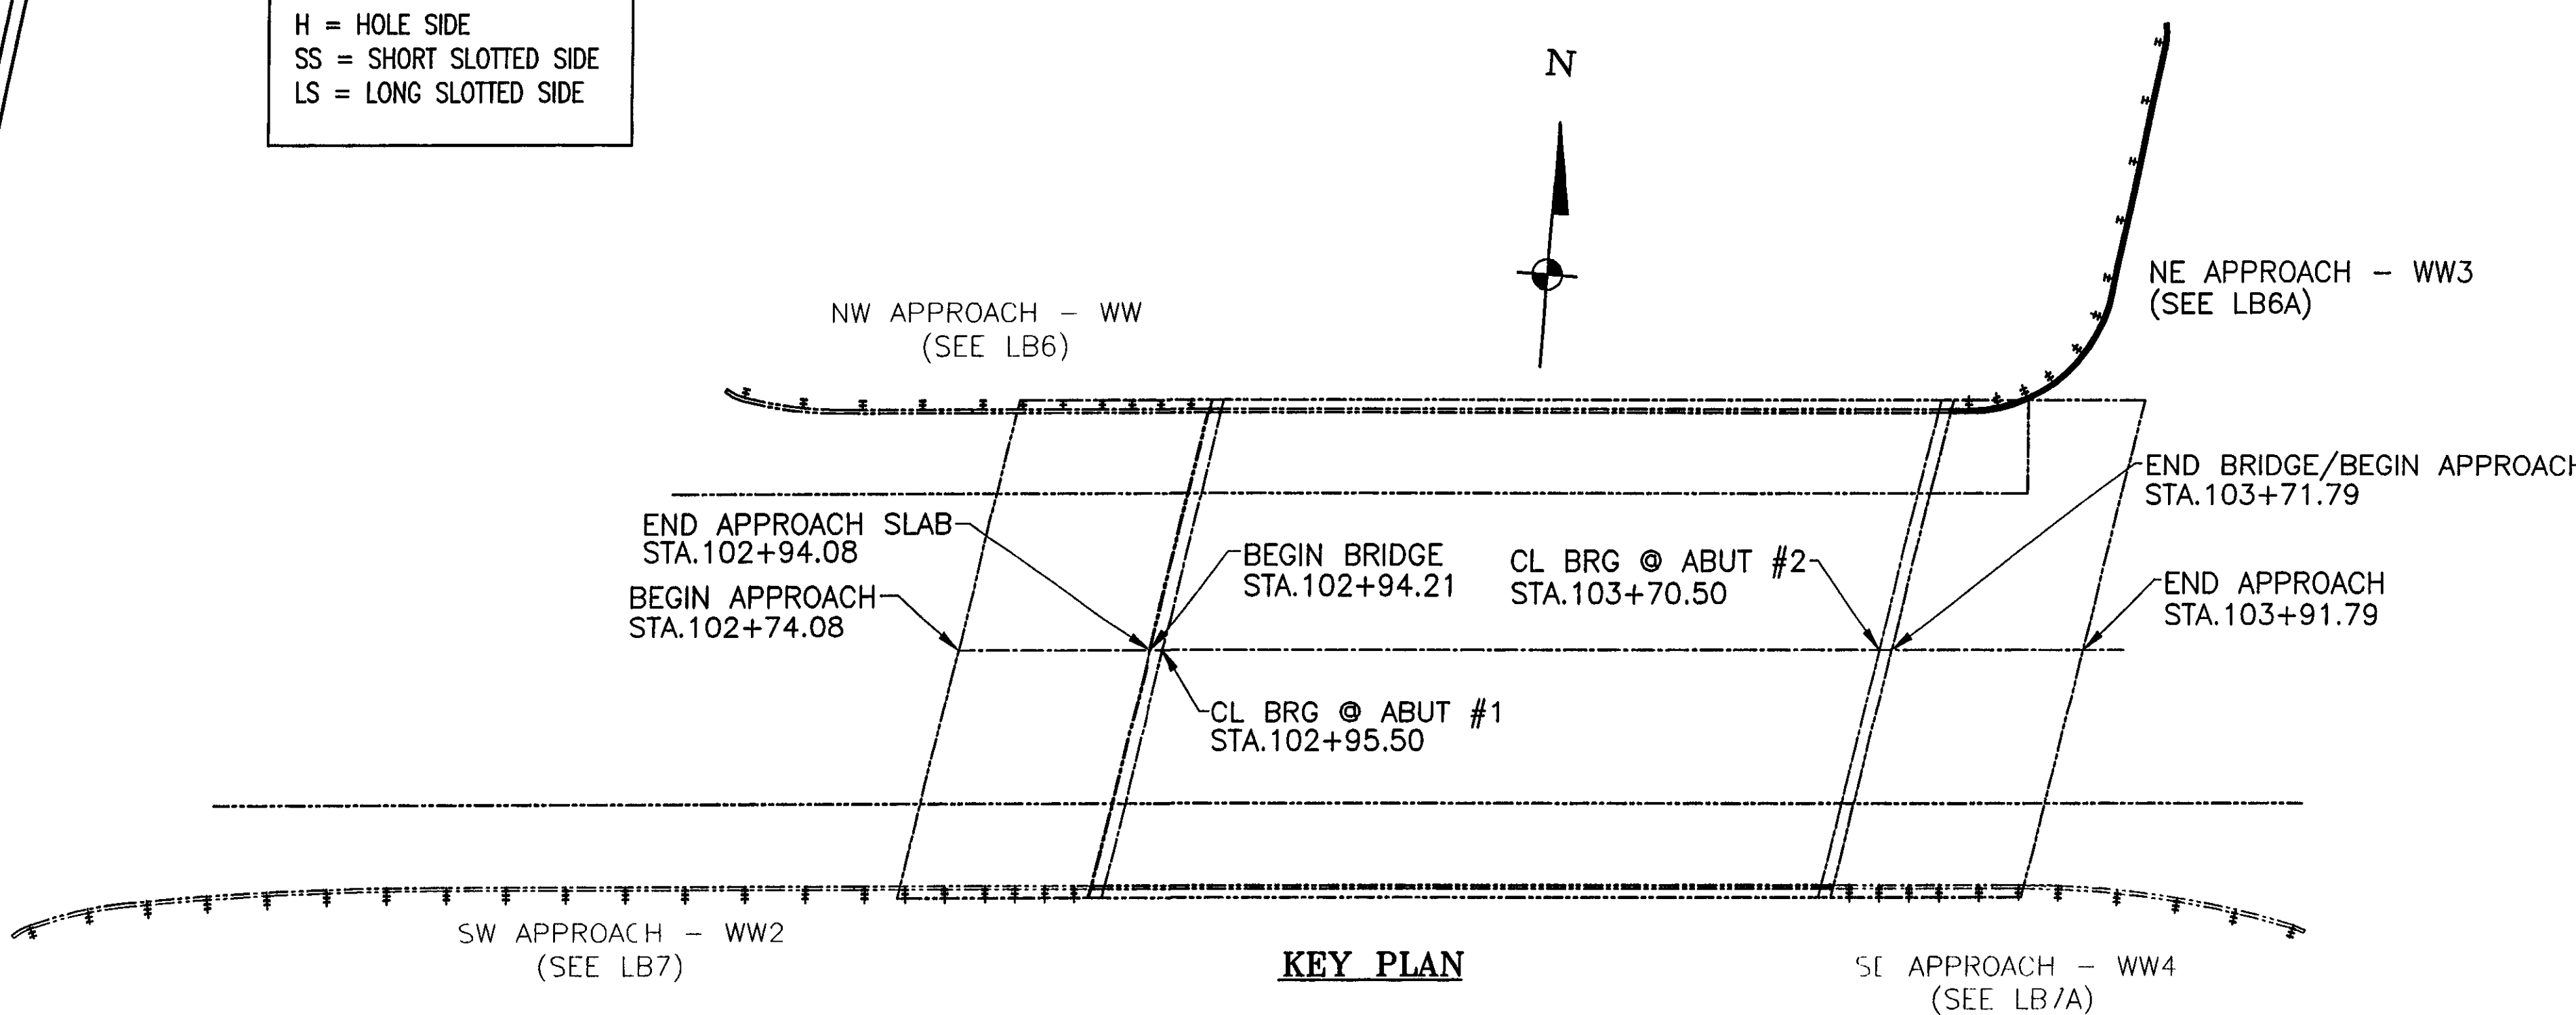

KEY PLAN

ANODIZED
 (SEE NOTES ON LB1)

BRIDGE No. 37
 PROJECT No. BRF 030-2(17)S
 ITEM No: 621.74

APPROVED: _____ REC'D APPROVAL _____
 DRAWING _____

L.B. FOSTER COMPANY
 1016 GREENTREE ROAD
 PITTSBURGH, PENNSYLVANIA 15220

FOR: E. R. LAFAYETTE, INCORPORATED
 VERMONT AGENCY OF TRANSPORTATION
 TOWN OF JOHNSON, COUNTY OF LAMOILLE
 BRIDGE RAILING FOR VT15 (MINOR ARTERIAL) OVER GHON RIVER
 3L ALUM BRIDGE APPROACH RAILING ~ ELEVATION VIEWS

RECEIVED
 CKD BY CLD OKD BY GAS
 AUG 03 2007
 RESUBMIT APPROVED AS NOTED
 BY KMH DATE 8/13/07

REV	DESCRIPTION	BY	DATE
1	REVISED PER APPROVAL MARKUP	CMS	07/24/07

MADE CMS DATE 05/23/07 JOB No ARO395 CUST No
 CHECK BLJ DATE 05/31/07 DRAWING LB6A REV. No. ONE