


- NOTE:
- RAIL LENGTHS DO NOT INCLUDE END CAPS AND/OR GAPS
 - LENGTH OF APPROACH RAILING ON THIS SHEET IS 113.42 LF PAY LENGTH.
 - FOR KEY PLAN SEE LB7A

H = HOLE SIDE
 SS = SHORT SLOTTED SIDE
 LS = LONG SLOTTED SIDE

RECEIVED
 OK'D BY CLD OK'D BY GAS
 AUG 03 2007
 RESUBMIT APPROVED ✓
 BY KMH DATE 8/15/07

ANODIZED
 (SEE NOTES ON LB1)

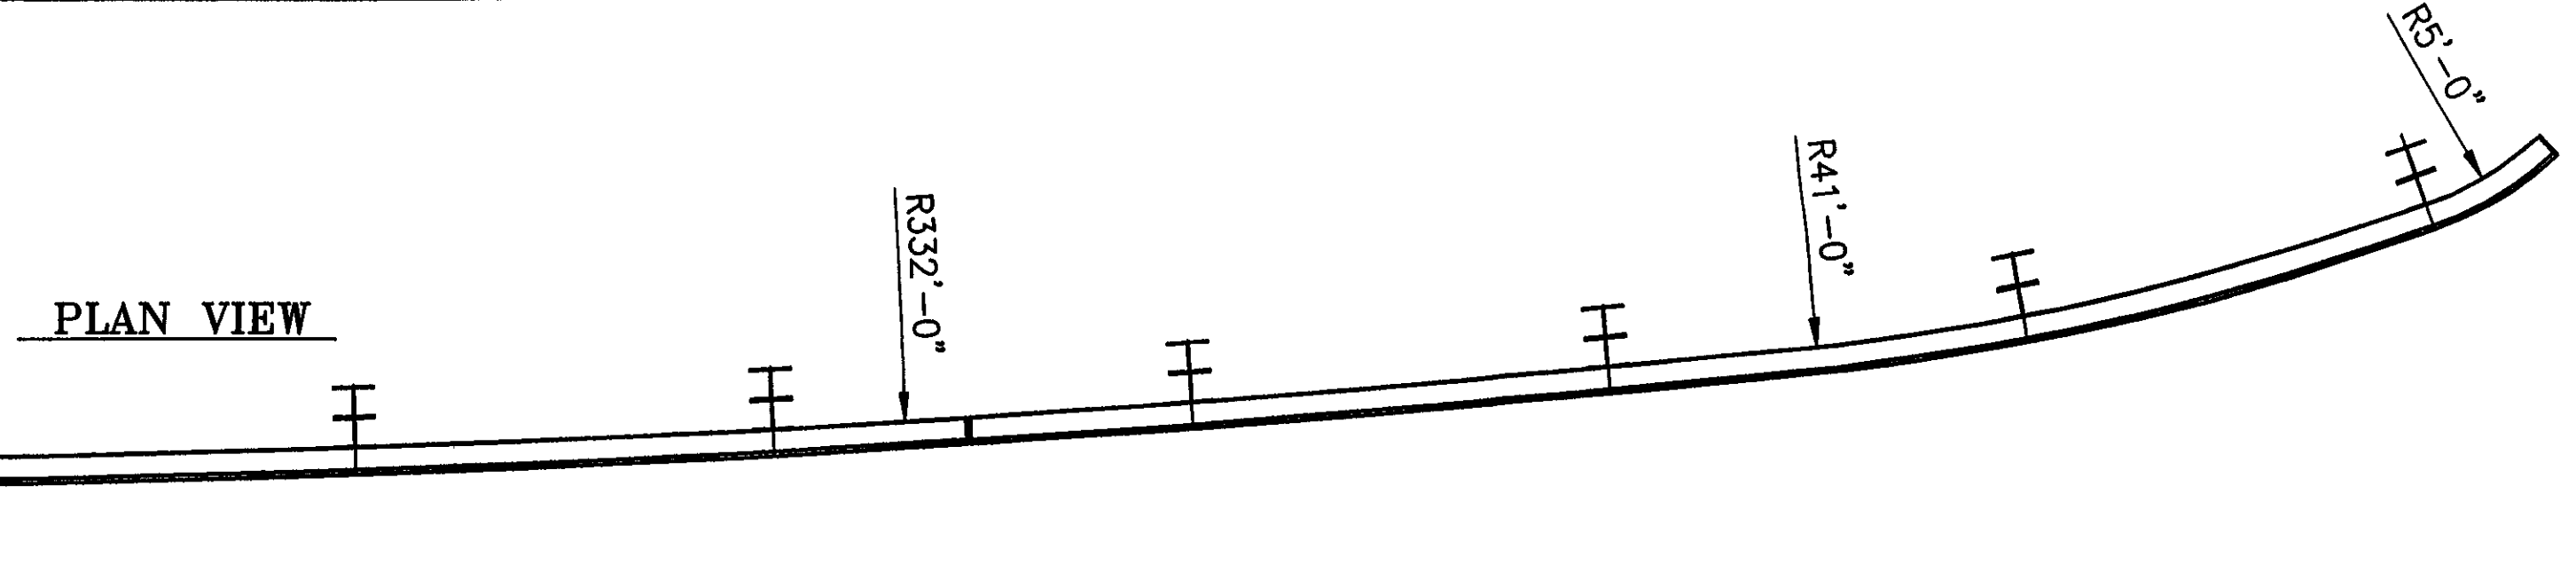

INSIDE ELEVATION OF SW APPROACH RAIL

BRIDGE No. 37
 PROJECT No. BRF 030-2(17)S
 ITEM No: 621.74

APPROVED: _____ REC'D APPROVAL _____
 DRAWING _____

L.B. FOSTER COMPANY
 1016 GREENTREE ROAD
 PITTSBURGH, PENNSYLVANIA 15220

FOR: F. R. LAFAYETTE, INCORPORATED
 VERMONT AGENCY OF TRANSPORTATION
 TOWN OF JOHNSON, COUNTY OF LAMOILLE
 BRIDGE RAILING FOR VT15 (MINOR ARTERIAL) OVER GHON RIVER
 3L ALUM BRIDGE APPROACH RAILING ~ ELEVATION VIEWS

MADE CMS DATE 05/23/07 JOB No ARO395 CUST No
 CHECK BLJ DATE 05/31/07 DRAWING LB7 REV. No.

REV	DESCRIPTION	BY	DATE