



# VT103 PROFILE

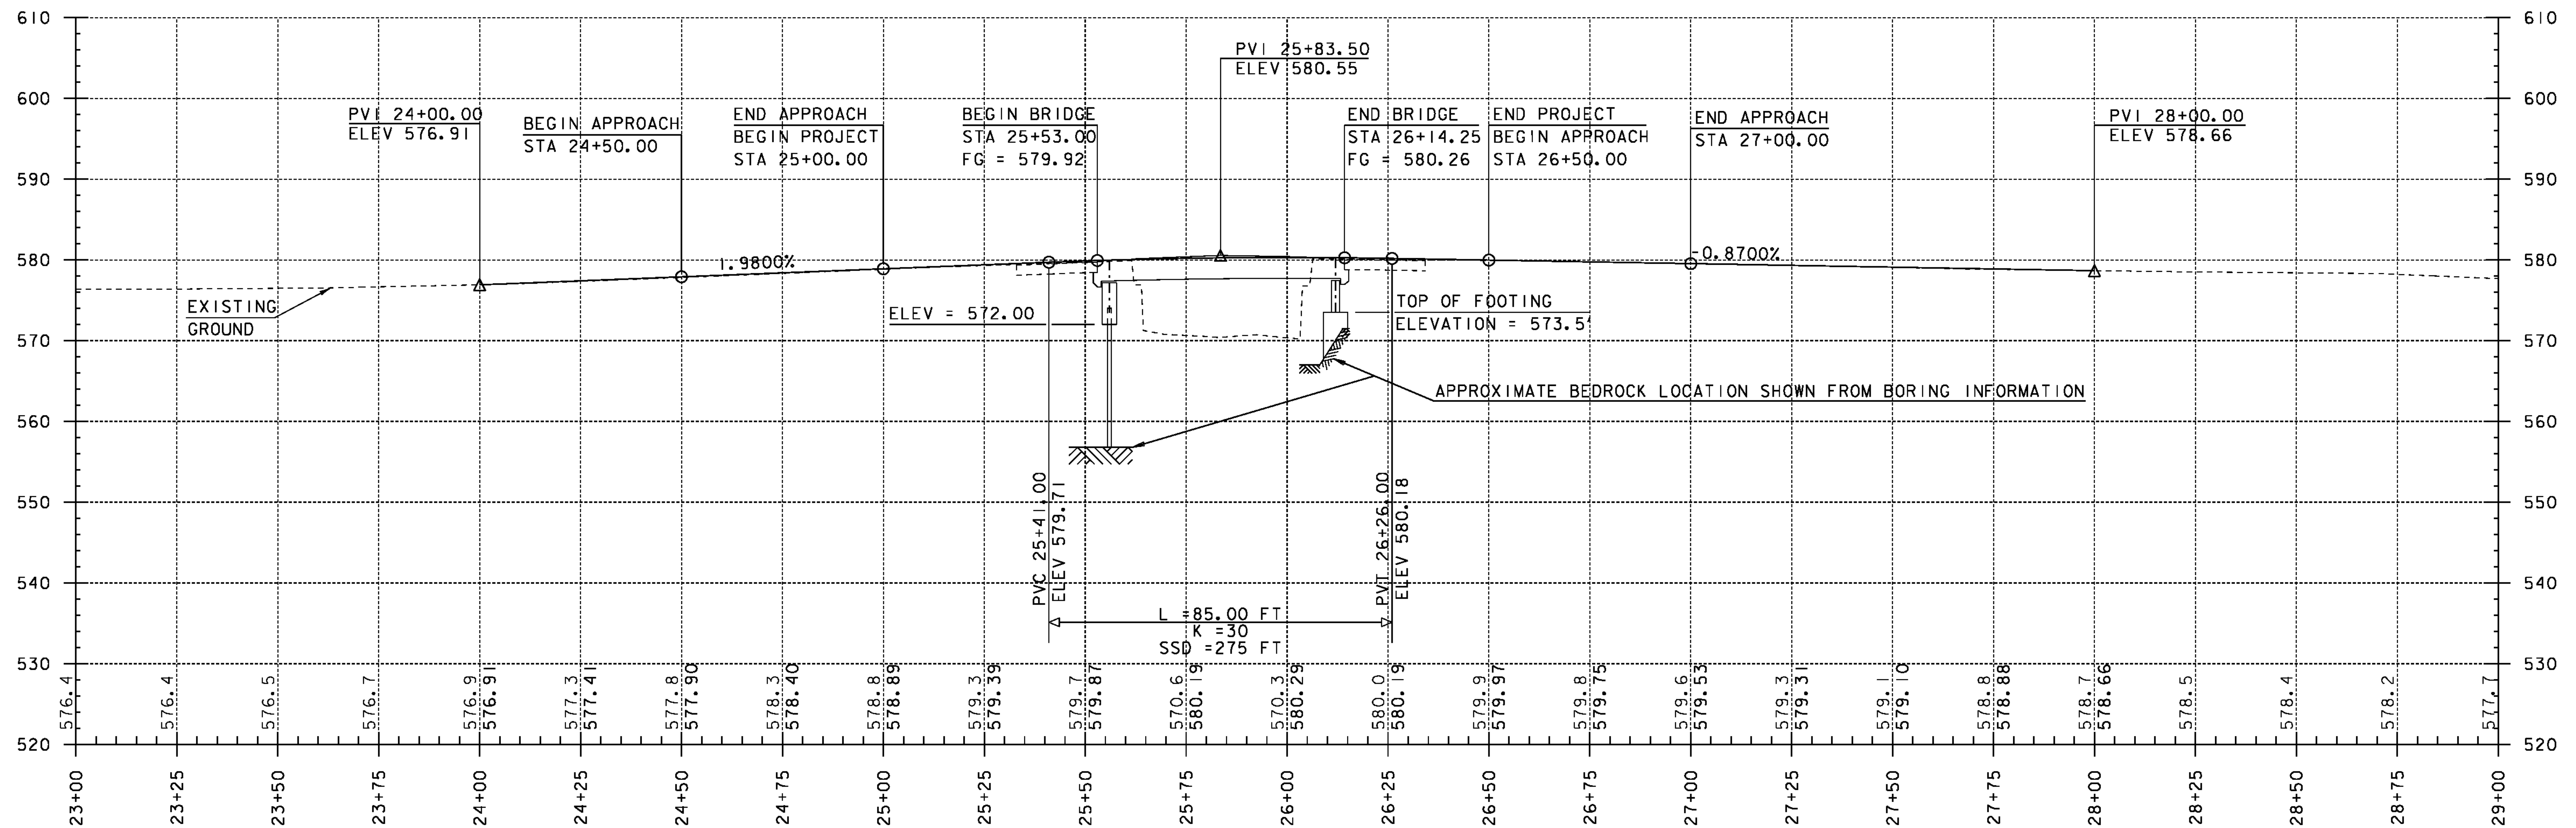

NOTES:


GRADES SHOWN TO THE NEAREST TENTH ARE EXISTING GROUND ALONG  $\mathcal{C}$ .

GRADES SHOWN TO THE NEAREST HUNDREDTH ARE FINISH GRADE ALONG  $\mathcal{C}$ .

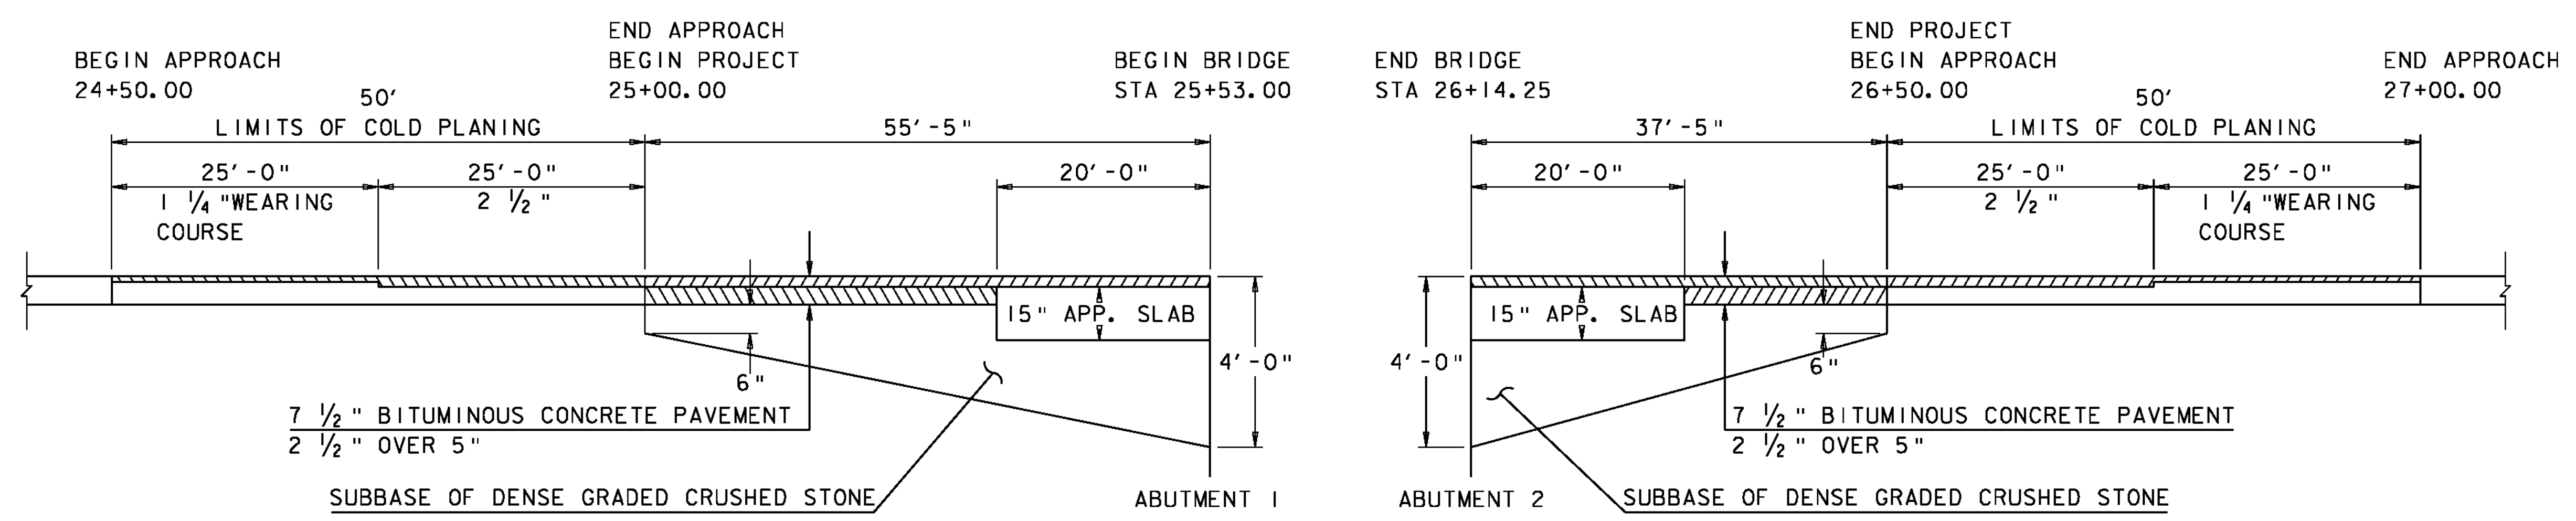

**BEGIN PROJECT MATERIAL TRANSITION**  
NOT TO SCALE

**END PROJECT MATERIAL TRANSITION**  
NOT TO SCALE

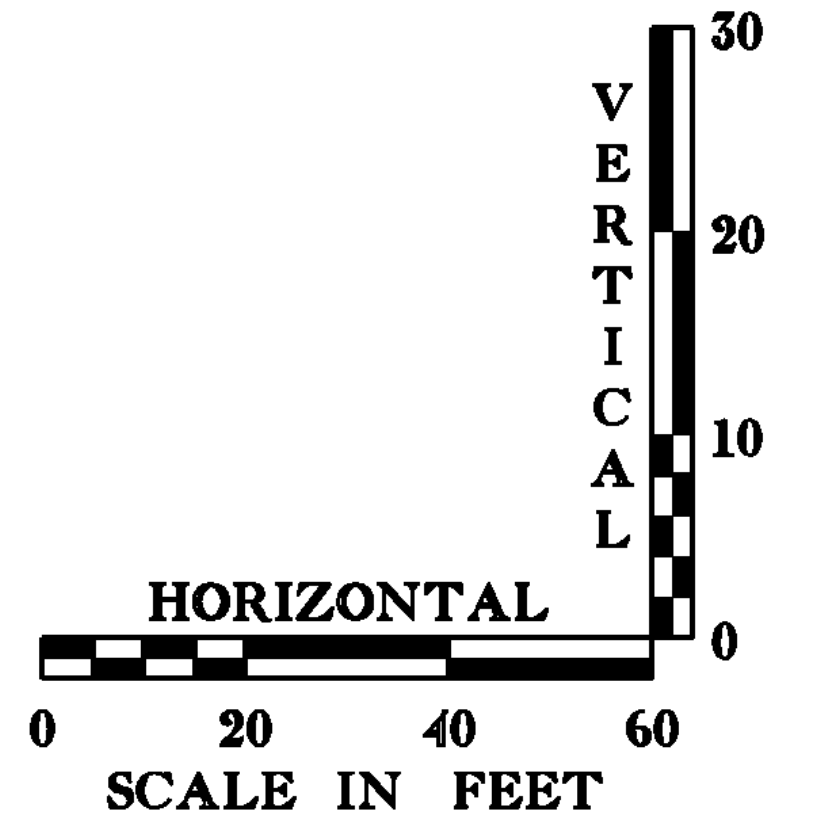

PROJECT NAME: CHESTER	PLOT DATE: 20-SEP-2010
PROJECT NUMBER: BRF 025-1(28)	DRAWN BY: M.FESSEL
FILE NAME: 84e061/Str/s84e061pro.dgn	CHECKED BY: R.S.YOUNG
PROJECT LEADER: C.P.WILLIAMS	BRIDGE 8 PROFILE SHEET
DESIGNED BY: R.S.YOUNG	SHEET 19 OF 124