
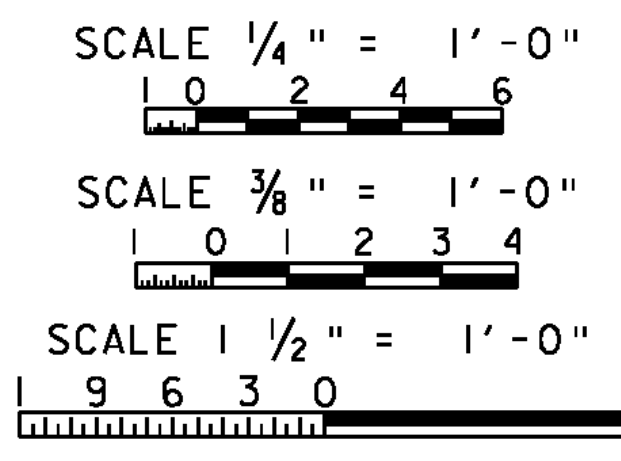
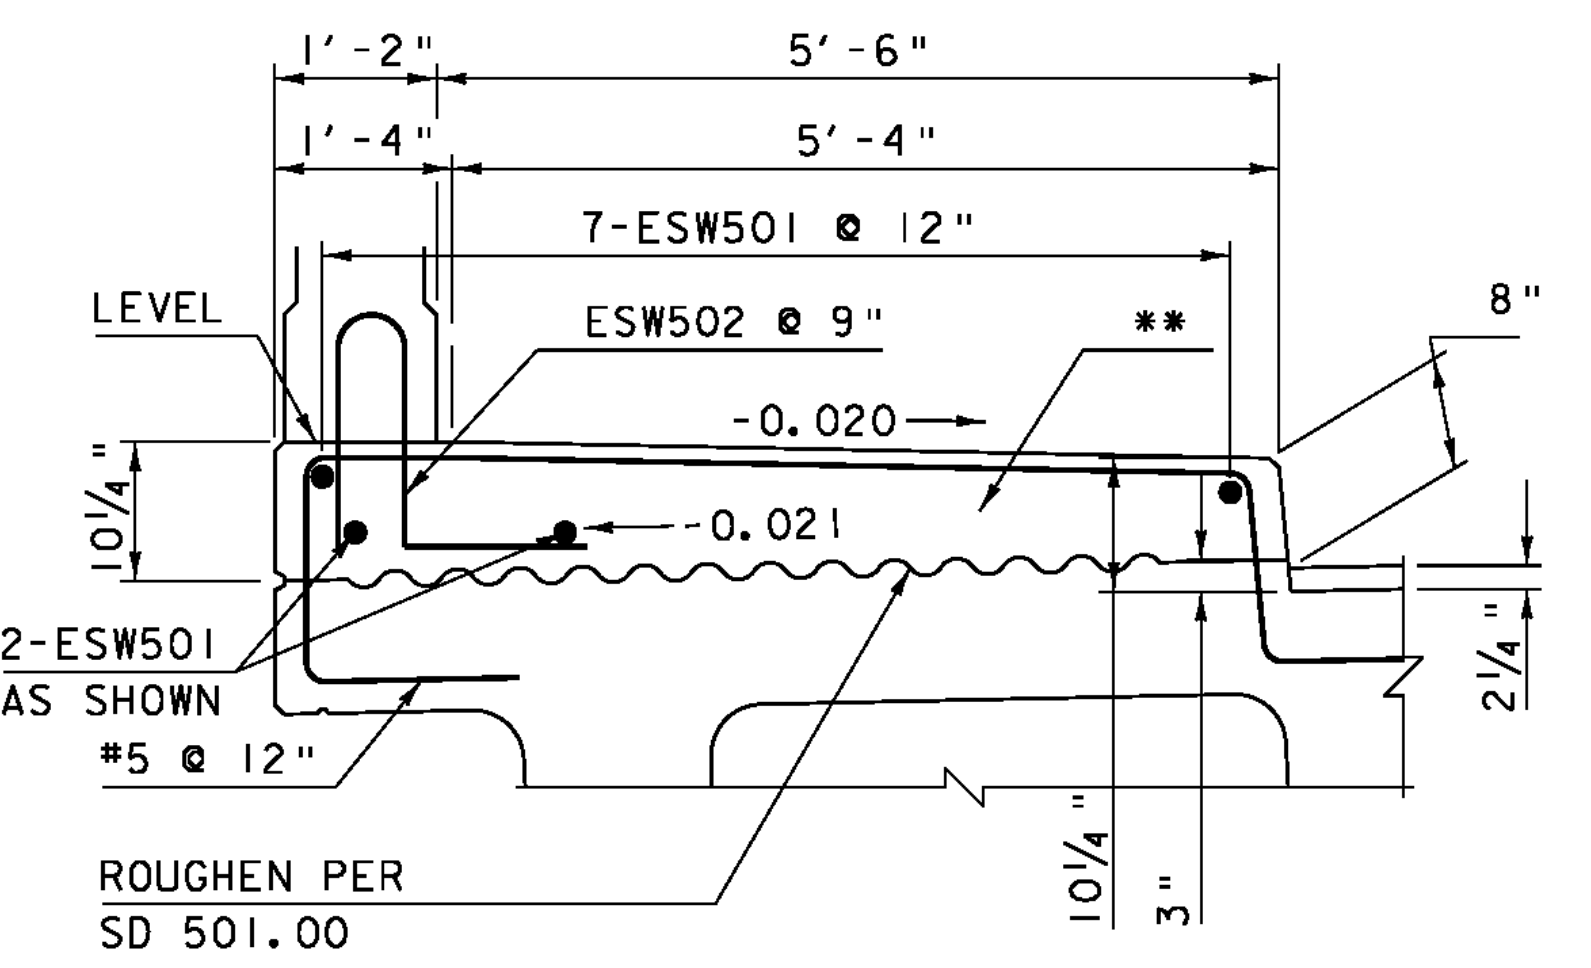


**FLANGE CONNECTION DETAILS**  
SCALE  $\frac{1}{2}'' = 1'-0''$

\*TWO #5 BARS SHALL BE PLACED AS SHOWN ALONG ENTIRE LENGTH OF JOINT. PAYMENT SHALL BE INCIDENTAL TO SPECIAL PROVISION (PRESTRESSED CONCRETE, NEXT D BEAMS) (NEXT 28 D).

\*\*SPECIAL PROVISION (HIGH PERFORMANCE CONCRETE, CLASS A LOW CEMENT)

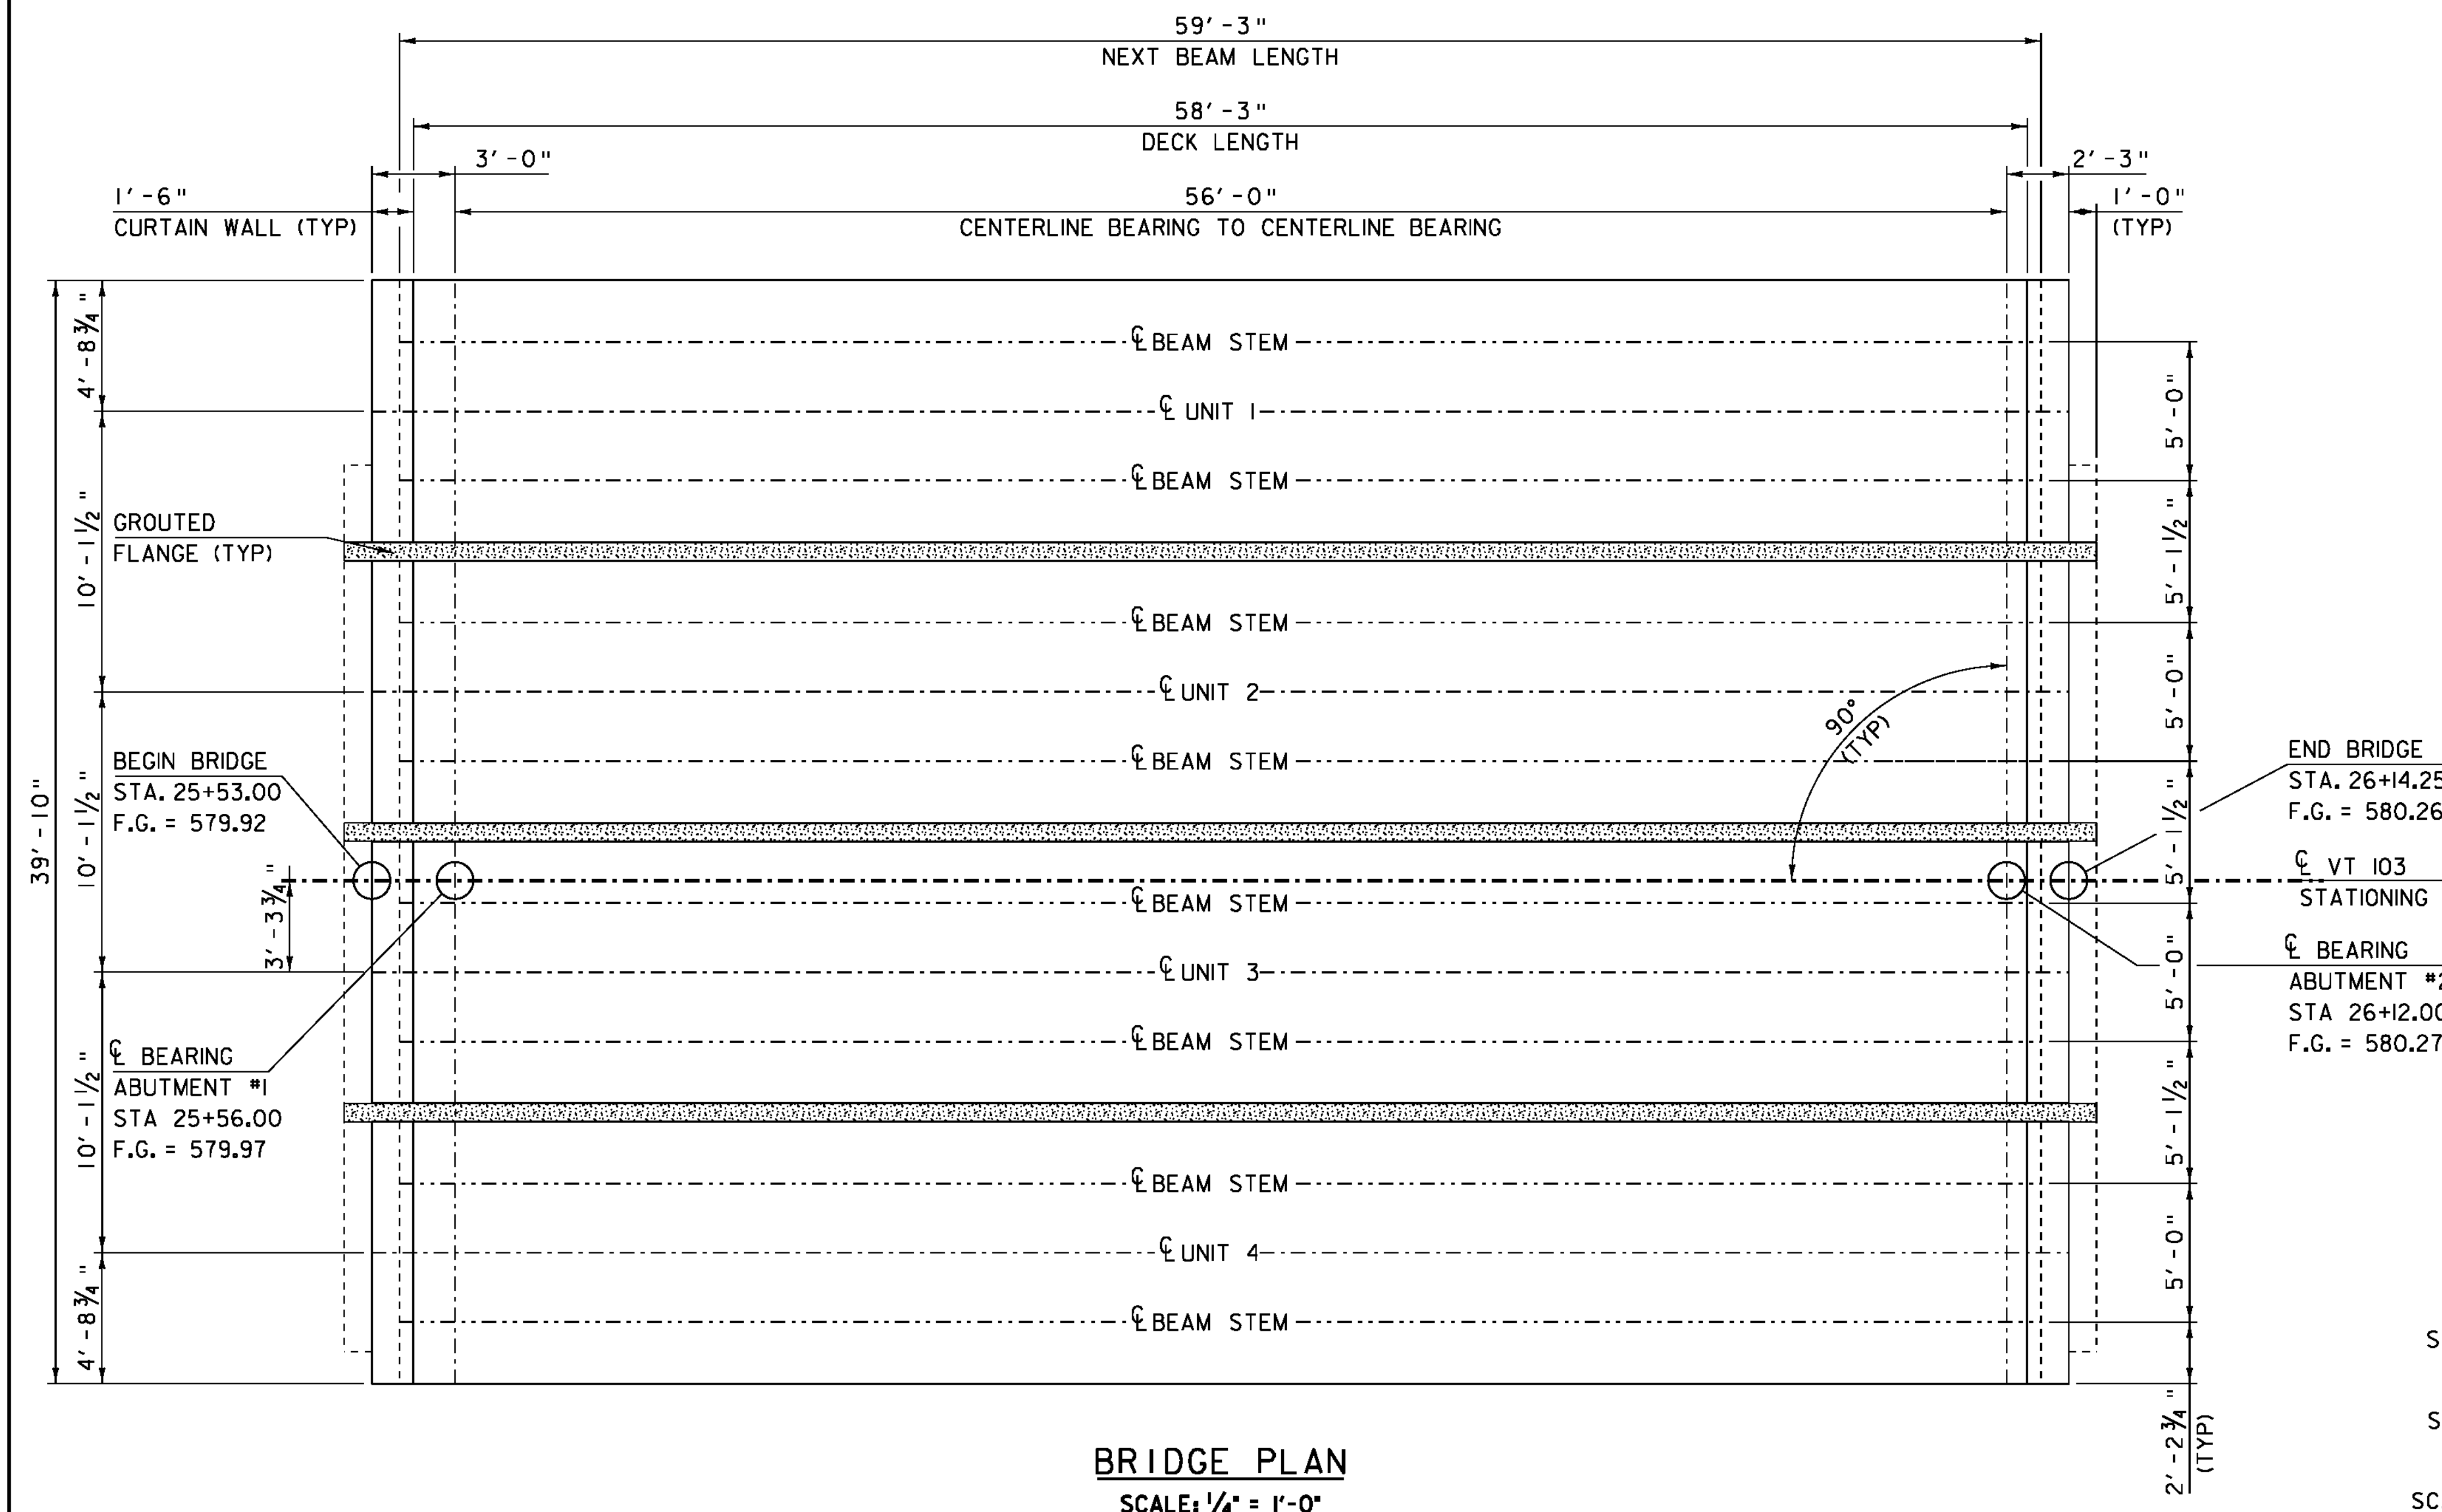

PROJECT NAME: CHESTER  
PROJECT NUMBER: BRF 025-1(28)

FILE NAME: 84e061/Str/84e061sup.dgn PLOT DATE: 20-SEP-2010  
PROJECT LEADER: C.P.WILLIAMS DRAWN BY: M.FESSEL  
DESIGNED BY: R.S.YOUNG CHECKED BY: R.S.YOUNG  
BRIDGE 8 FRAMING PLAN SHEET 28 OF 124